


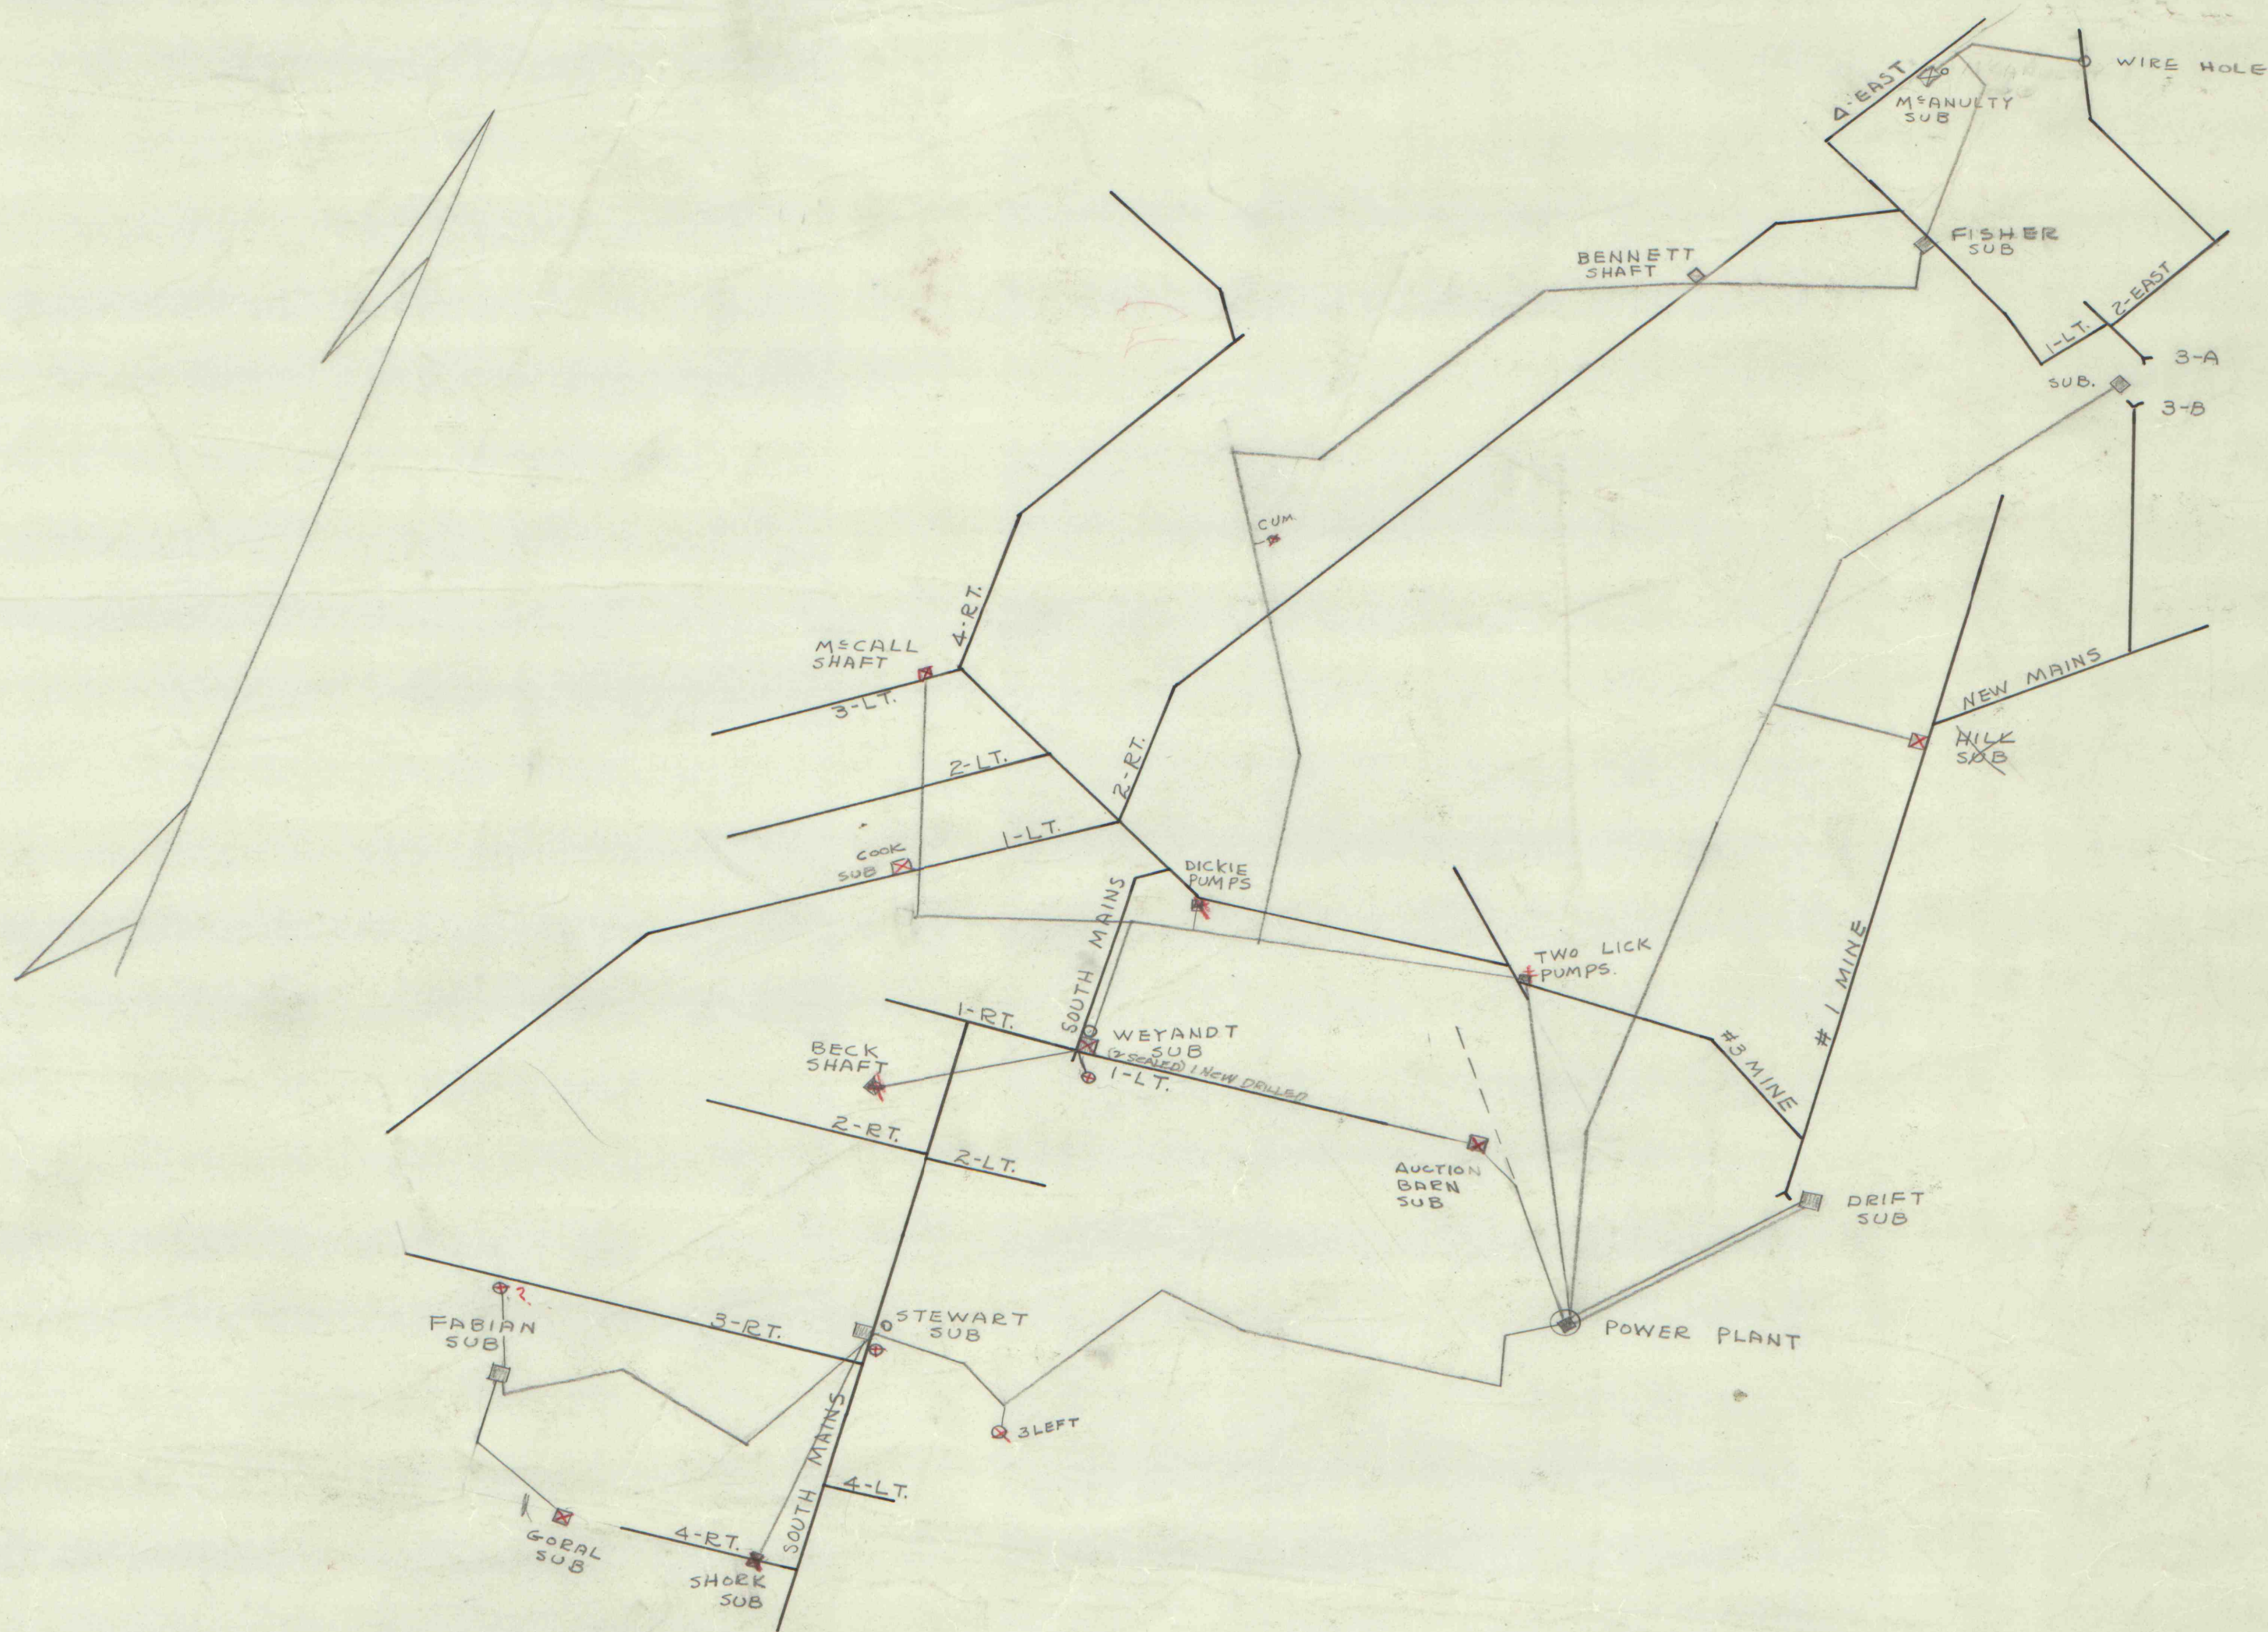

☒ BOREHOLE
SEALED

DATE REVISED	TYPE INSTALLATION		ROCHESTER & PITTSBURGH COAL CO. ENGINEERING DEPT. IND. & PA.
	ADDED	REMOVED	
	FINDLEY SUB.	2-1-65 NEW DRILLED WEYANDT (2 HOLES SEALED)	SCHEMATIC MAP SHOWING HEADING 5 & G.G. K.V. TRANS- MISSION LINES ON SURFACE. LUC-3 SCALE - Refer map key. TRACED BY 5-20-60..... CHECKED BY NO. 9422-67
	GORAL	HILL 10-1-65	
	AUCTION BARN	AUCTION 10-1-65	
		GORAL 10-1-65	
		COOK 10-1-65	
		CUMMINS -	