


397ms
5364

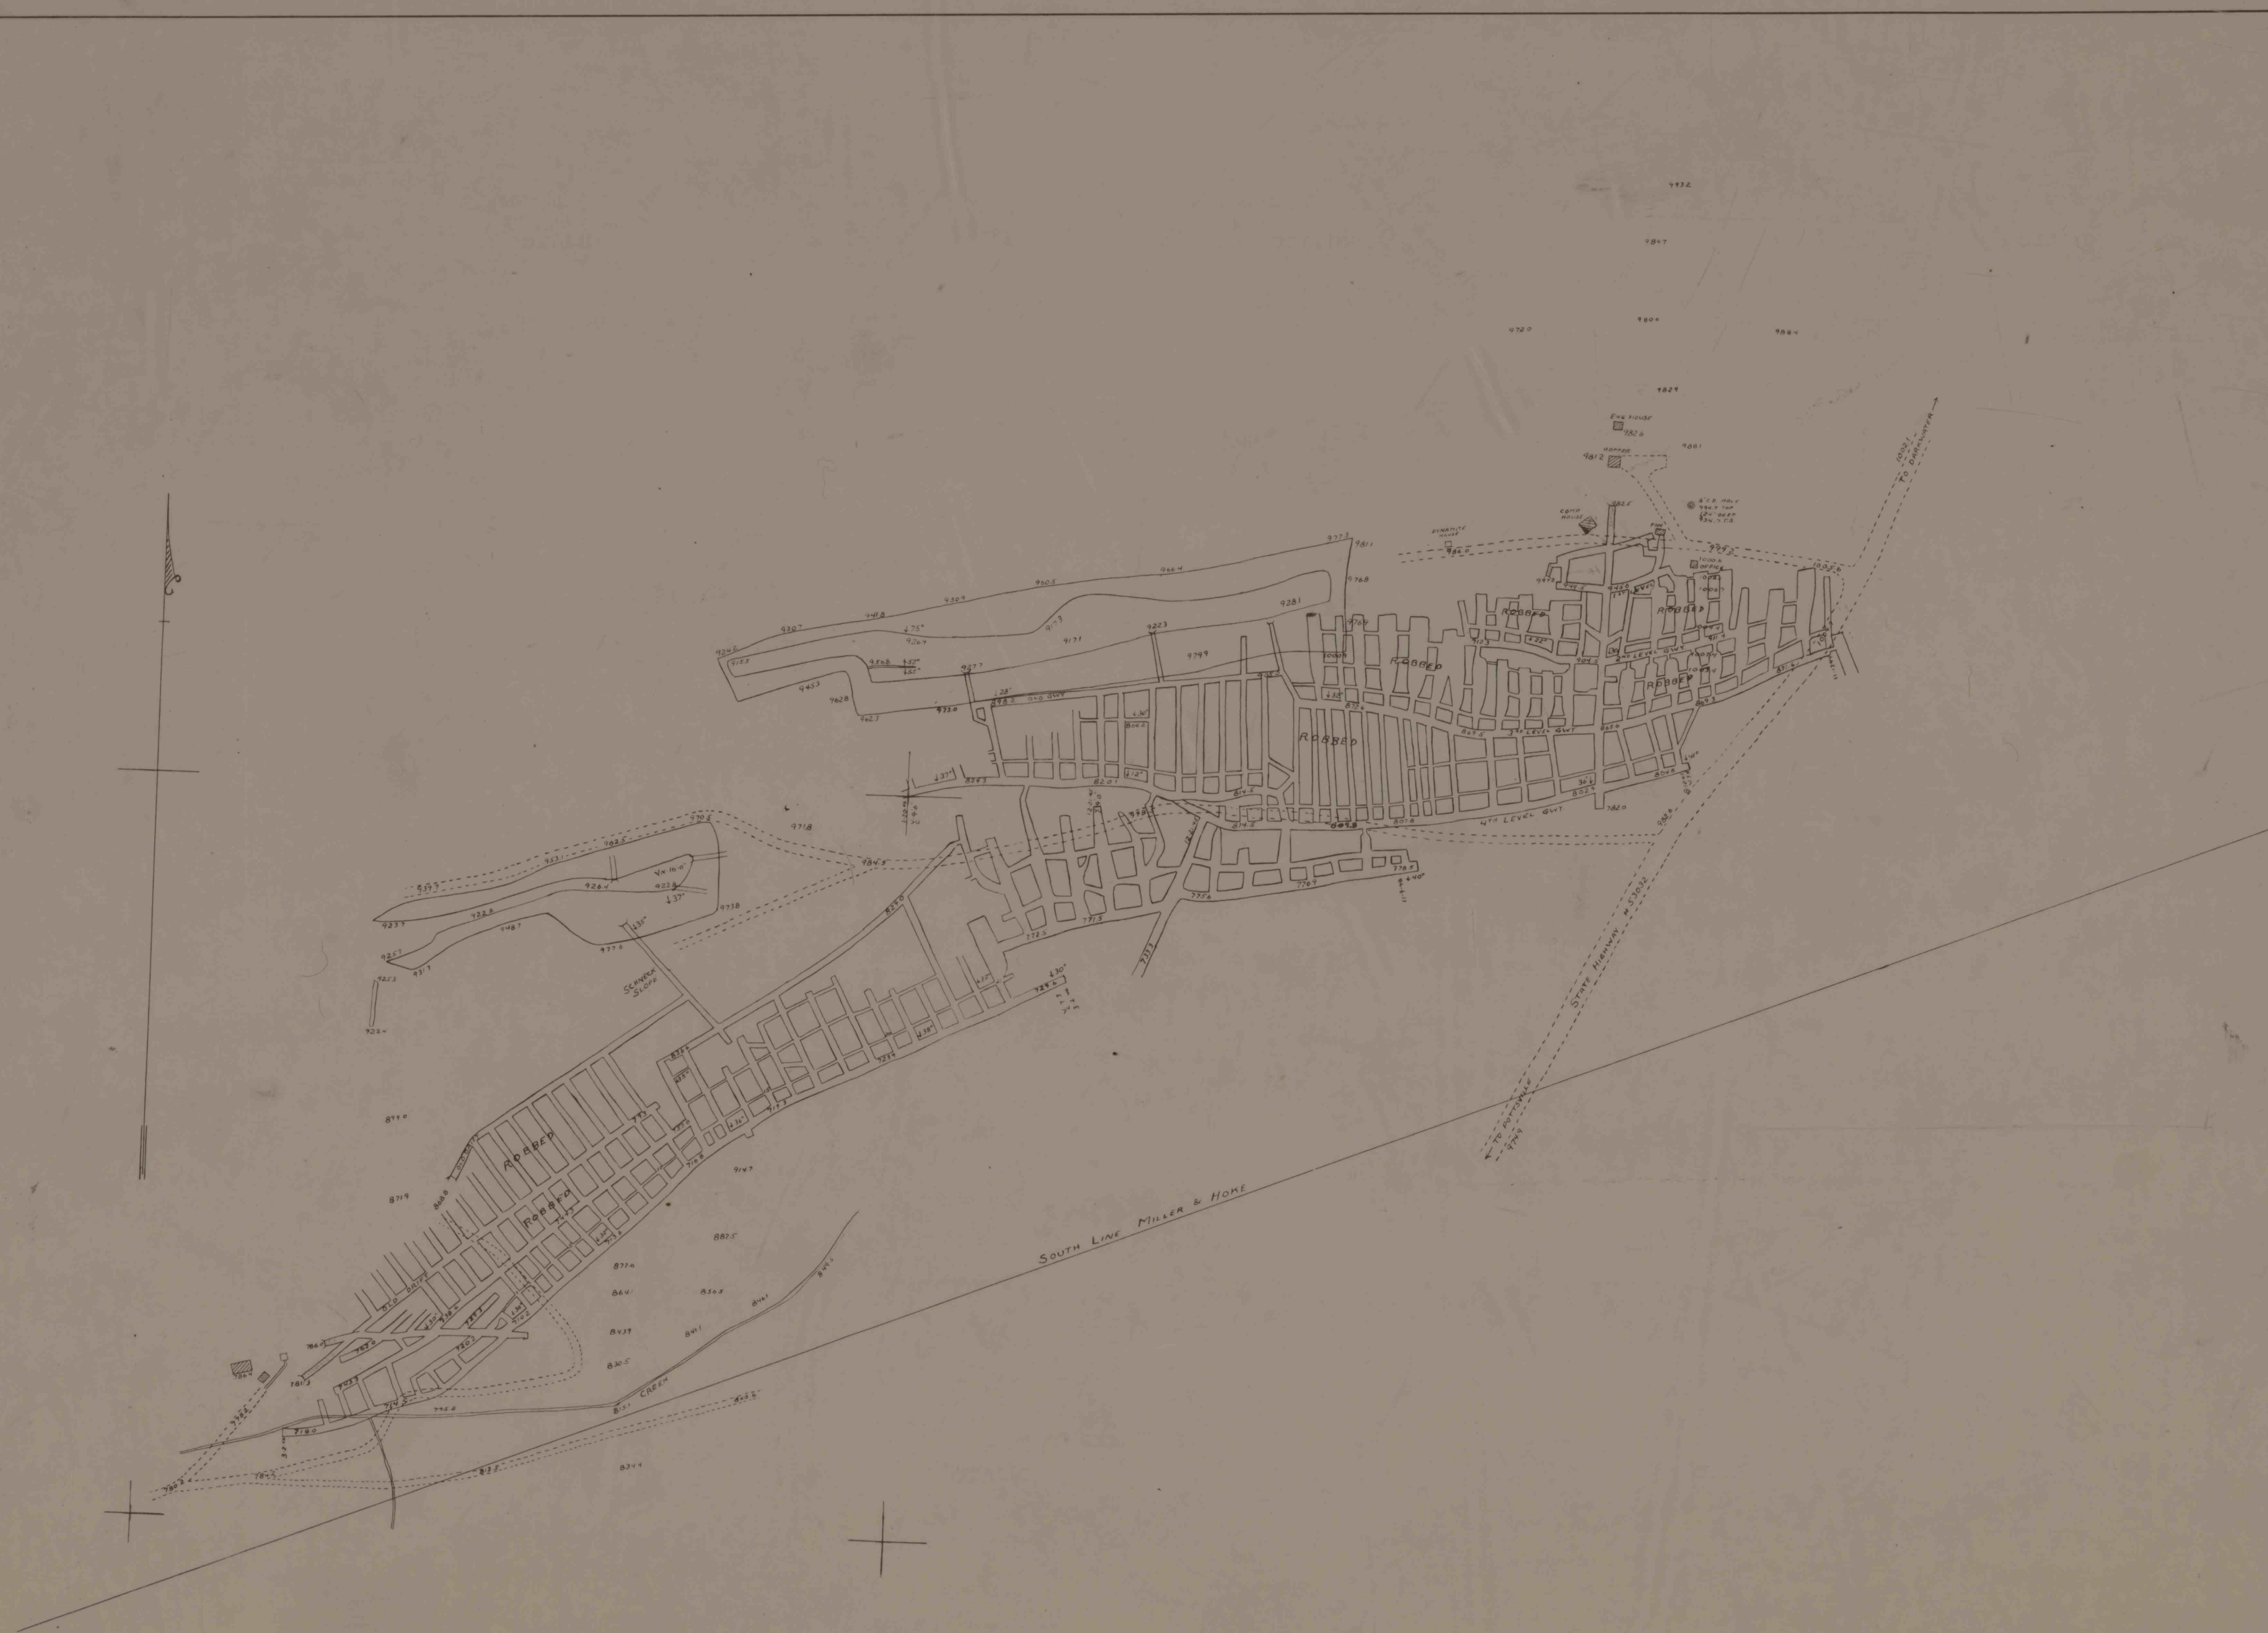

NORWEGIAN TOWNSHIP
SCHU. CO. PA.
CLINTON VEIN

SCALE 1"=100FT.

CLINTON VN.