




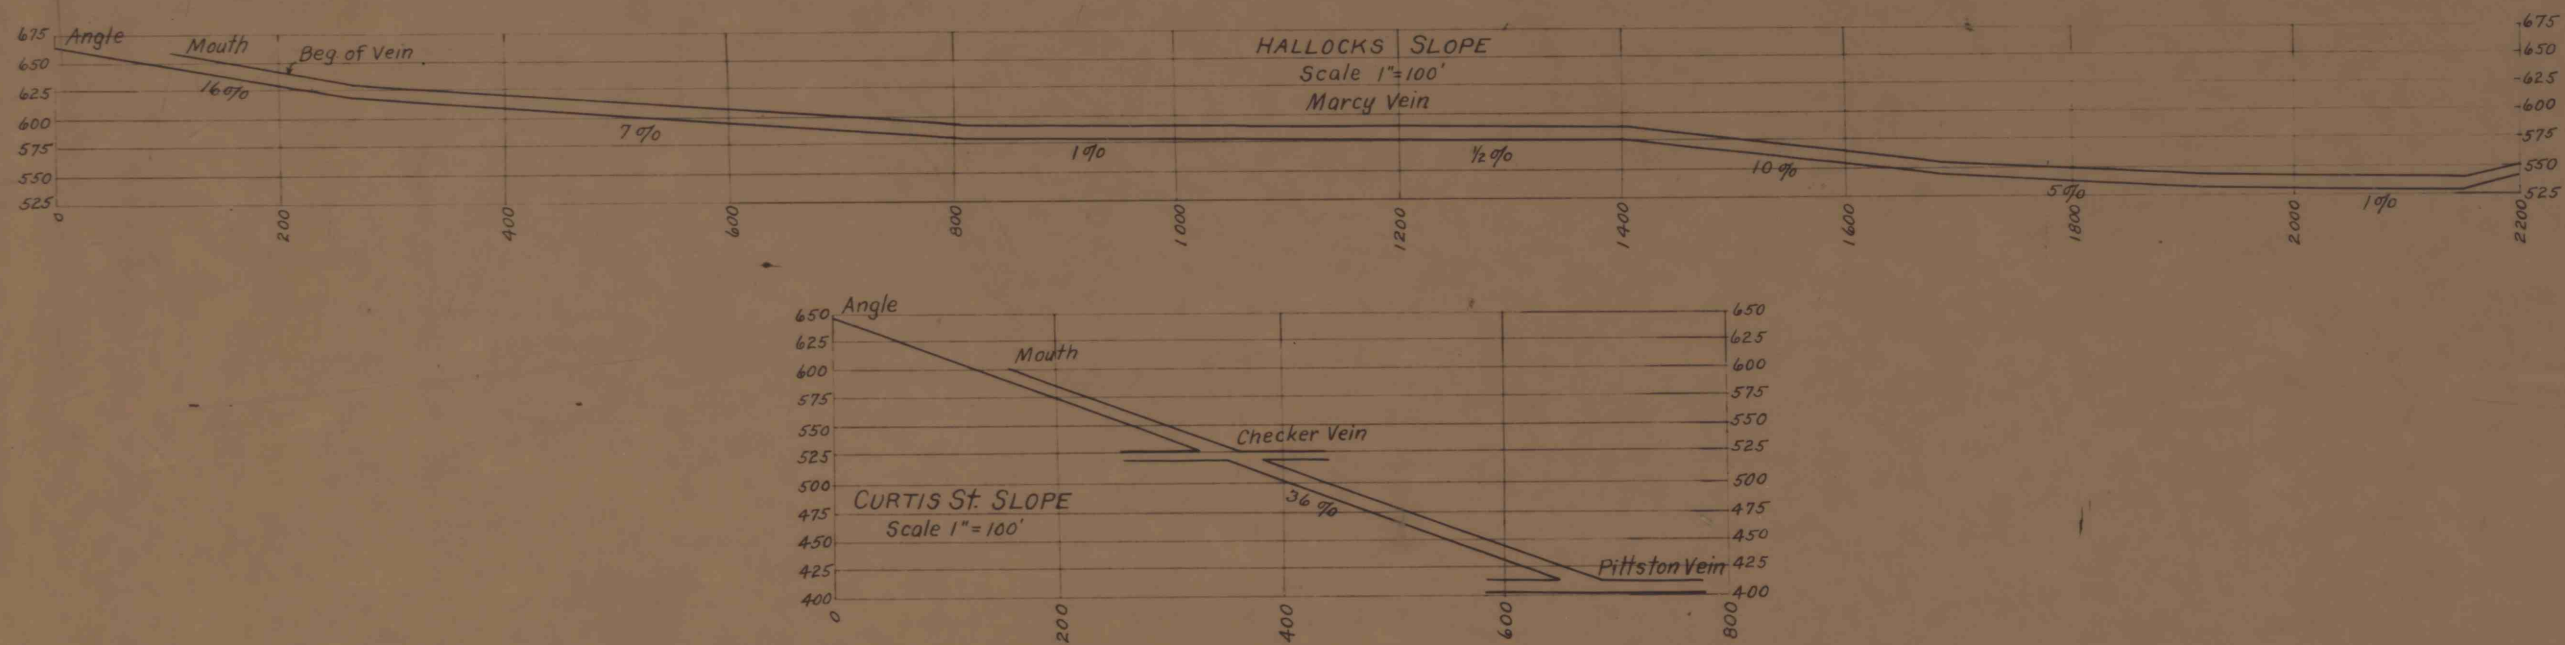


BARNUM NO. 2 SHAFT
Elev. 733.48

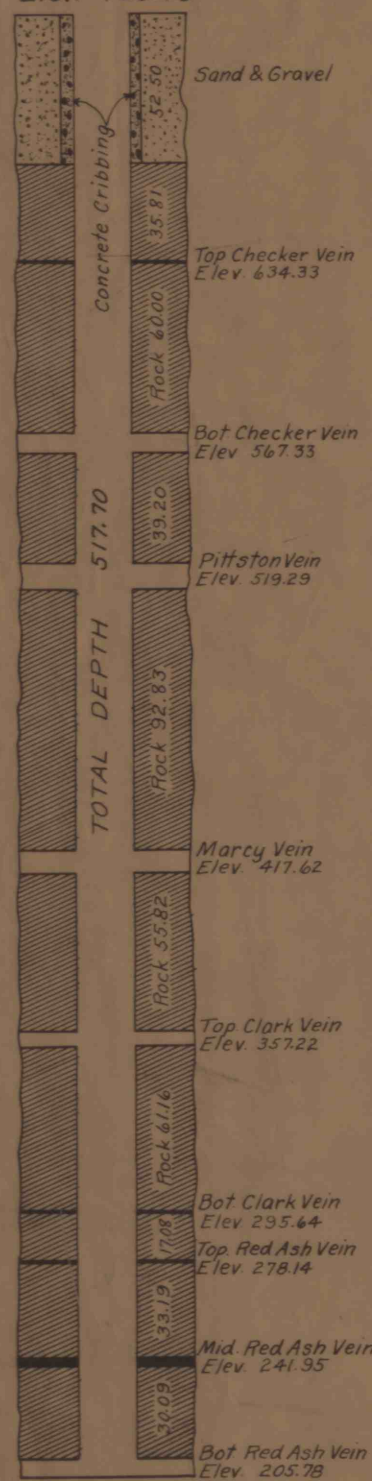


BARNUM NO. 1 SHAFT
Elev. 636.36

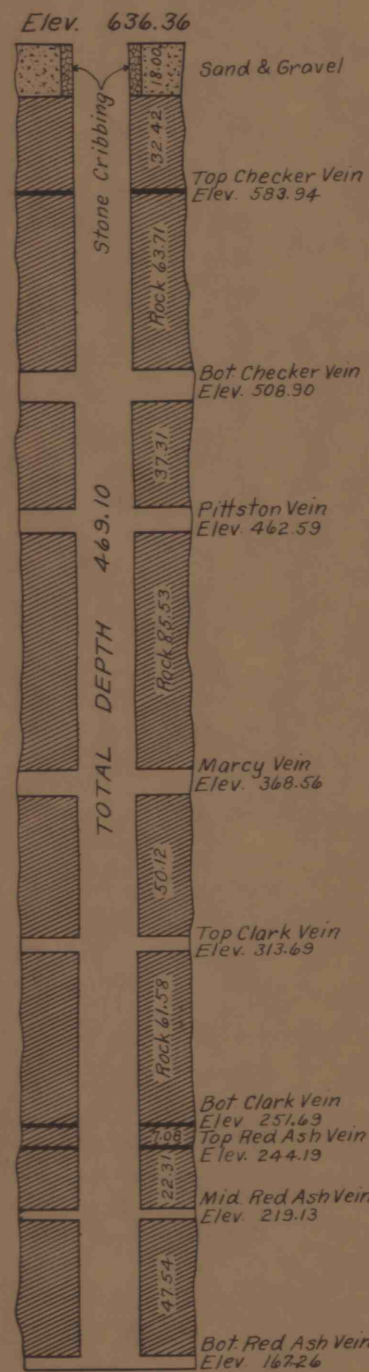


NO. 9 SHAFT
Elev. 662.20

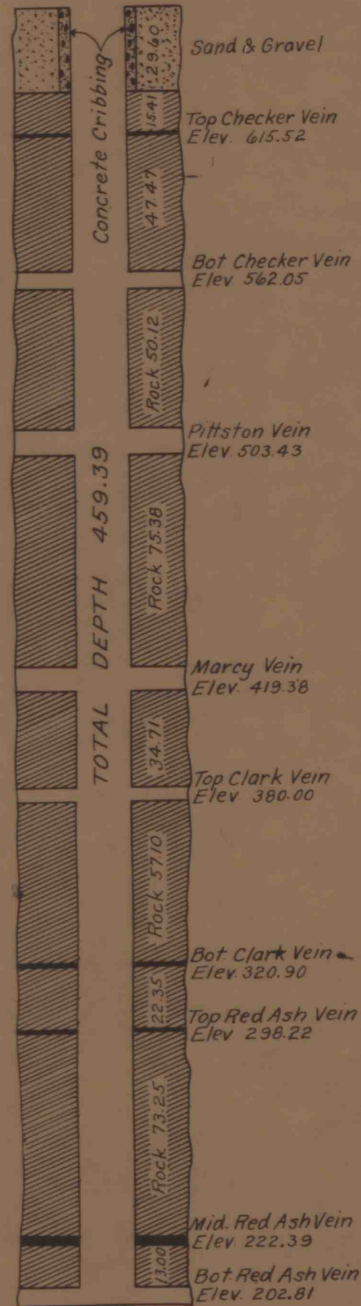


LEADVILLE SHAFT
Elev. 638.75

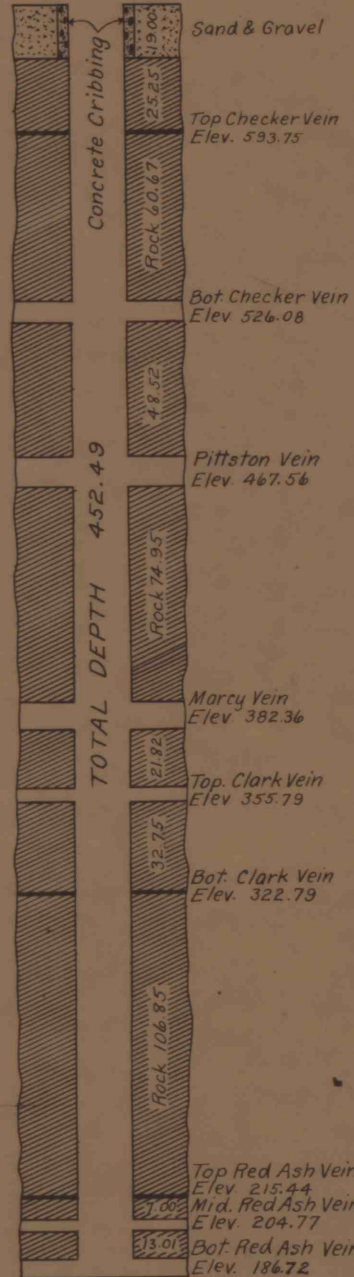


NO. 1 SHAFT
Elev. 730.57

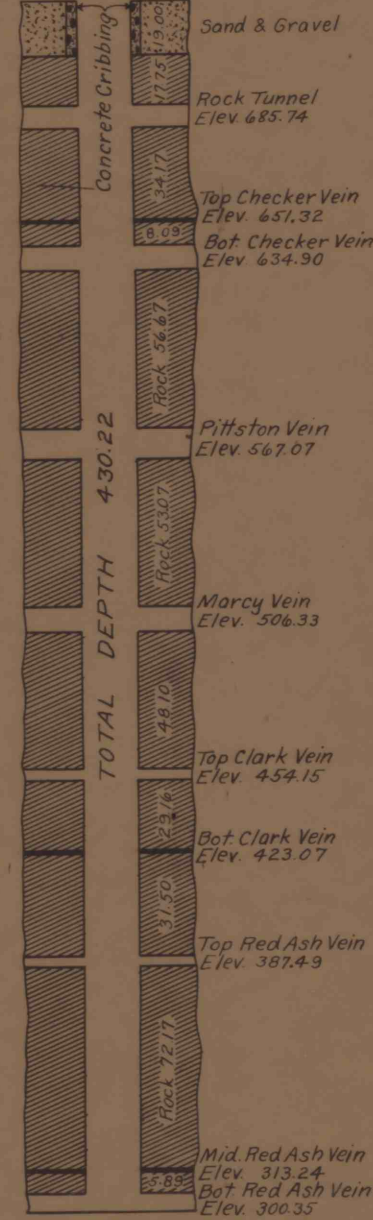


NO. 3 SHAFT
Elev. 602.42

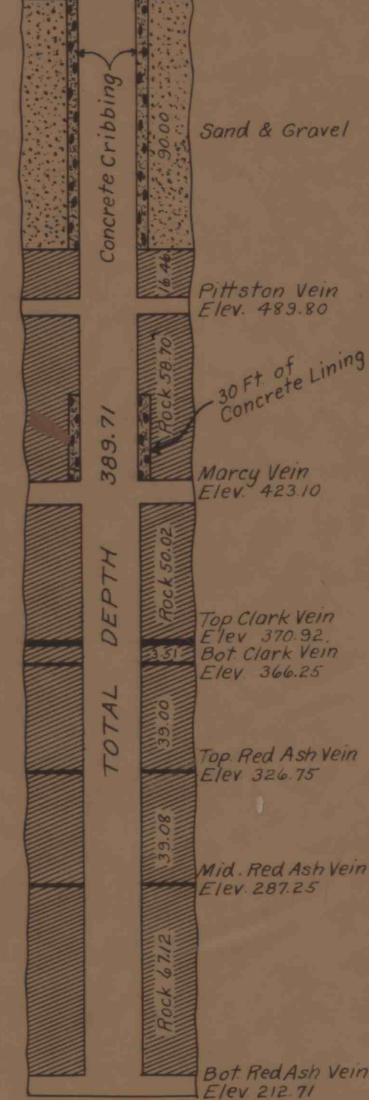

NO. 8 SHAFT
Elev. 749.57

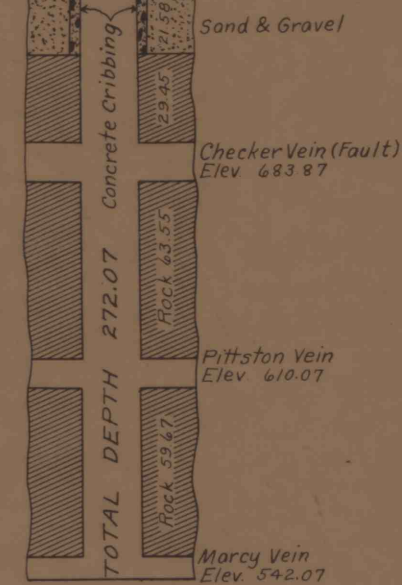

NO. 10 SHAFT
Elev. 638.34

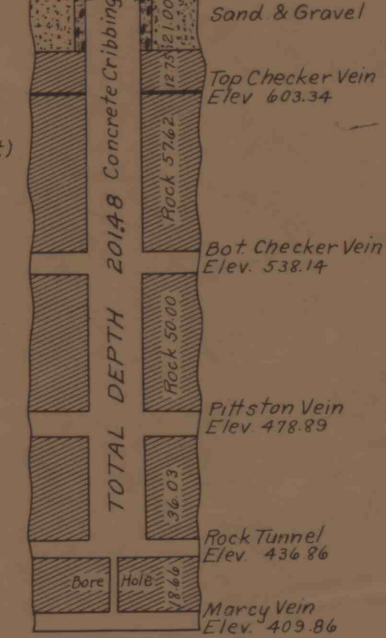

THE PITTSBURY COMPANY
SOUTHERN DIVISION
NO. 9 COLLIERY
SECTIONS OF
SHAFTS & SLOPES

Office of
Mining Engineer
Dunmore Pa.

Jan 1930