


THOMAS SHAFT
Elev. 883.62

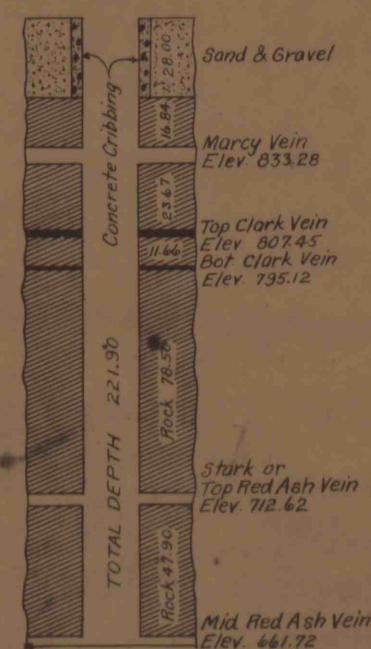

THE PITTSTON COMPANY,
SOUTHERN DIVISION
BUTLER COLLIERY
SECTIONS OF
SHAFT & SLOPES

Office of
Chief Engineer
Dunmore Pa.

Jan. 1930