


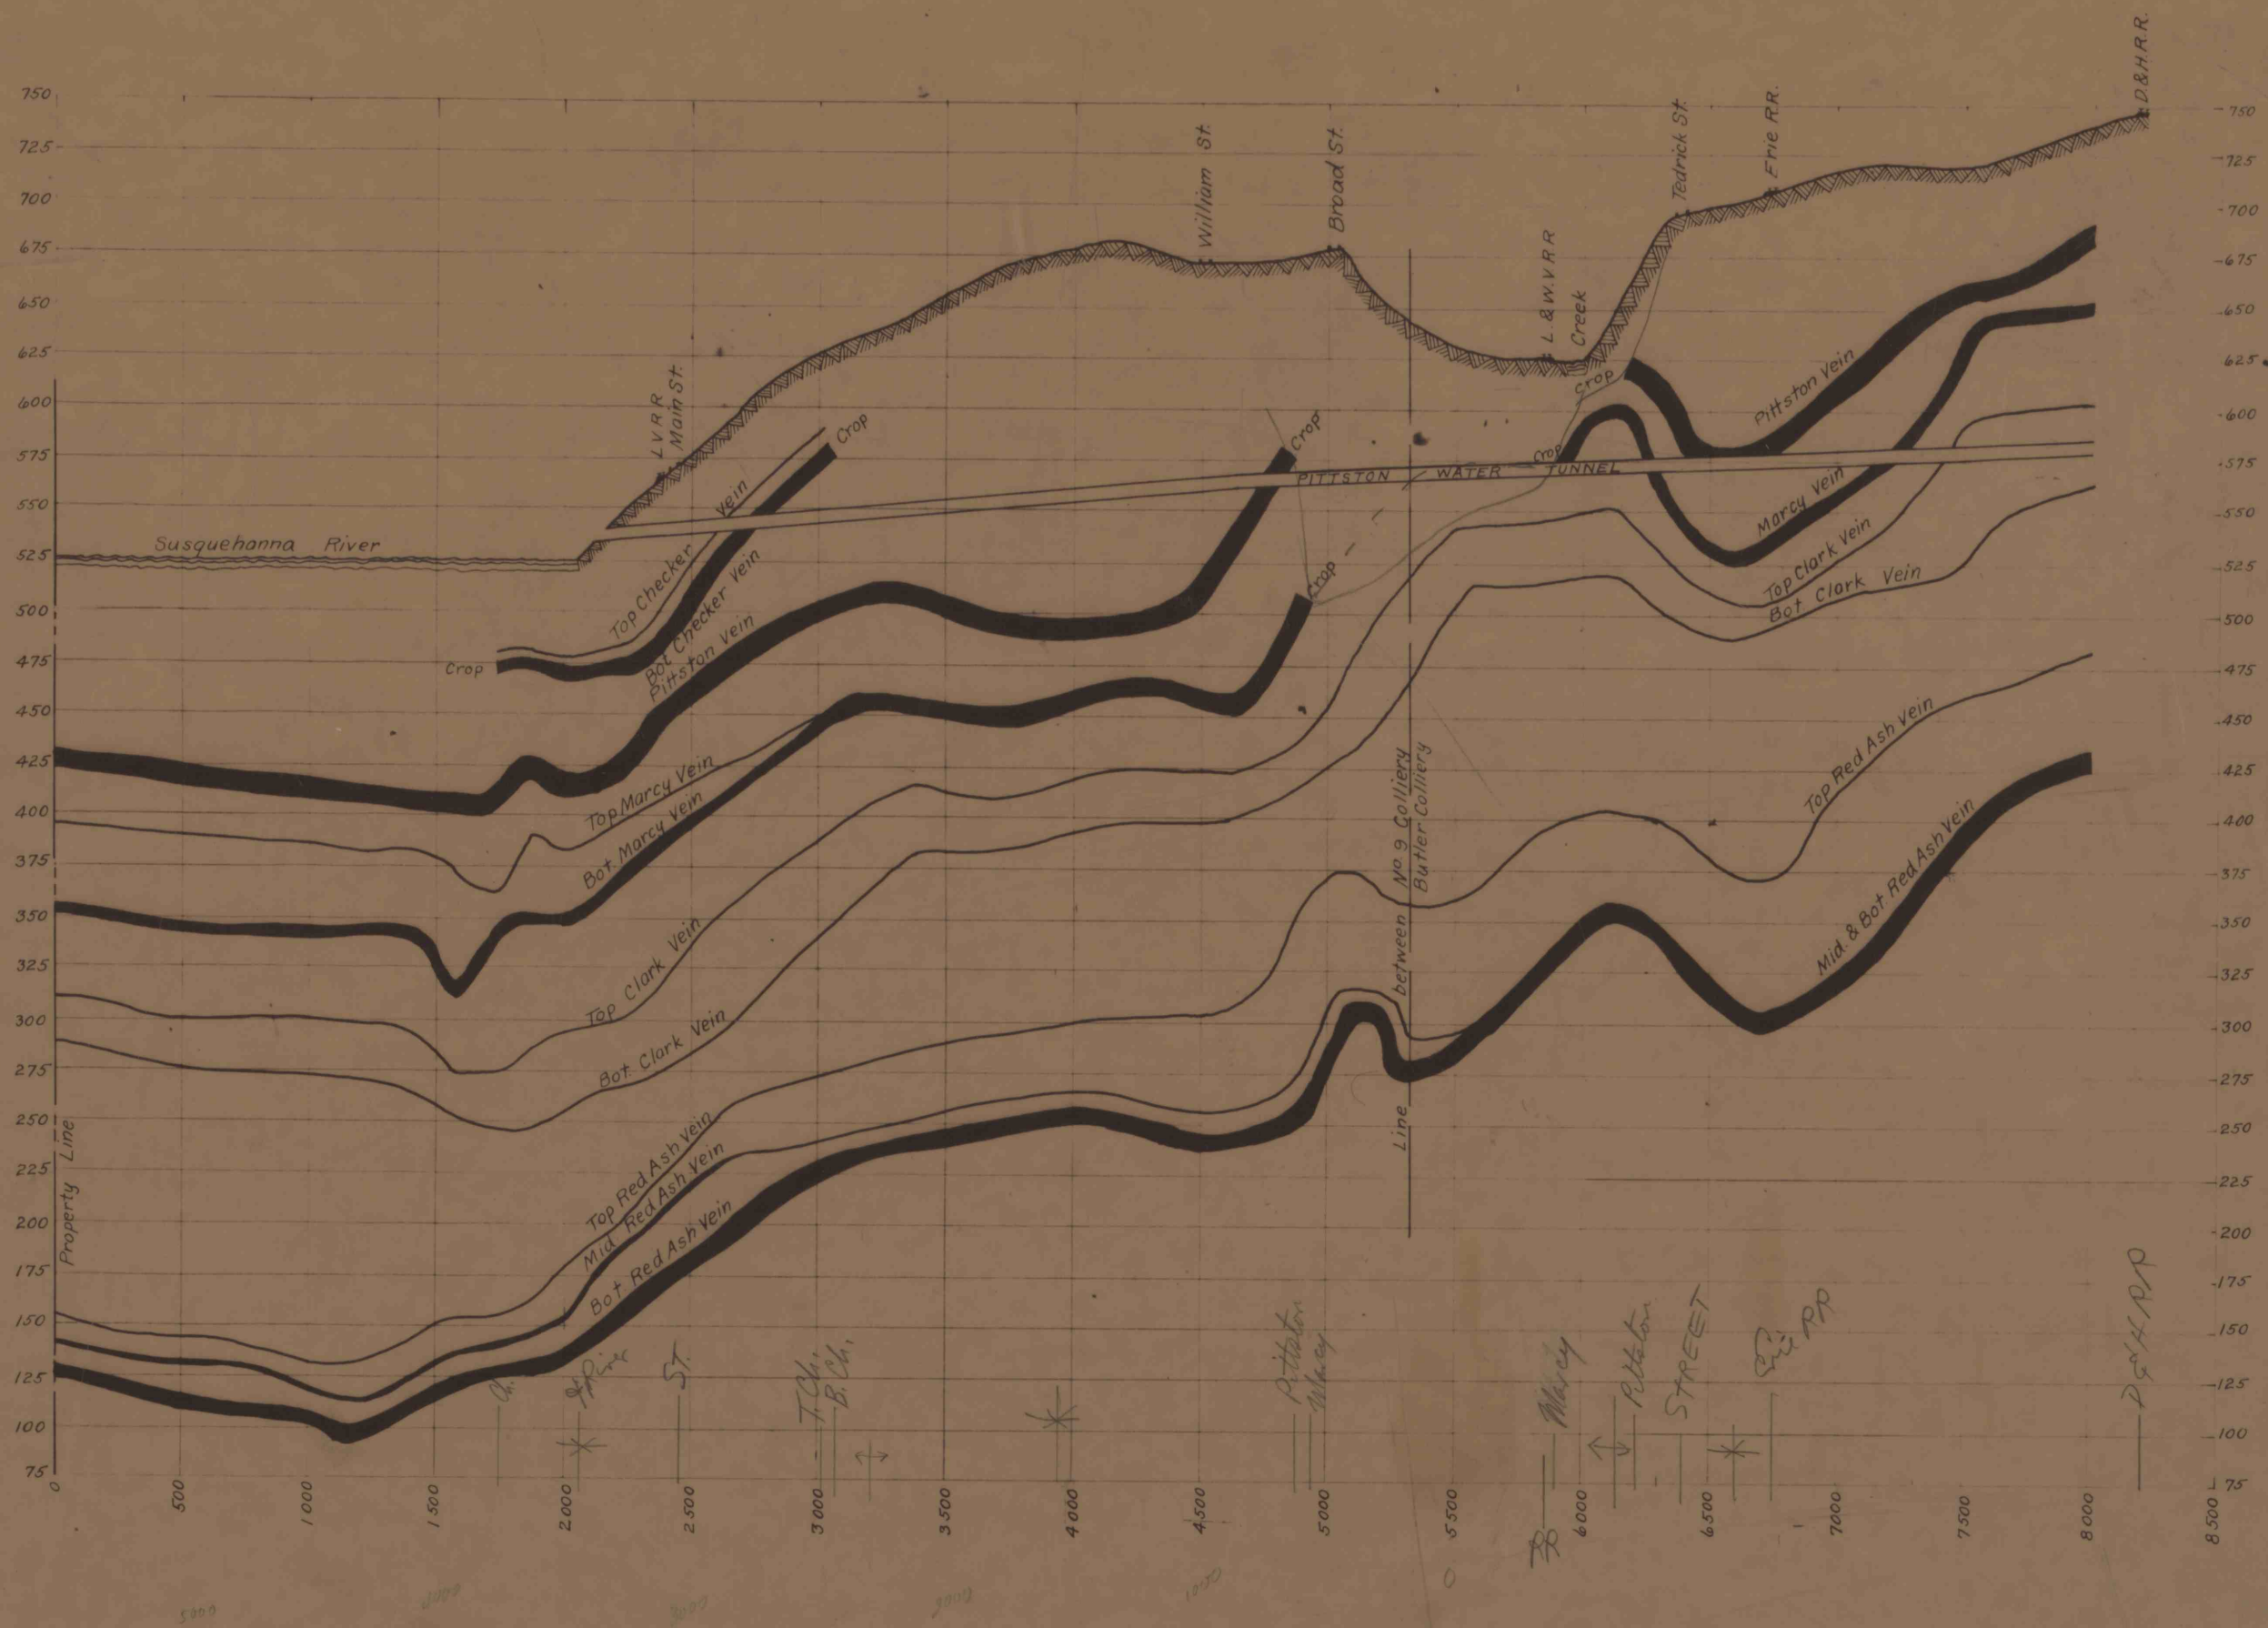

THE PITTSBURY COMPANY  
SOUTHERN DIVISION  
NO. 9 COLLIERY  
SECTION C - D

SCALE { HOR. 1" = 400'  
VER. 1" = 50'

Office of  
Mining Engineer  
Dunmore, Pa.

Jan. 1930