


G M P LAND COMPANY
SURFACE & MINERAL

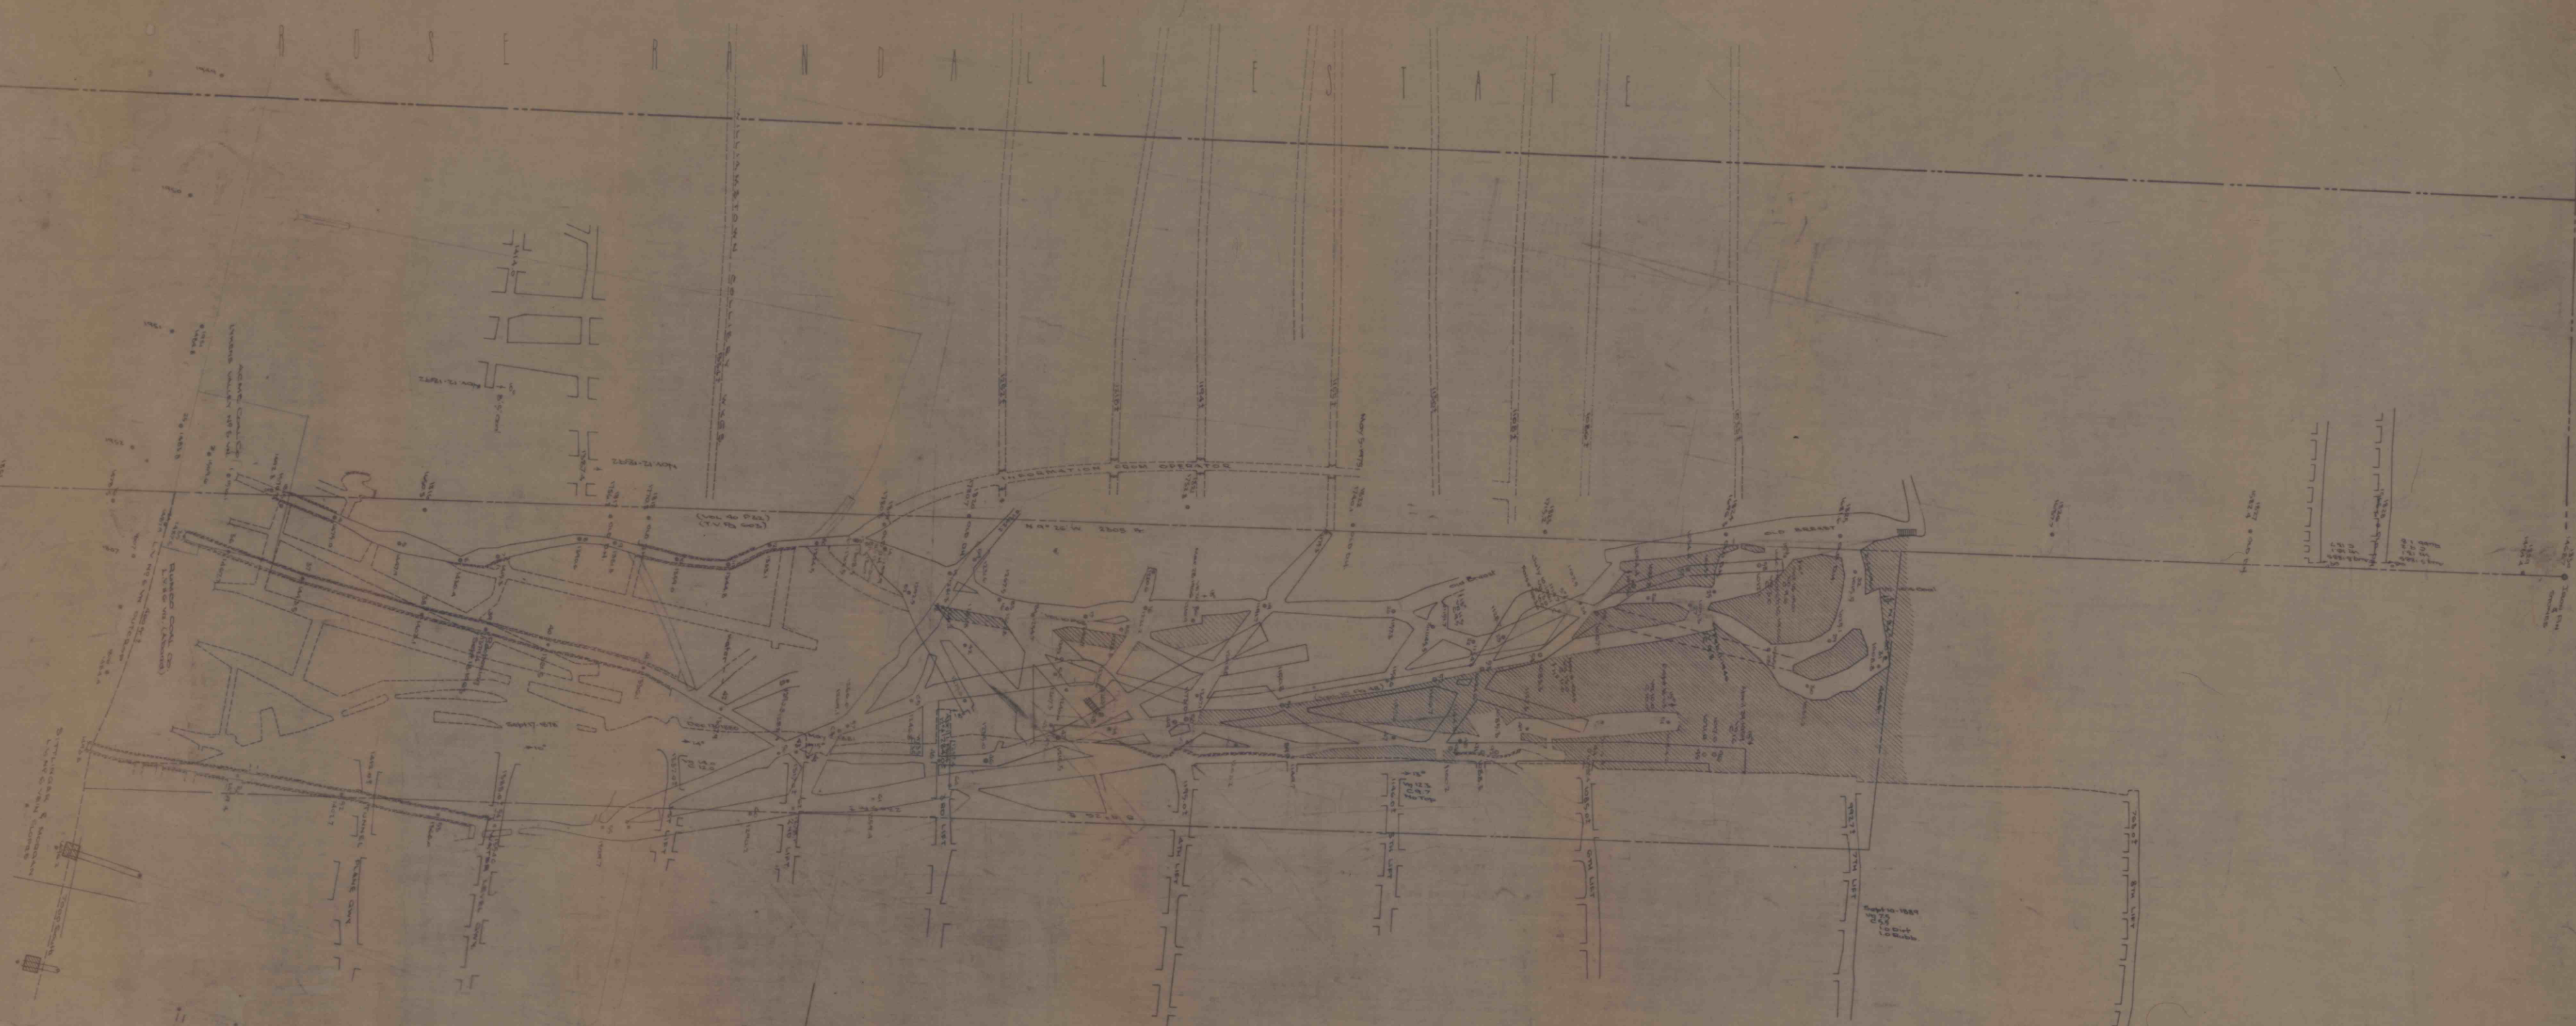

5528