


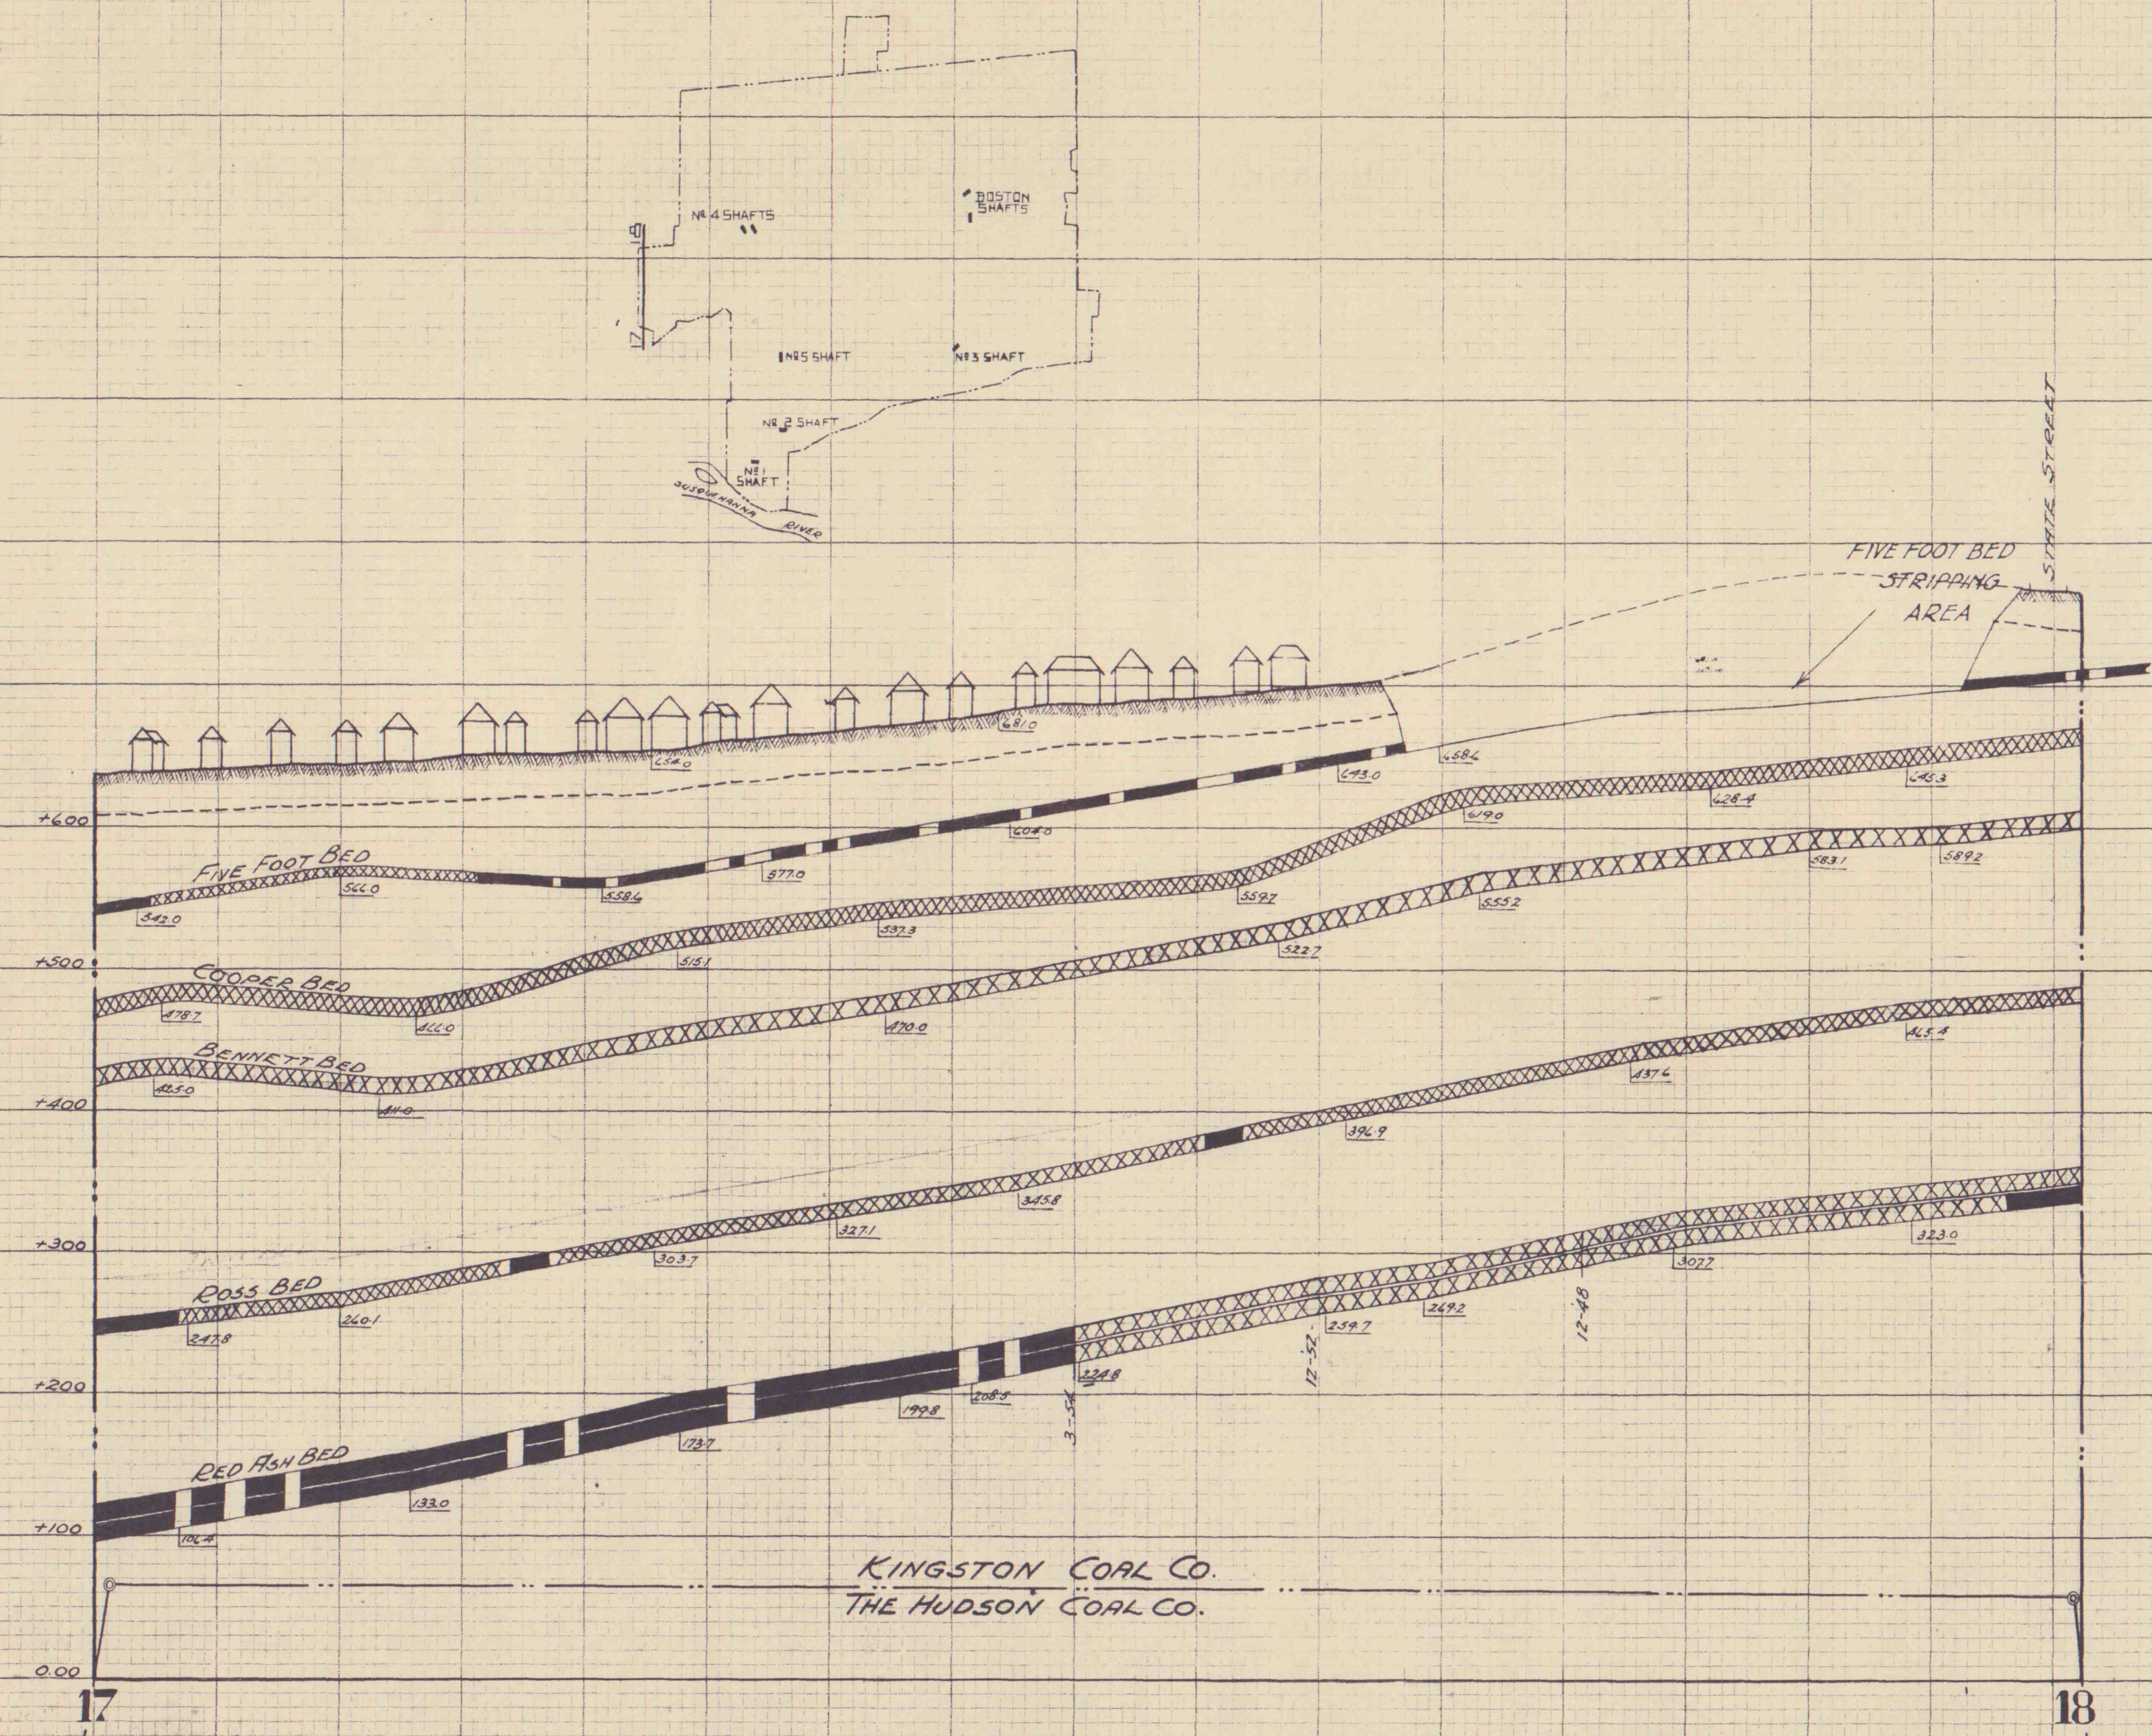

THE HUDSON COAL CO.
LOREE COLLIERY
CROSS SECTION
THRU COAL MEASURES
SCALE 1" = 100'
MINING ENGINEER'S OFFICE APRIL 1929

POSTED	
9-25-25	K.M.
3-1-47	K.M.
2-23-30	K.M.
2-27-53	K.M.
5-17-54	K.M.

8-71 1017322 22020
LOREE COLLIERY