


LOREE COLLIERY ——— CROSS SECTION 12-16

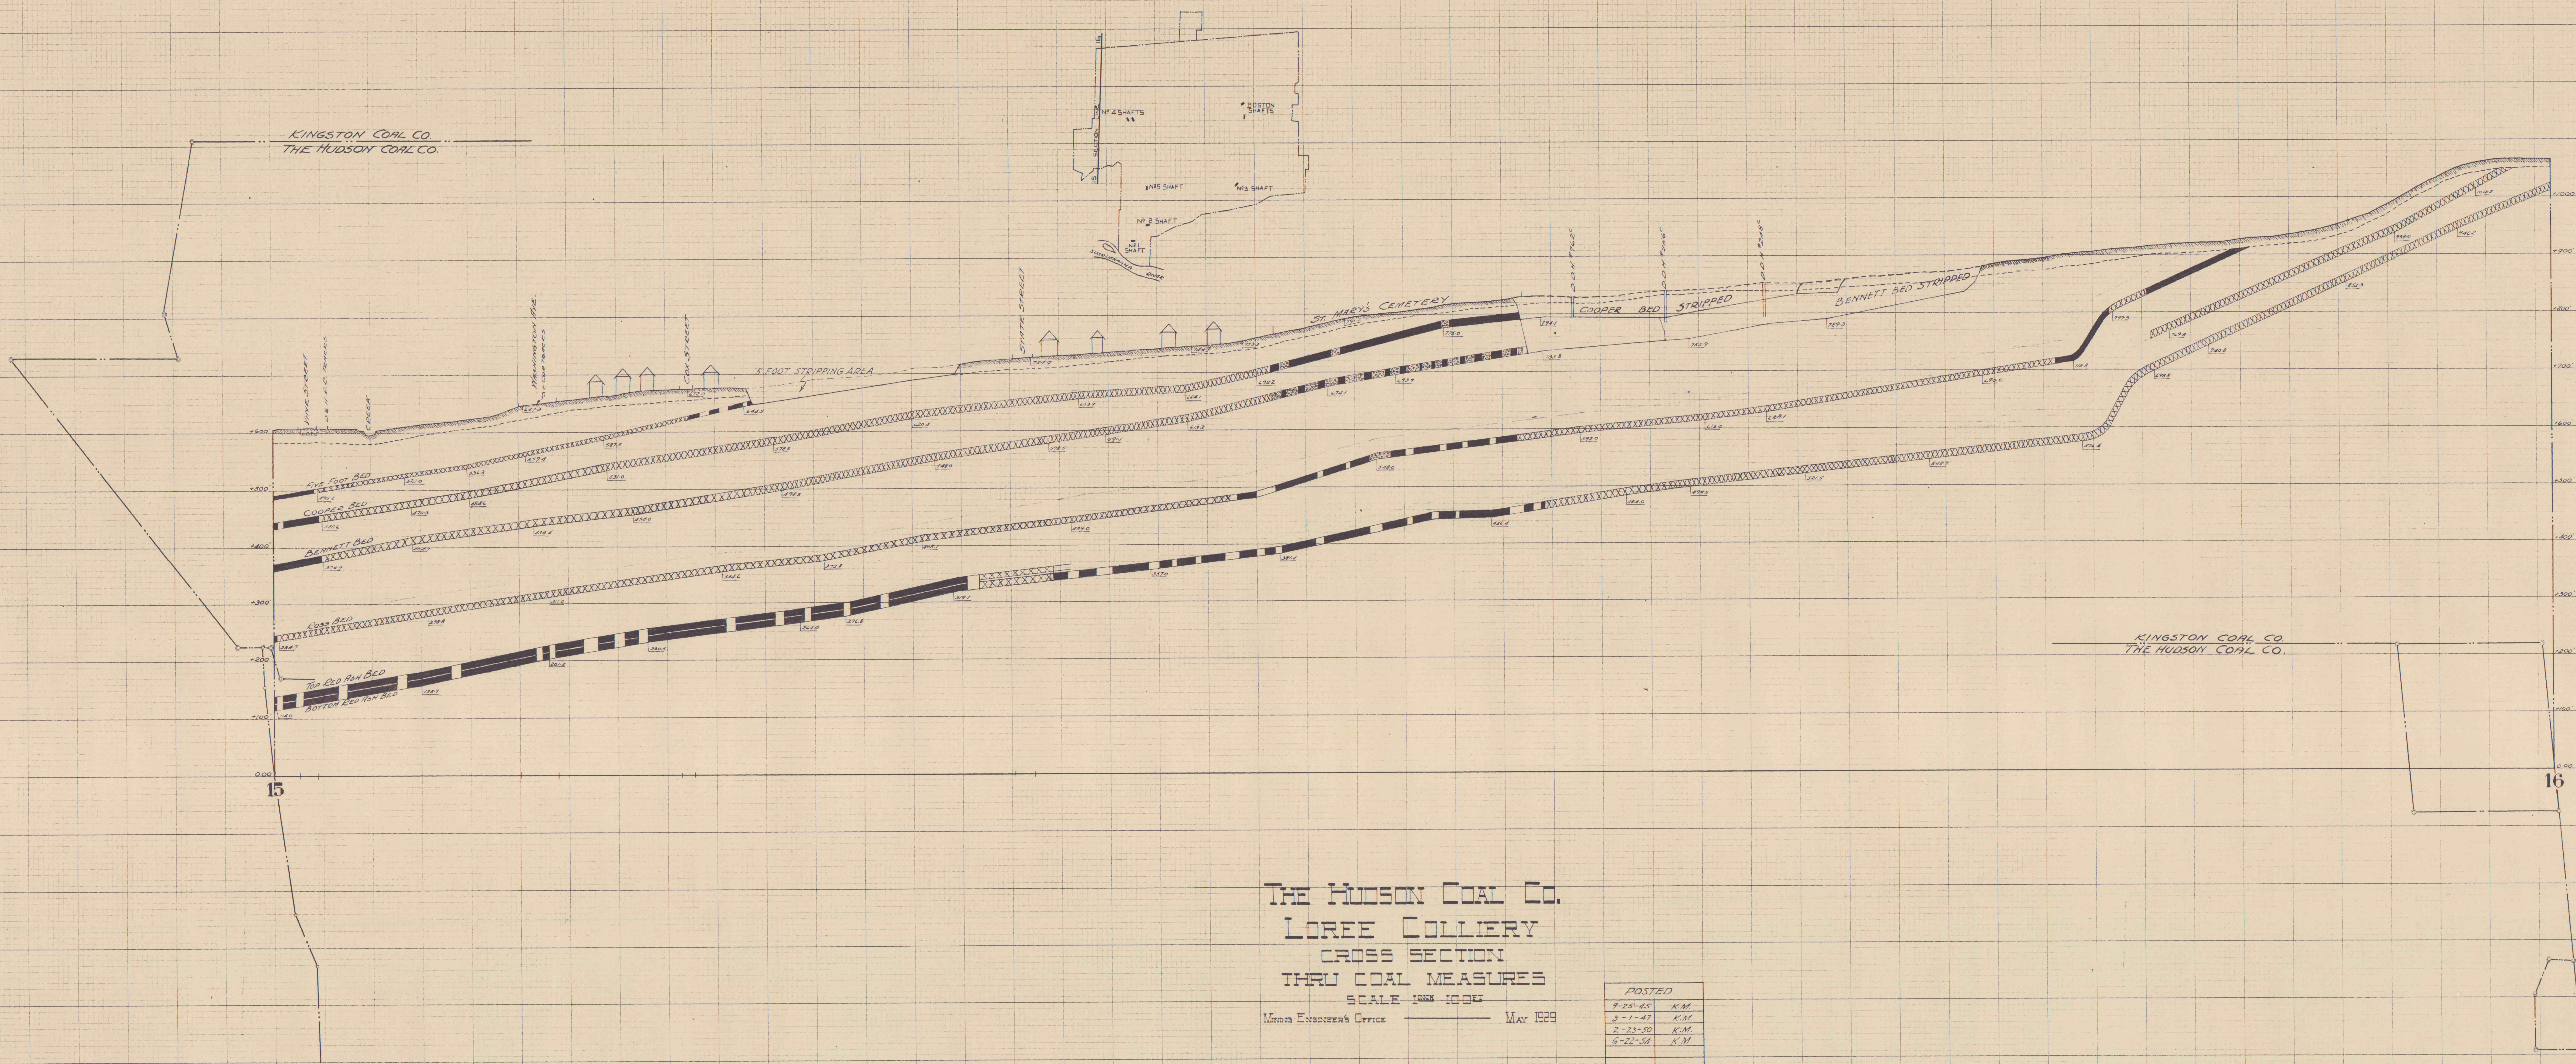

THE HUDSON COAL CO.
LOREE COLLIERY
CROSS SECTION
THRU COAL MEASURES
SCALE 1 INCH 100 FT
Mining Engineer's Office ——— May 1929

POSTED	
7-25-45	K.M.
3-1-47	K.M.
2-23-50	K.M.
6-22-54	K.M.

LOREE COLLIERY ——— CROSS SECTION 12-16