
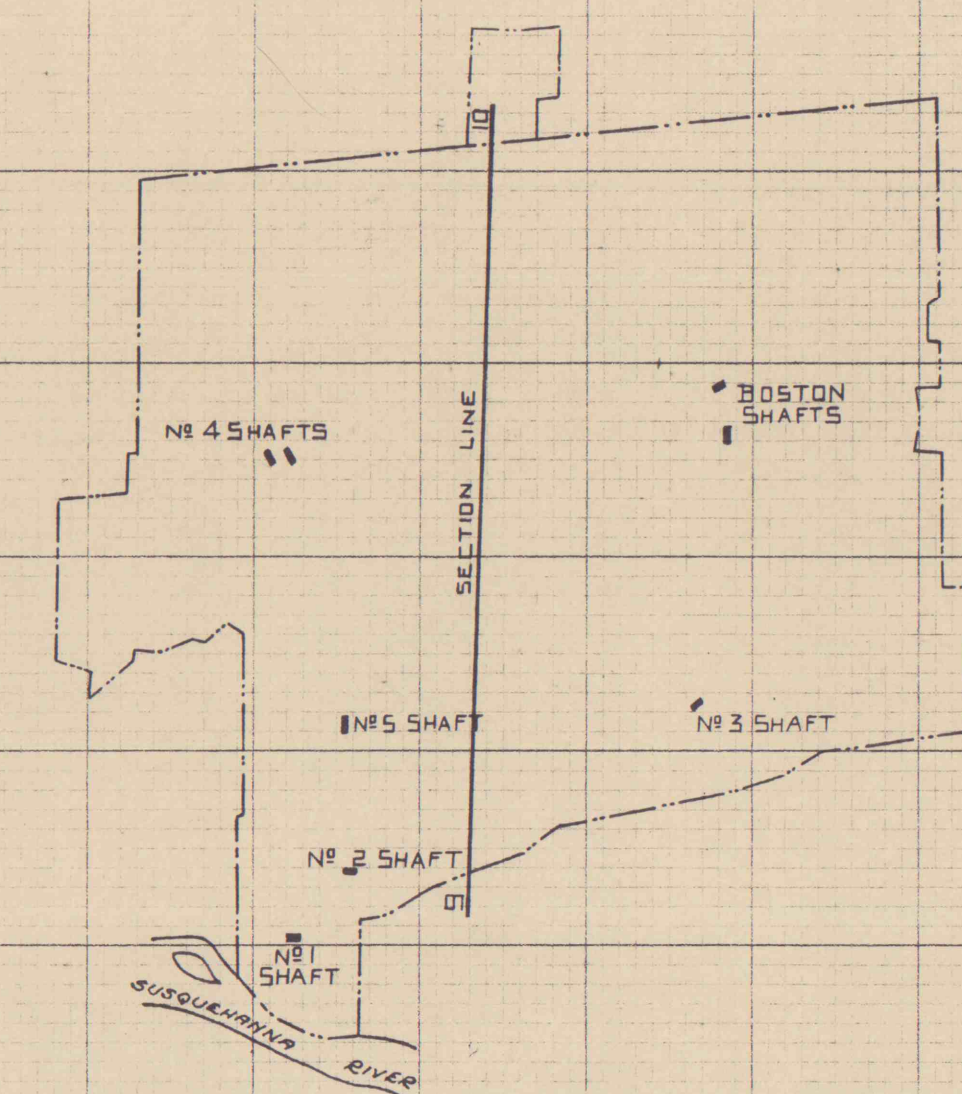


 

THE HUDSON COAL CO.
LOREE COLLIERY
CROSS SECTION
THRU COAL MEASURES
SCALE 1"=100'
MINING ENGINEER'S OFFICE NOVEMBER 1928

POSTED	
1-15-45	K.M.
2-1-47	K.M.
2-24-50	K.M.
2-12-52	K.M.
6-22-54	K.M.