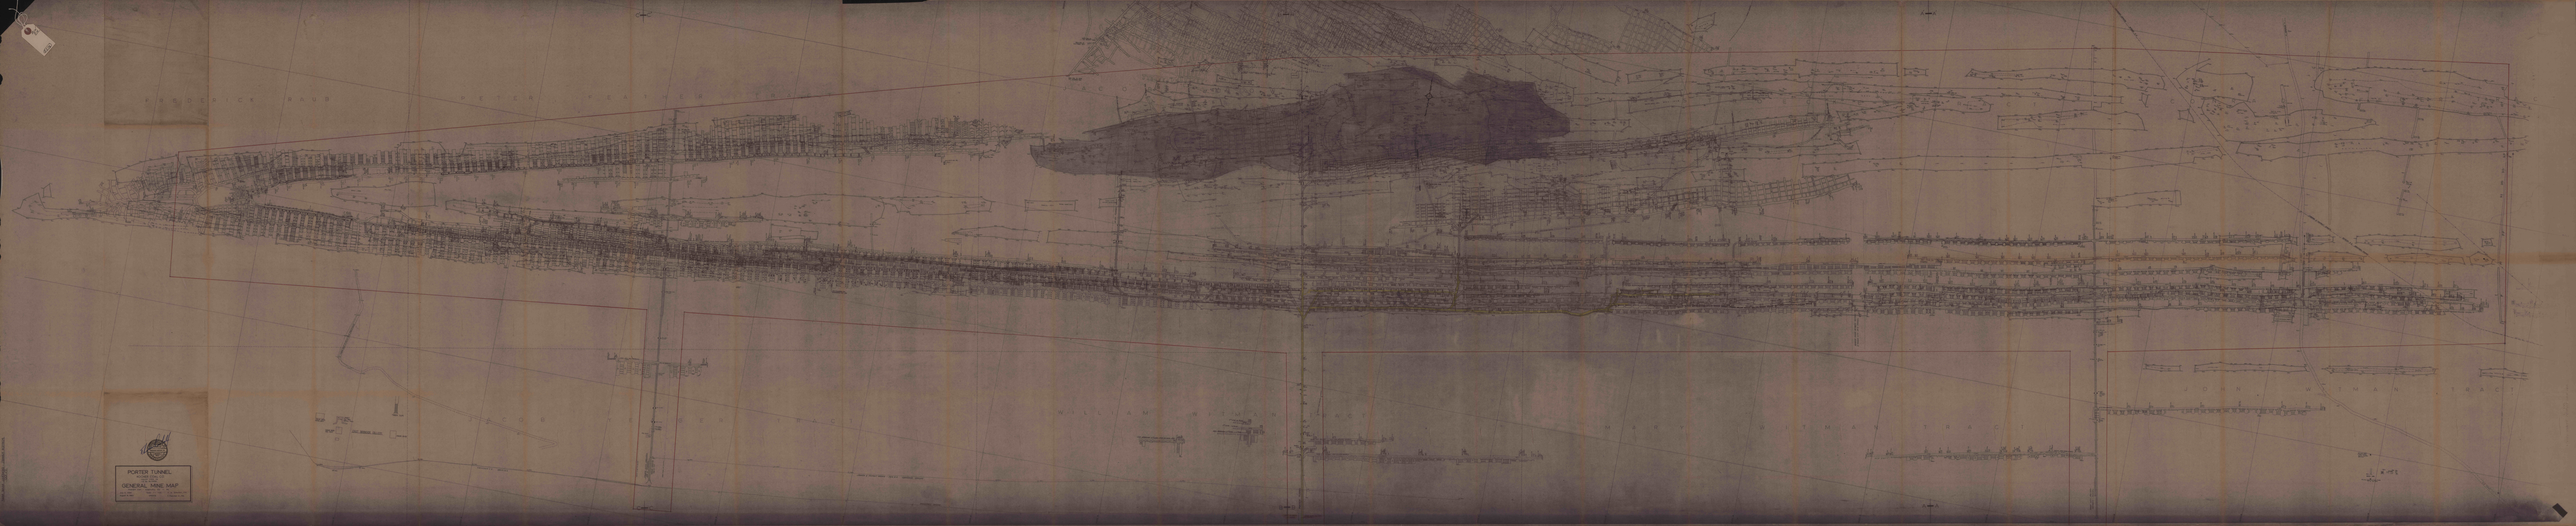
PORTER TUNNEL
GENERAL MINE MAP