


E A G E R T R A C T

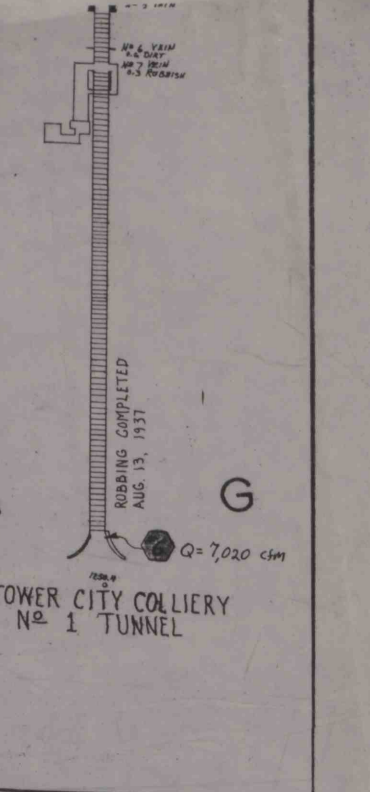

TOWER CITY COLLIERY
No. 1 TUNNEL

W I L L I A M

W I T M A N

T R A C T

SURFACE FAN
Jeffrey (5x10) Reversible Fan #3628
Motor: G.E. Model 5M6333051
150 hp. 880 rpm.
3 phase, 60 cycles, 2300 v.

Portion of Return Air
Then No. 2 Tower City Tunnel
(UPPER TUNNEL)

Q=158,000 CFM

VENTILATION MAP

Legend


- AIR FLOW-INTAKE
- AIR FLOW-EXHAUST
- PERMANENT STOPPING
- TEMPORARY STOPPING
- AIR BRIDGE
- REGULATOR
- MAN DOOR
- VELOCITY
- QUANTITY
- ACCESSIBLE ABANDONED AREA
- ESCAPEWAY
- BLEEDER EVALUATION POINT

Reference ventilation to surface via
abandoned workings and crop falls.
Notes: For complete map details of abandoned workings, please
see the General Mine Map and associated T-1 Map.
Dates: "The word 'Terra' is referred to when coal is not yet mined.
i.e., reference to Terra is actually a coal seam.

Property Line

Active Areas

M A R Y W I T M A N

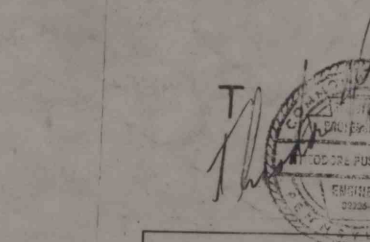

PORTER TUNNEL
KOCHER COAL COMPANY
Valley View, PA
I.D. No. 36-01892

MINE MAP SHOWING THE
Ventilation System
OF THE PORTER TUNNEL MINE

Porter Township
Schuylkill County
Pennsylvania

NORTH

100' 50' 0 100' 200'

1 INCH EQUALS 100 FEET

Feb. 3, 1982	F.A. Schuckler, PE
Feb. 7, 1983	R.C. Dolenc
Feb. 1, 1984	R.C. Dolenc
Feb. 4, 1985	R.C. Dolenc
Feb. 7, 1986	R.C. Dolenc
Feb. 6, 1987	R.C. Dolenc, PE
Jan. 8, 1988	R.C. Dolenc, PE
Jan. 10, 1989	T. Puschak, PE
May 28, 1992	T. Puschak, Jr., PE