


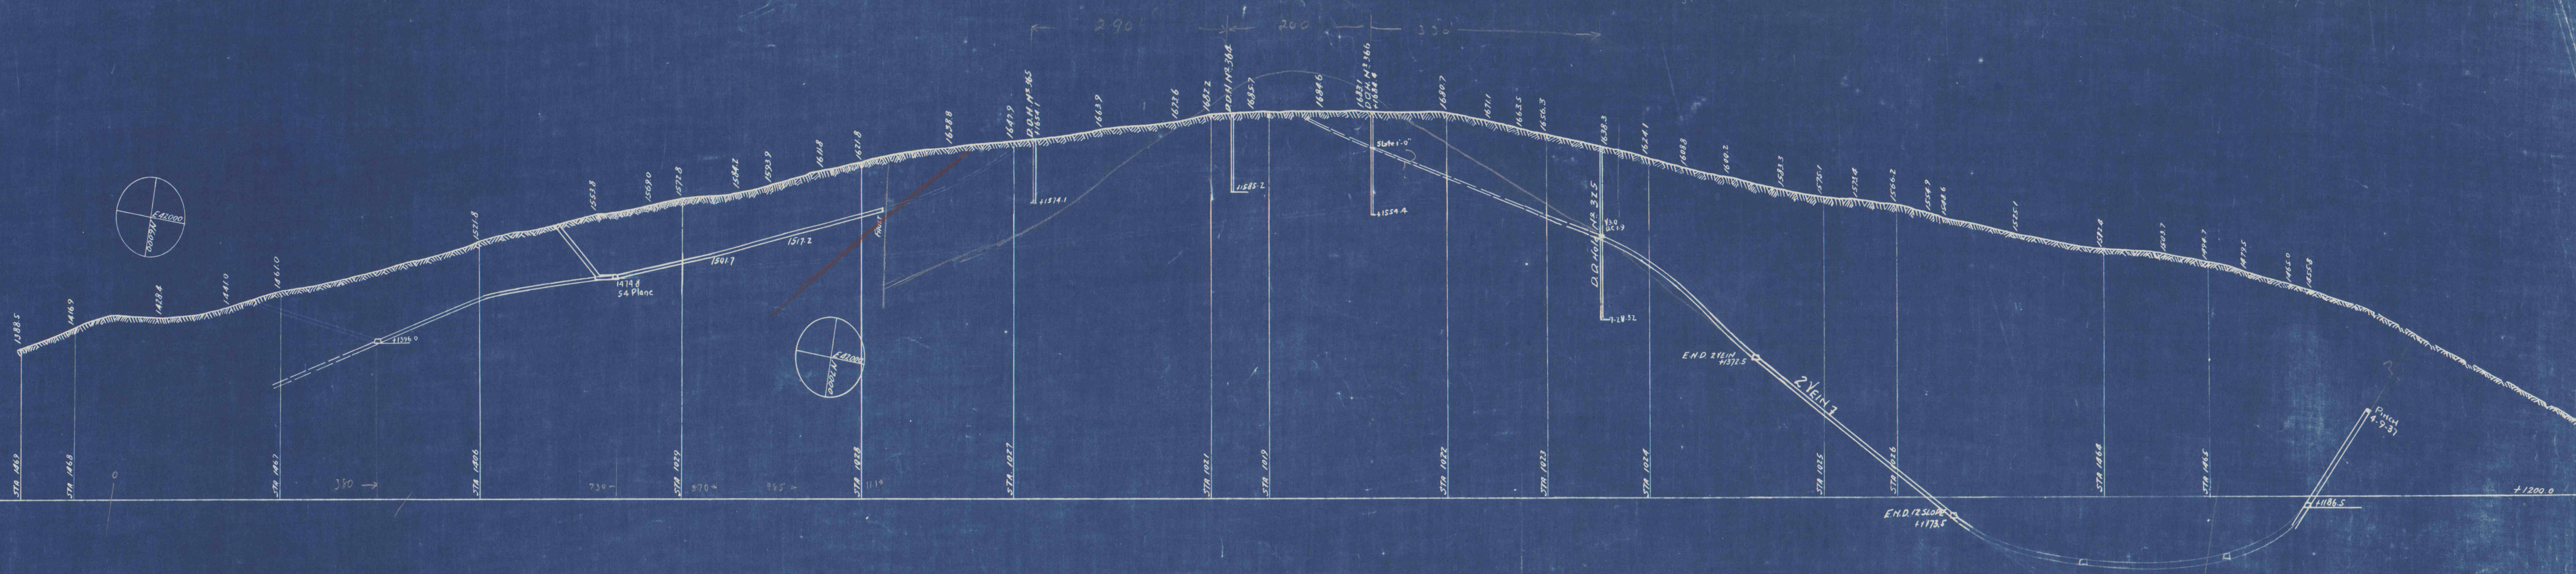

SECTION NO 25
ON LINE OF BREAST 63 E.N.D.2 VN
NATALIE COLLIERY
COLONIAL COLLIERY COMPANY
SCALE 1-IN=100-FT. AUG 1932