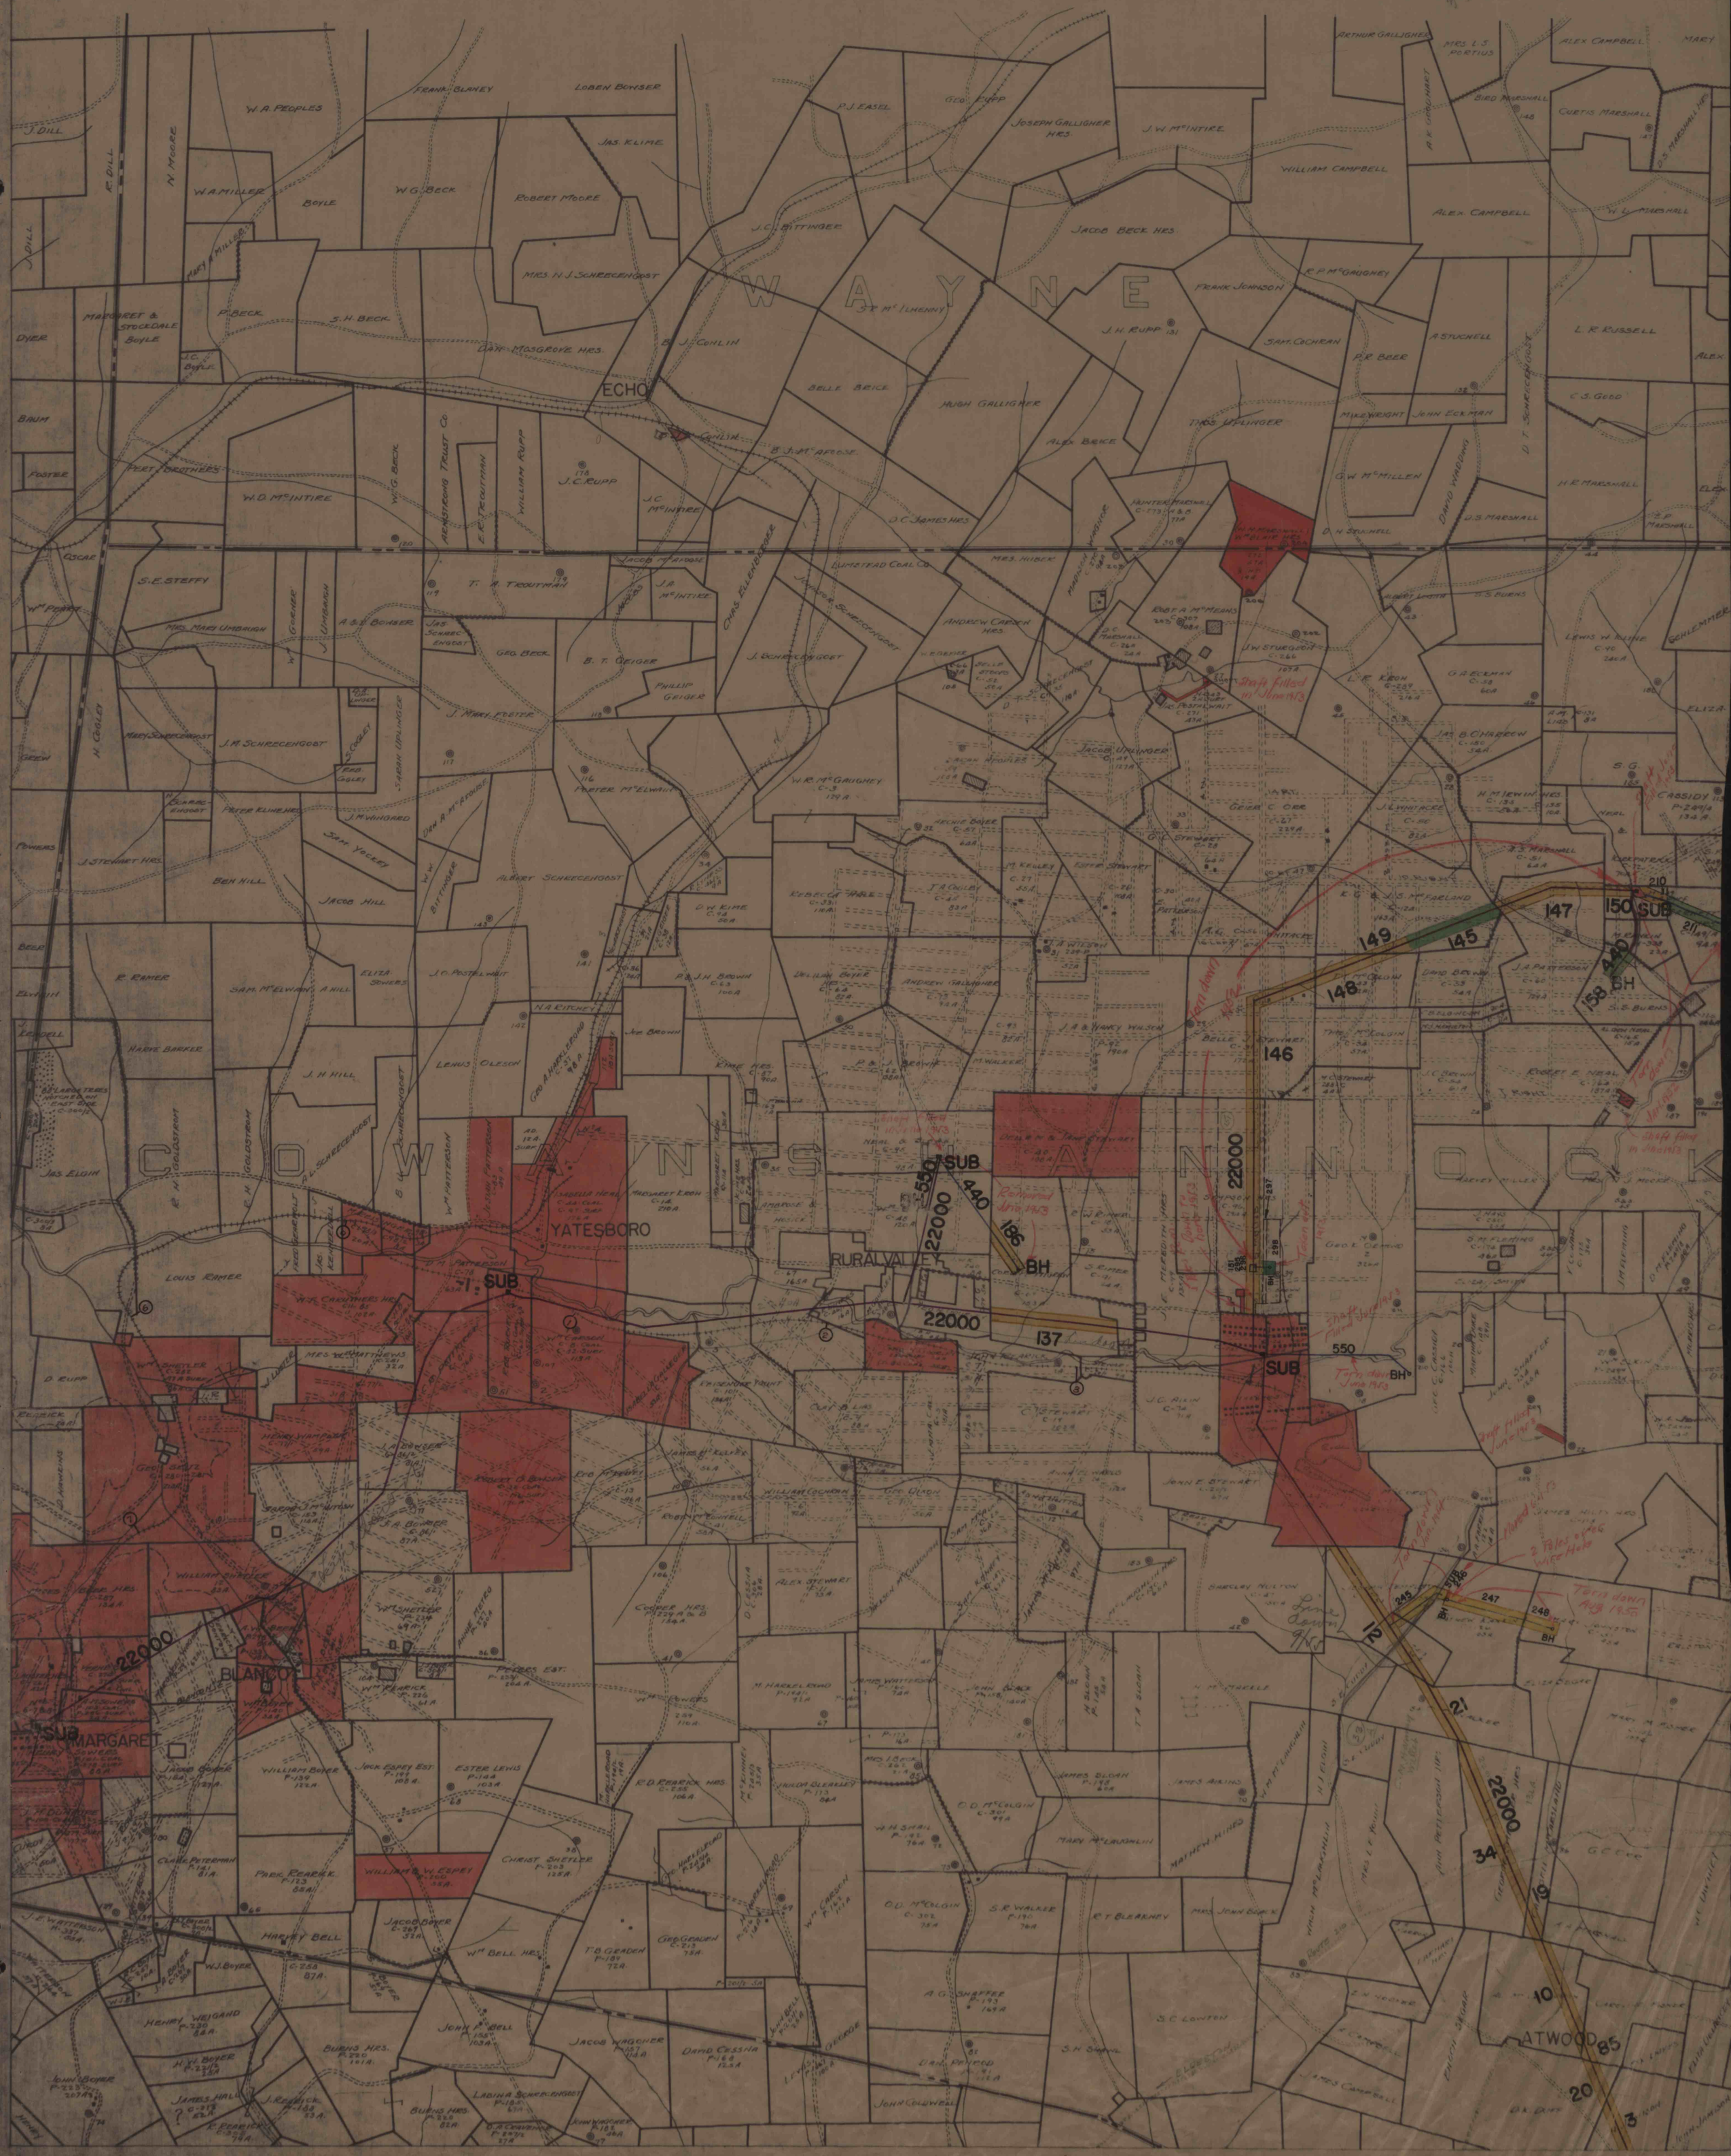
WAYNE
COWANNOCK
ECHO
YATESBORO
RURALVALLEY
BLANCO
MARGARET
ATWOOD
SUB
BH
22000
550
440
186
137
147
150
149
145
148
146
158
210
211
243
247
248
Shaft filled in June 1943
Torn down June 1943
Removed June 1943
Torn down Aug 1955
Line down 9/45
Torn down Jan. 1944
Shaft filled June 1943
Shaft filled in June 1943
2 Poles of 66 wire here
Torn down Jan. 1944
Shaft filled June 1943
Shaft filled June 1943
Shaft filled June 1943