


MINE 38 D

1"=100' BASE MAPS

P.C.&C. 1"=100'
EGGSHELL BASE MAPS

B.M.C. 1"=100'
CRONOFLEX BASE MAPS

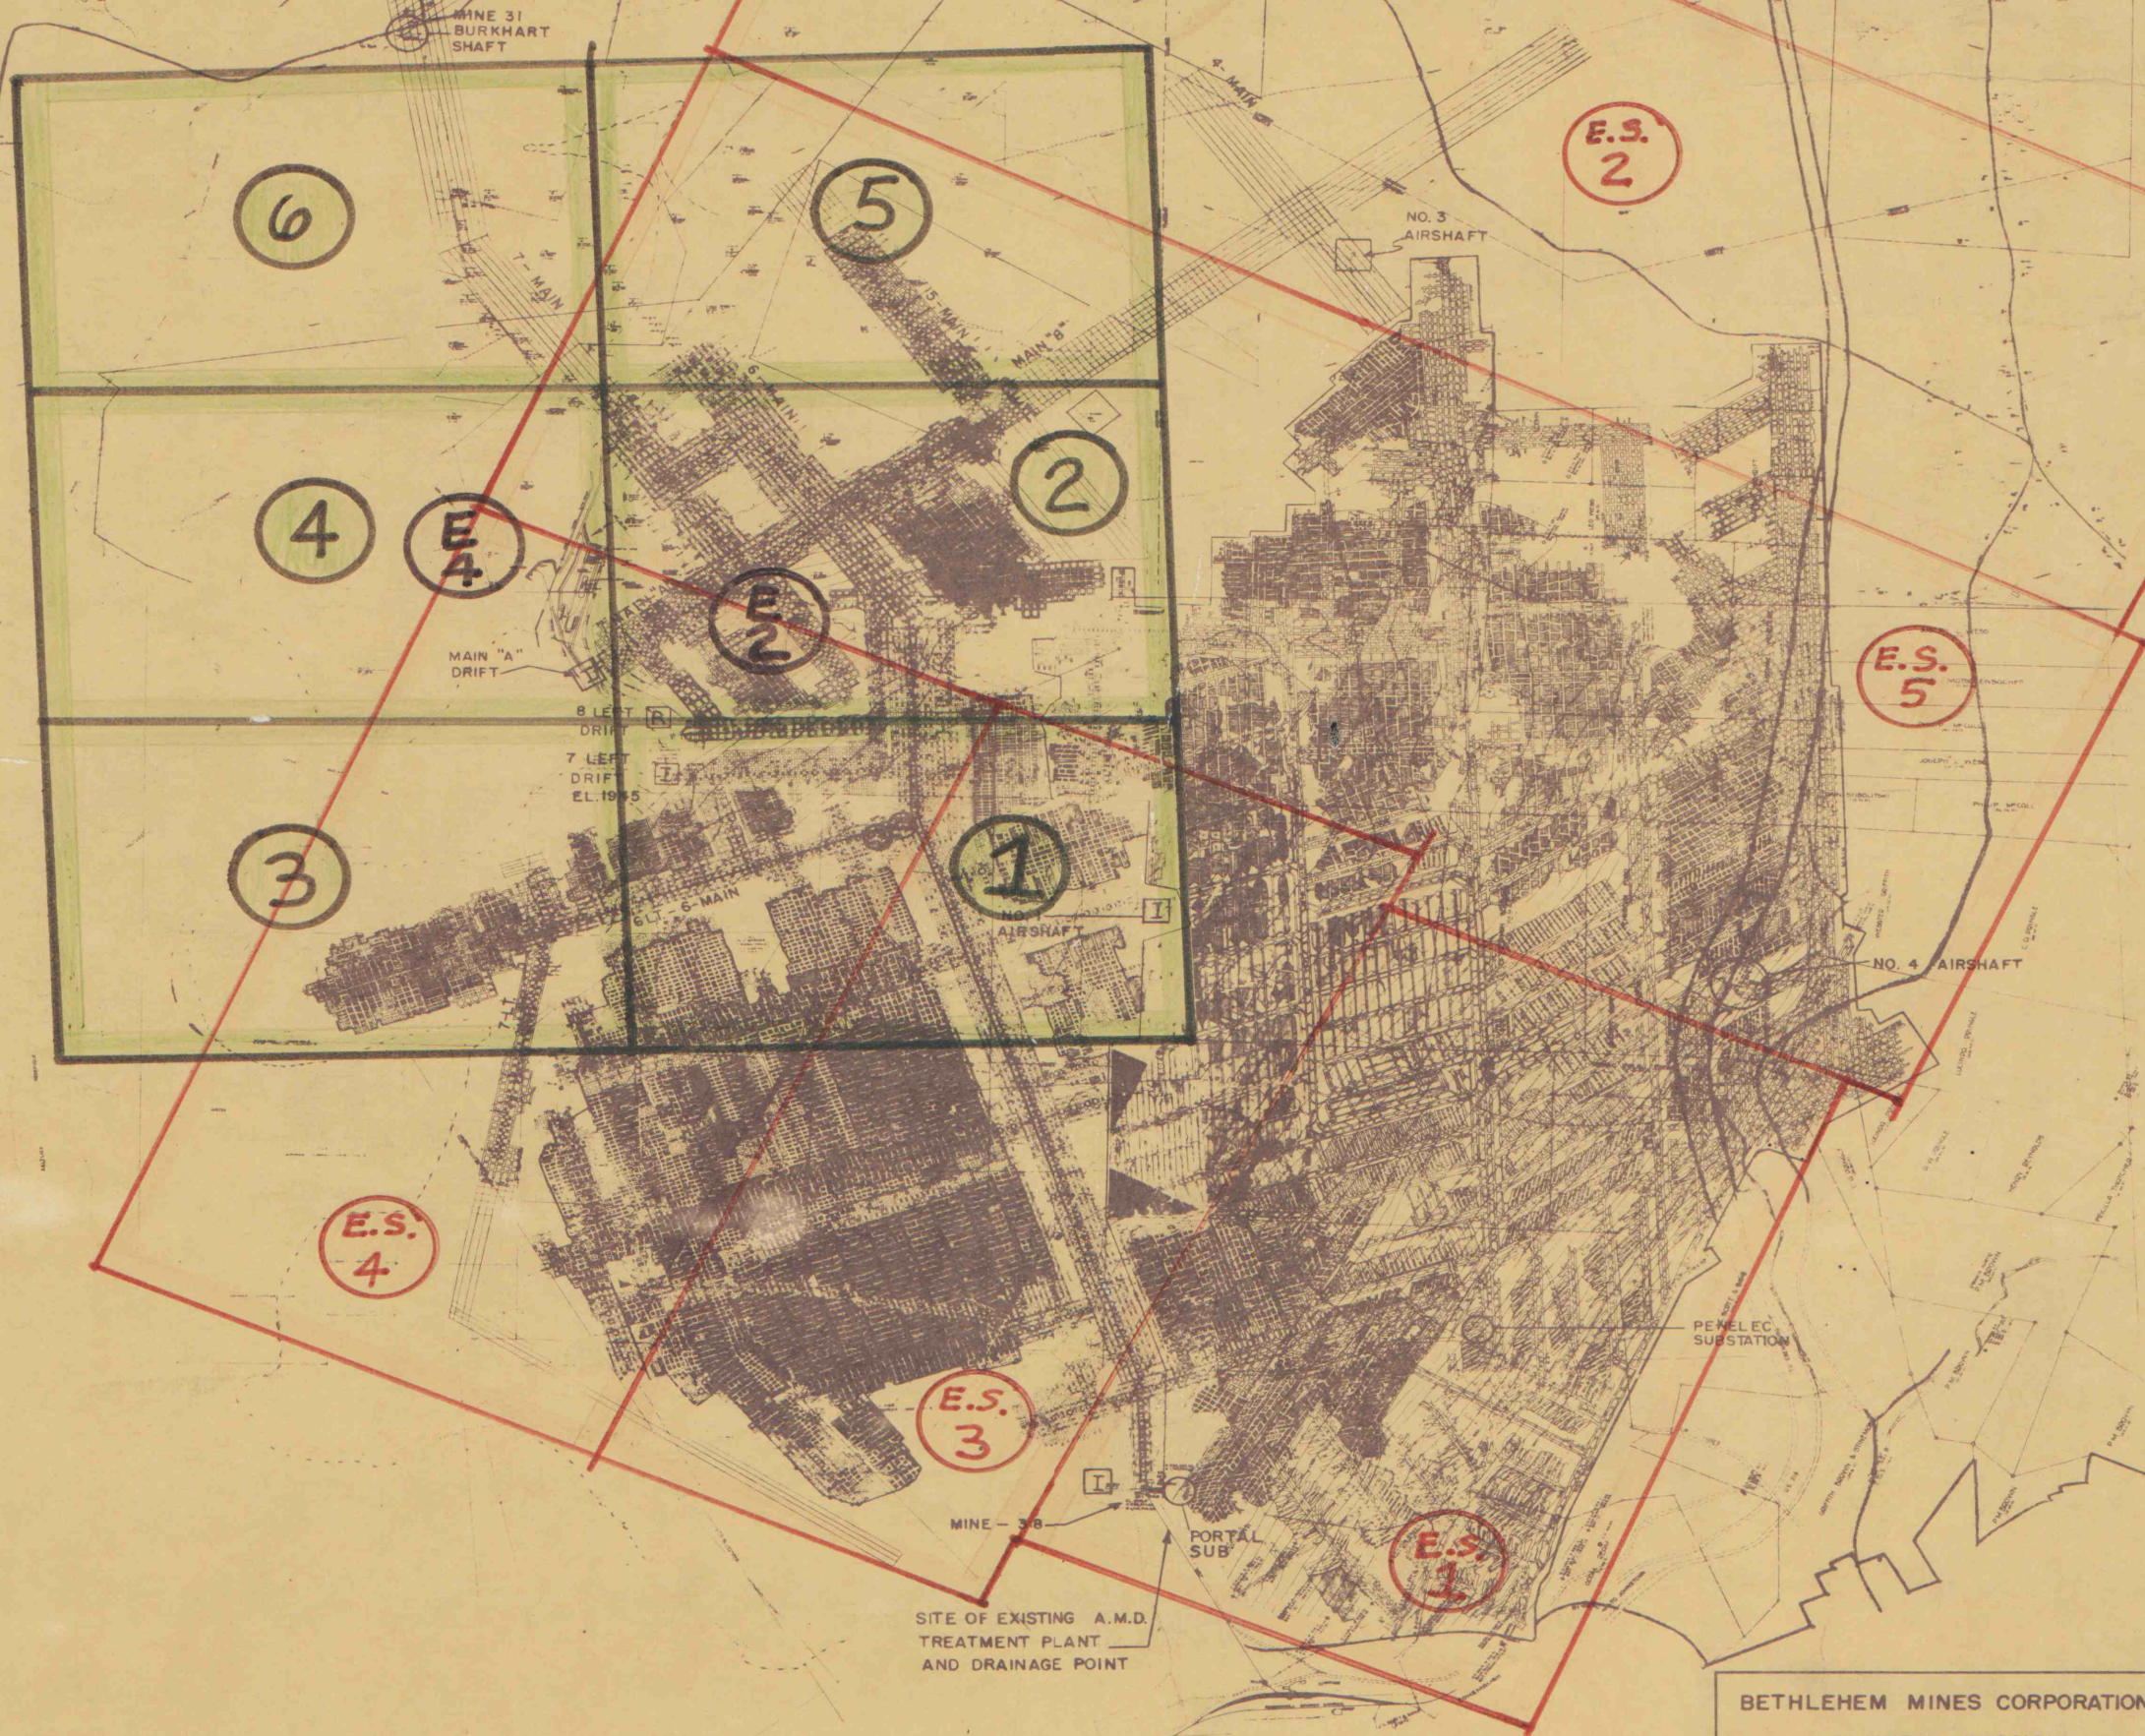

BETHLEHEM MINES CORPORATION
CAMBRIA DIVISION
MINE NO. 38
LOWER FREEPORT SEAM
SCALE: 1"=2000' DATE: 4-30-80
FINAL SURVEY