


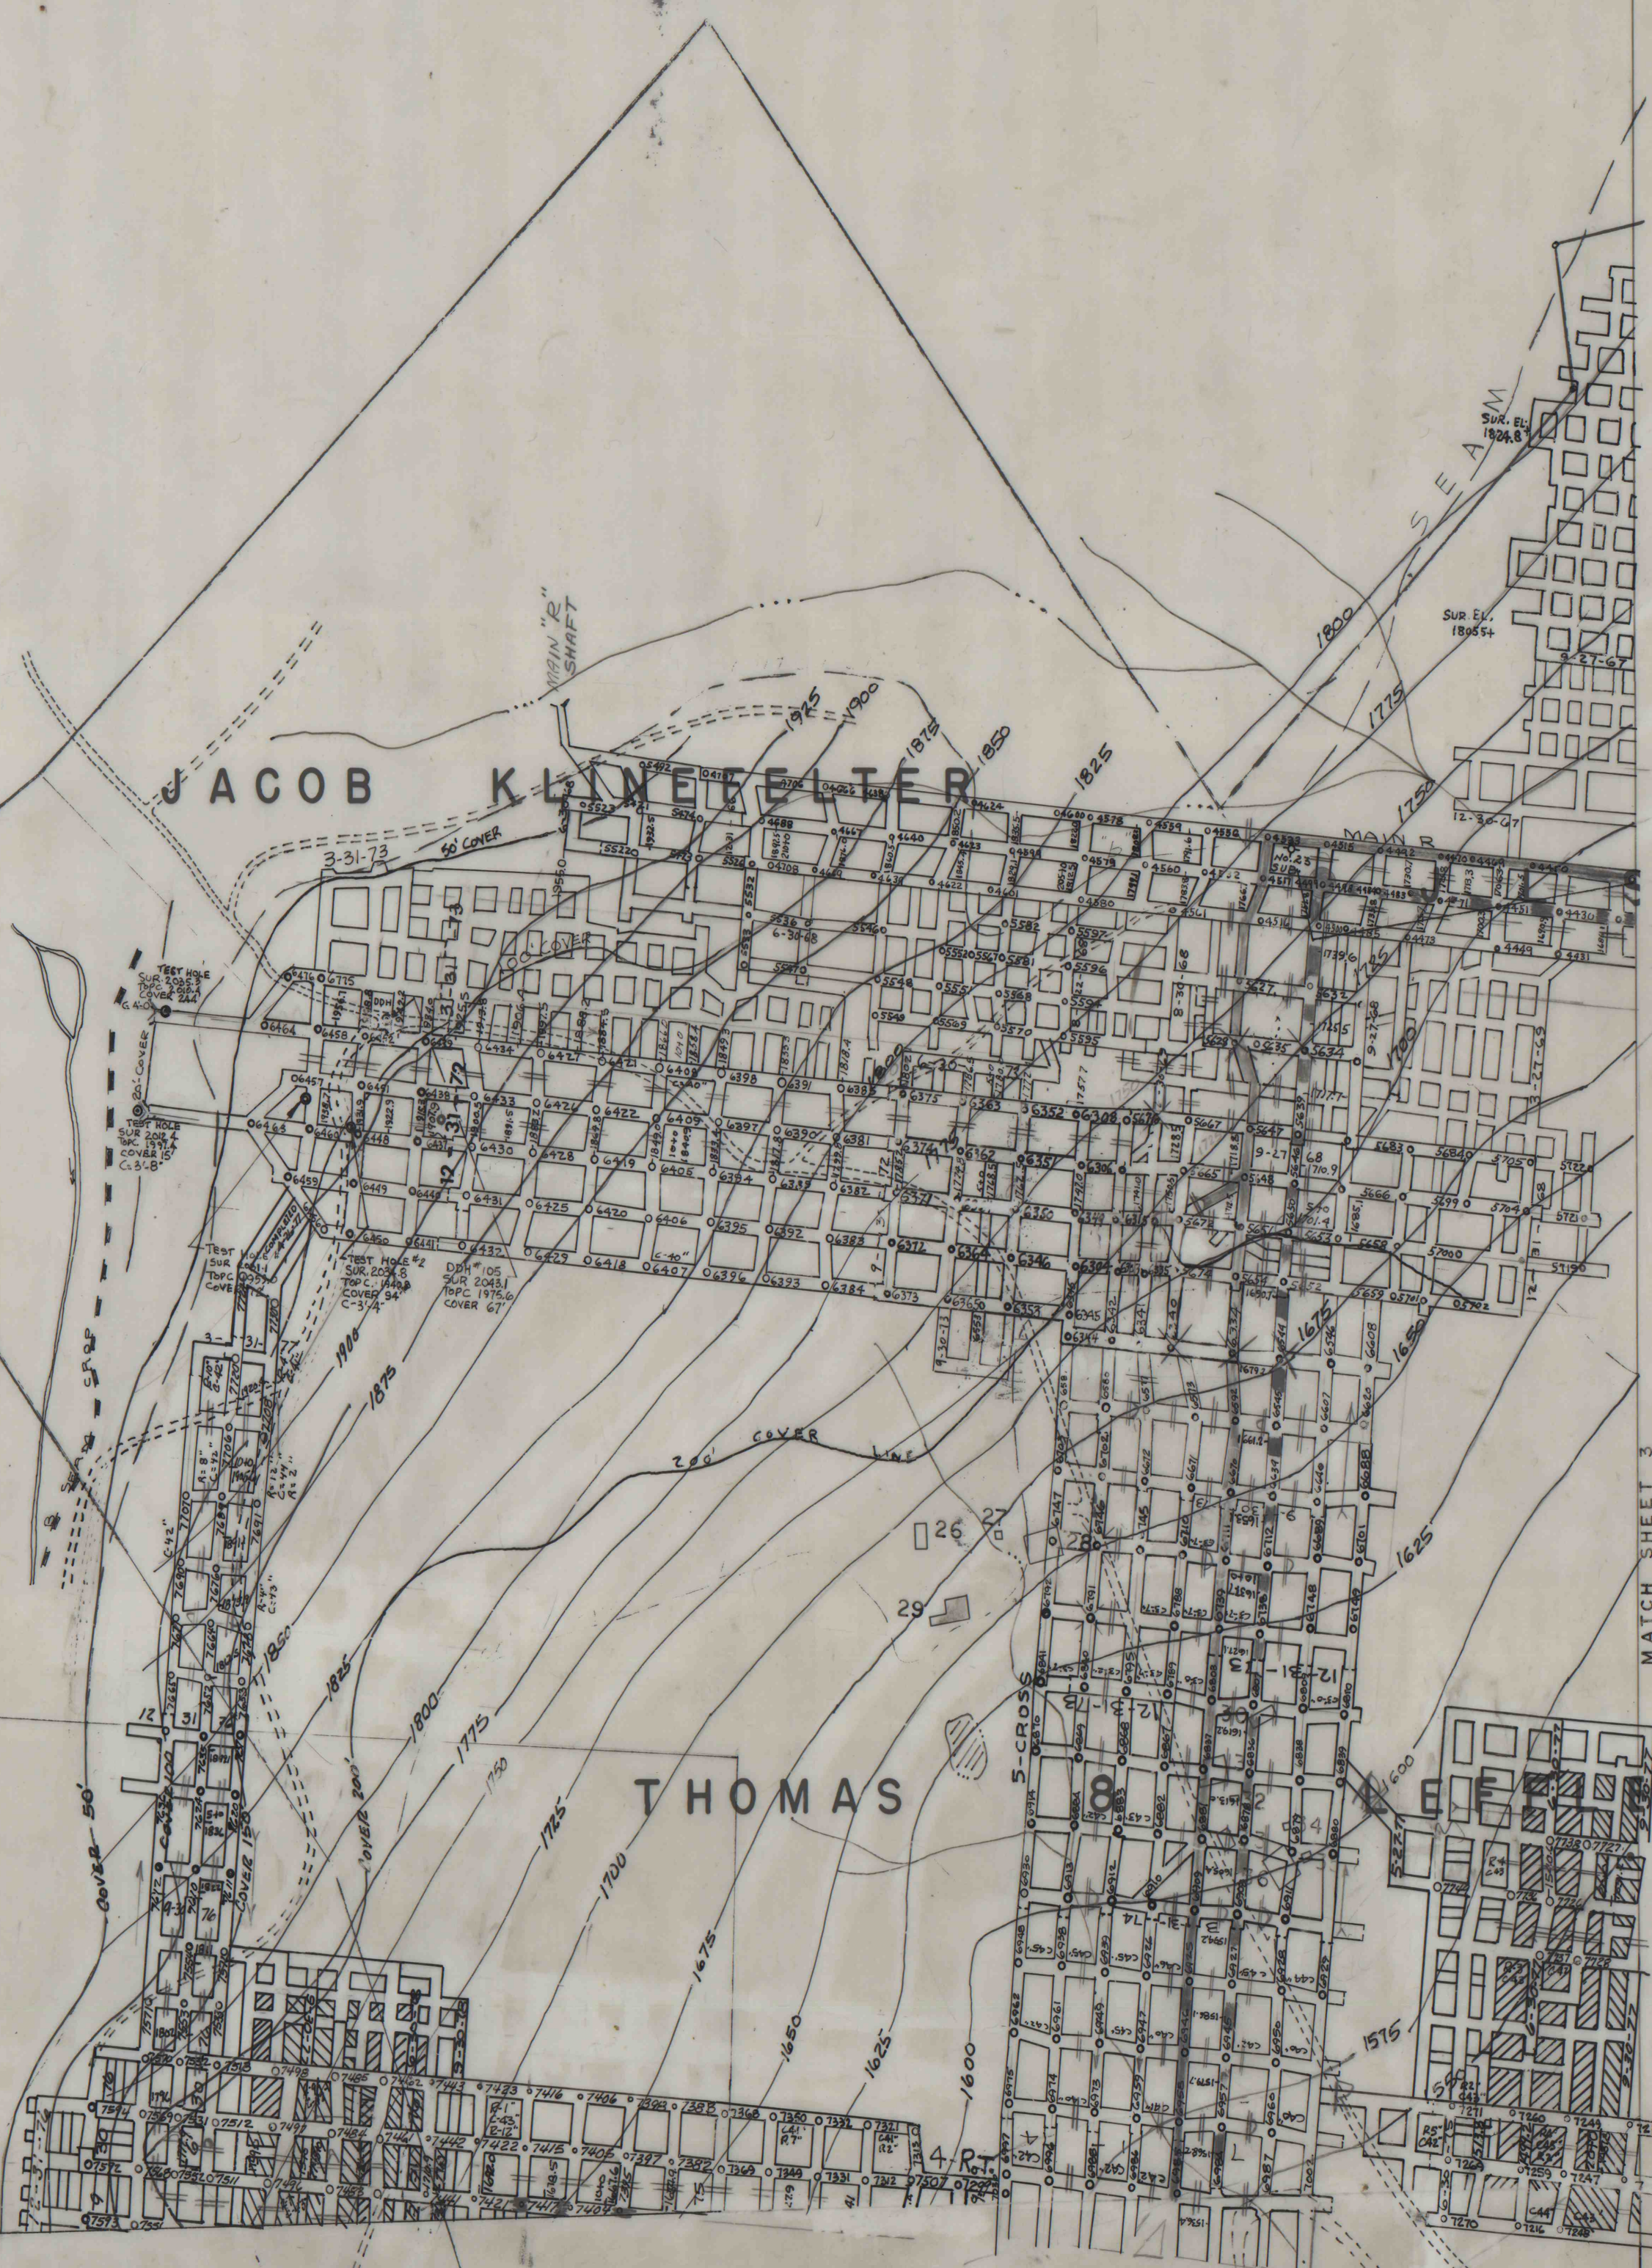

MINING COMPLETED

MINING COMPLETED

MATCH SHEET 3