


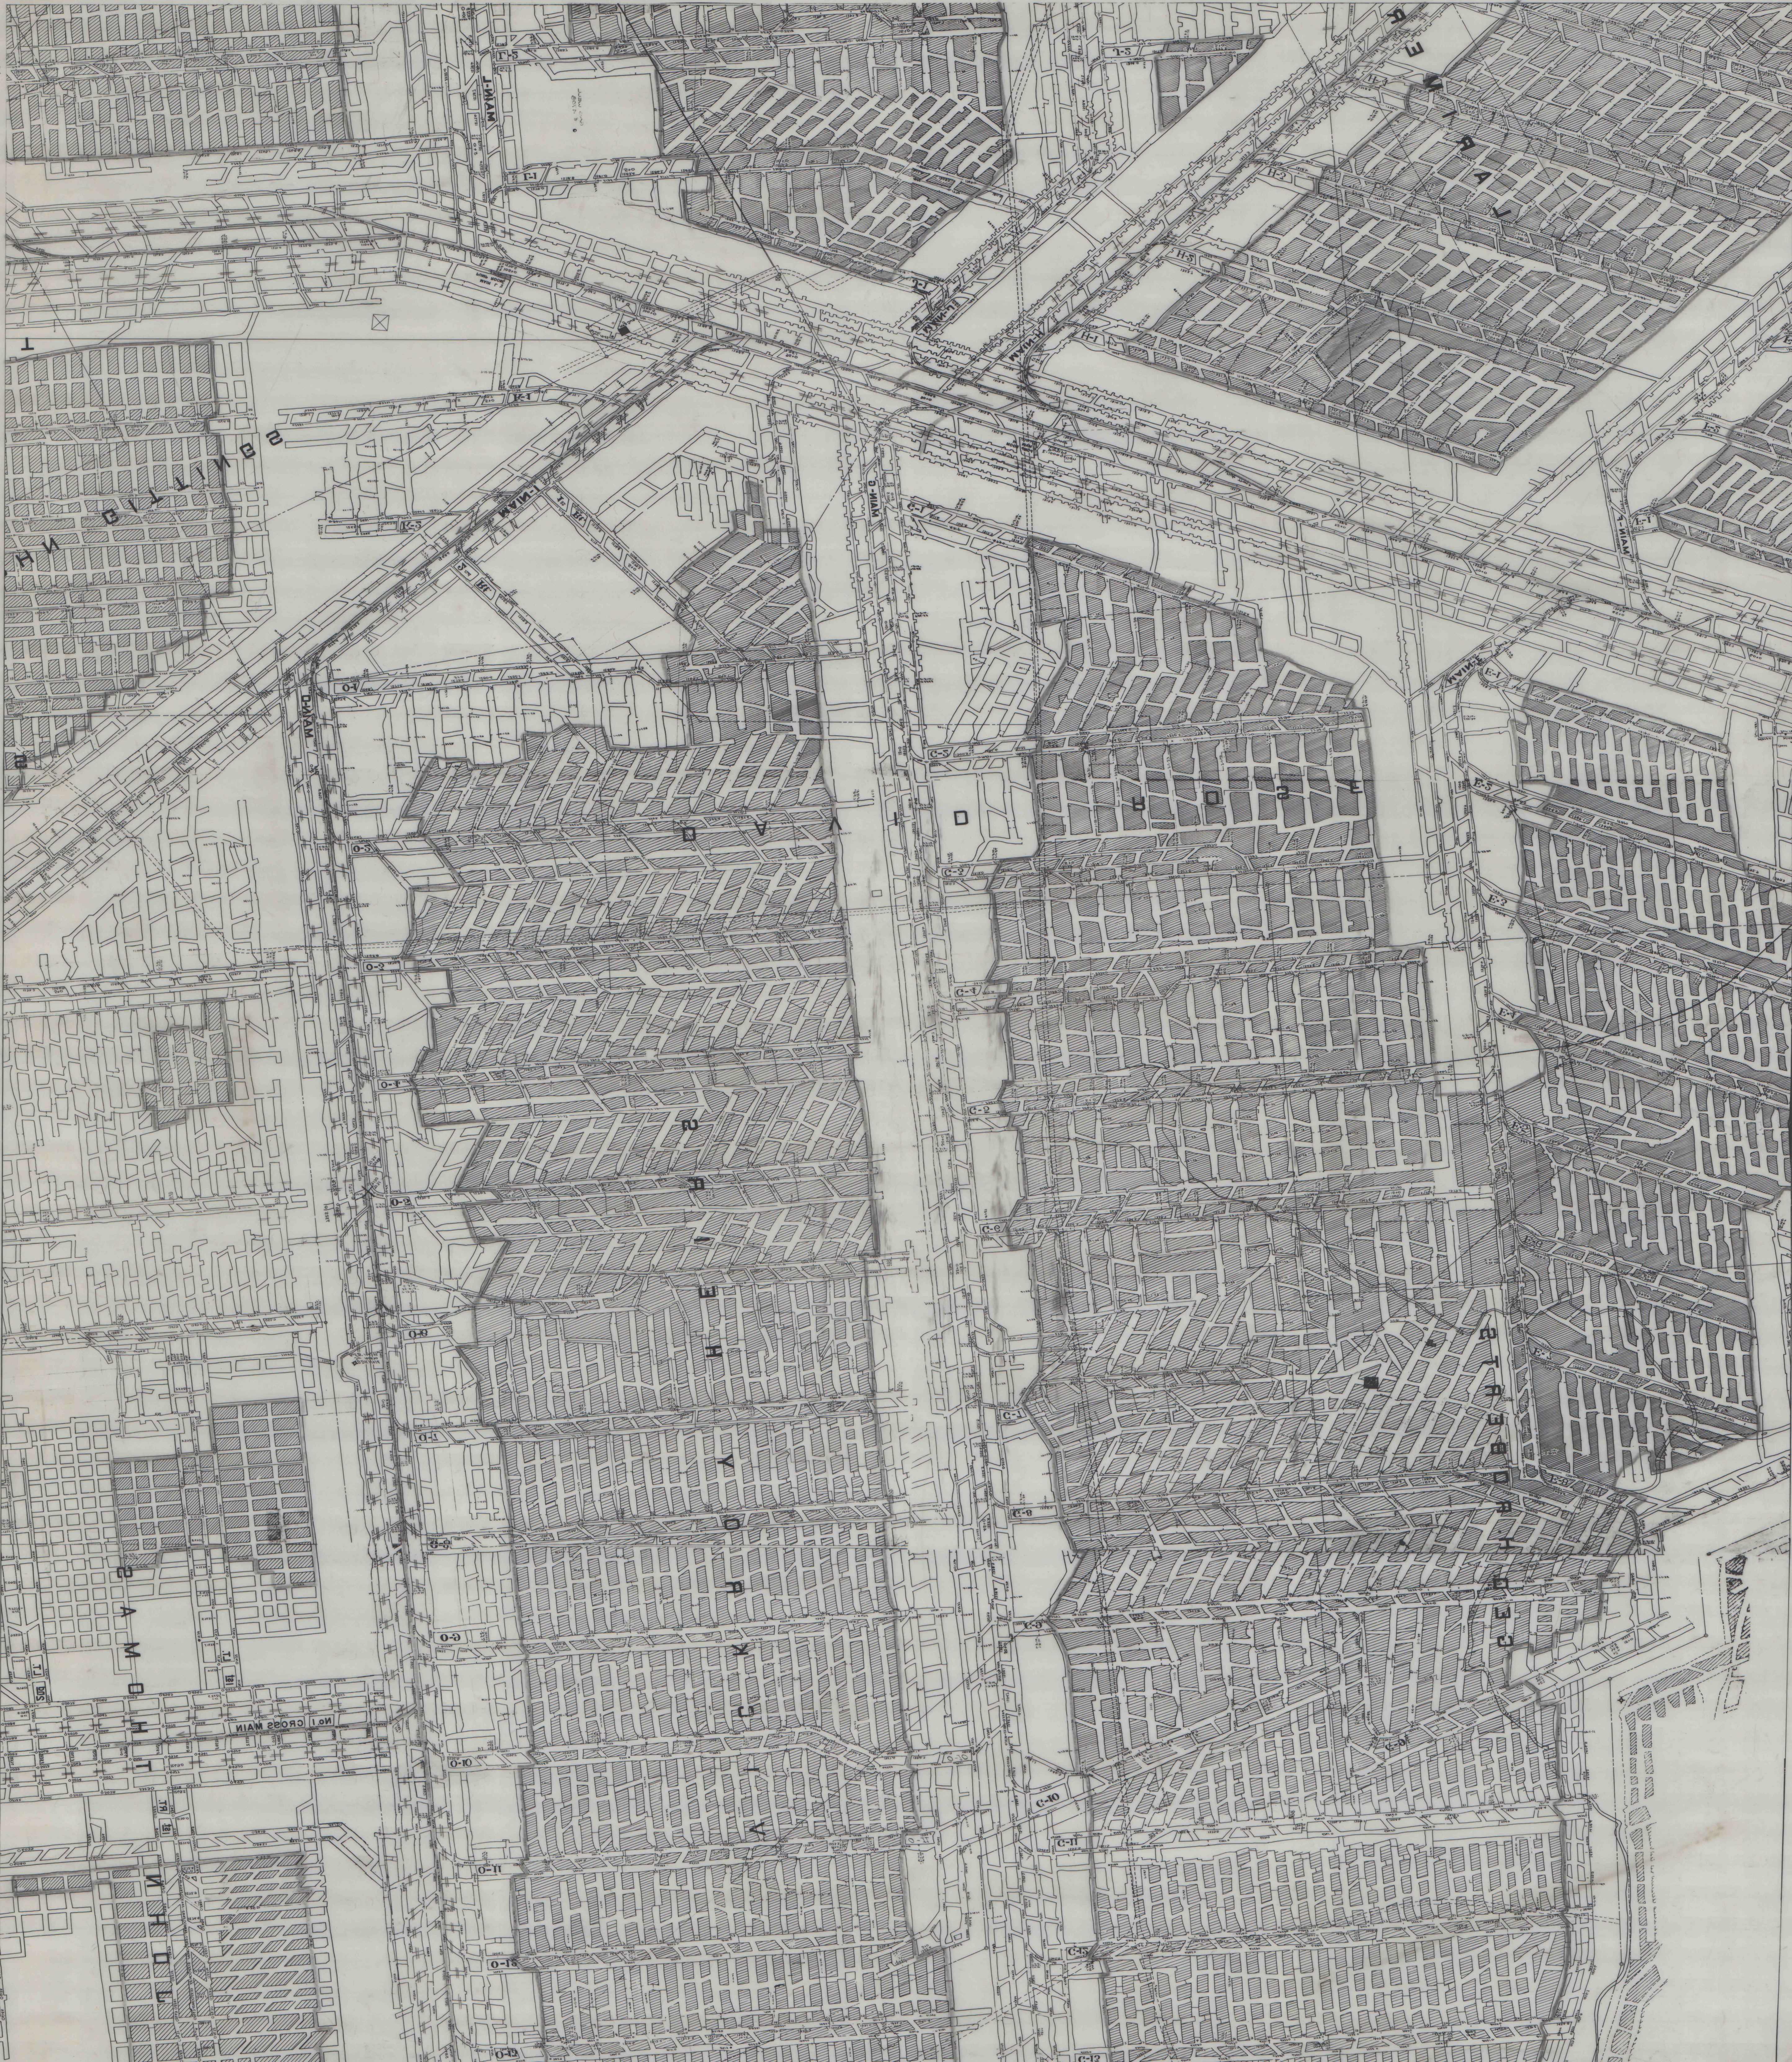

01. H2 H2TAM

SI. H2 H2TAM