


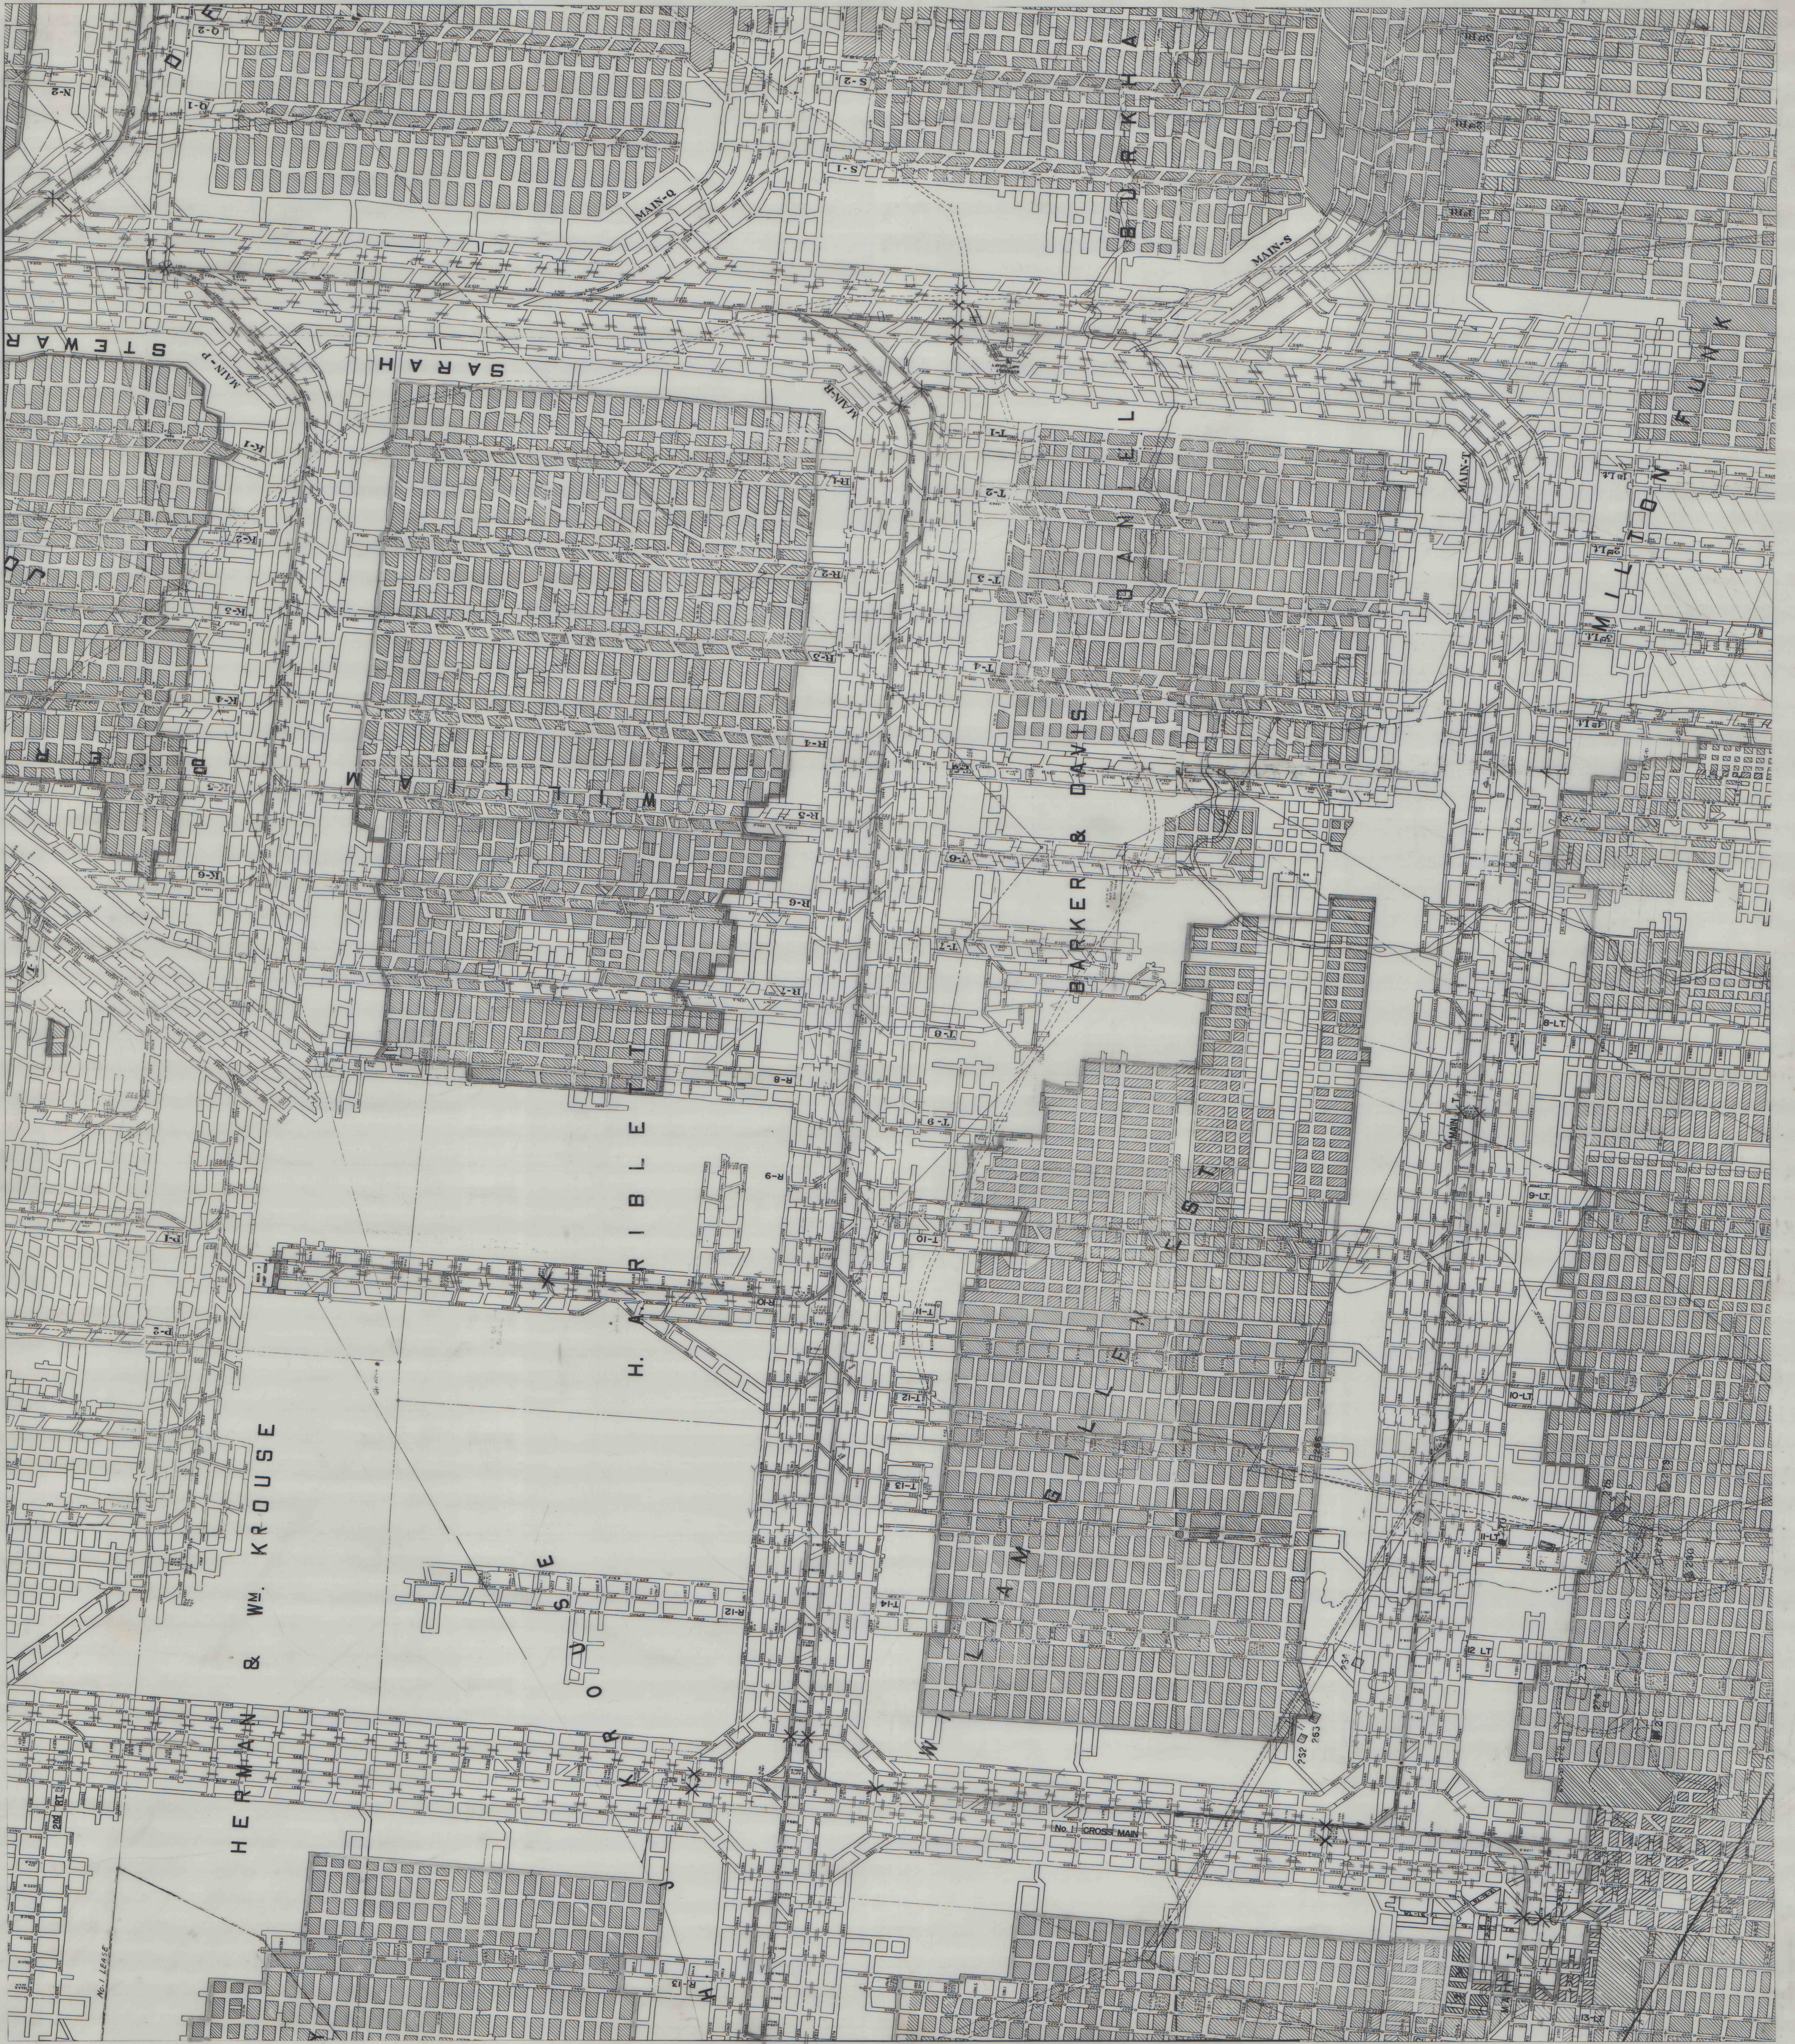

MATCH SH. 11

MATCH SH. 8