


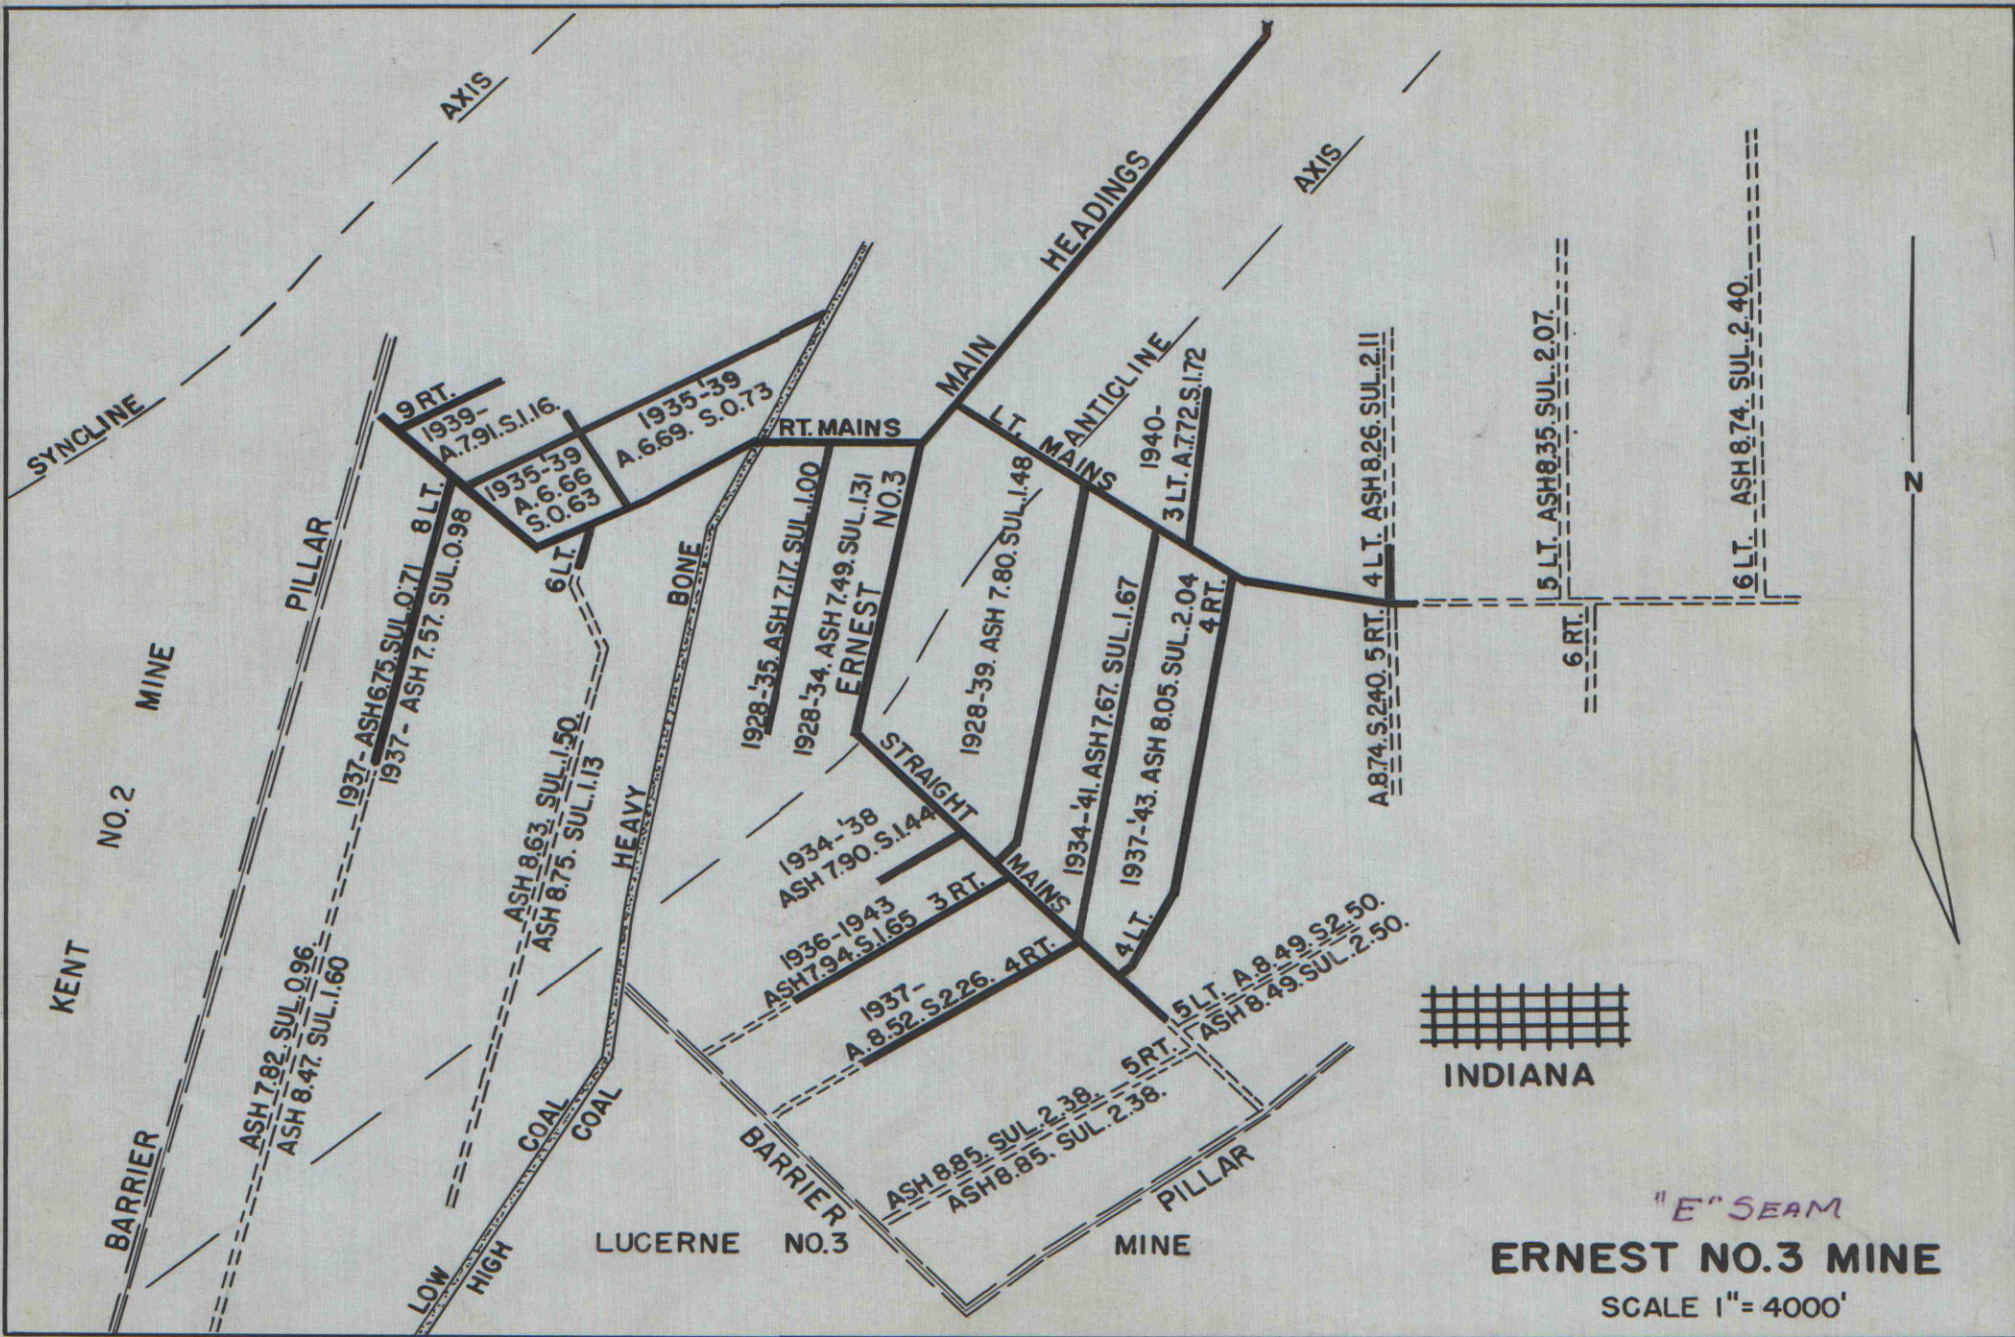

12.155-97