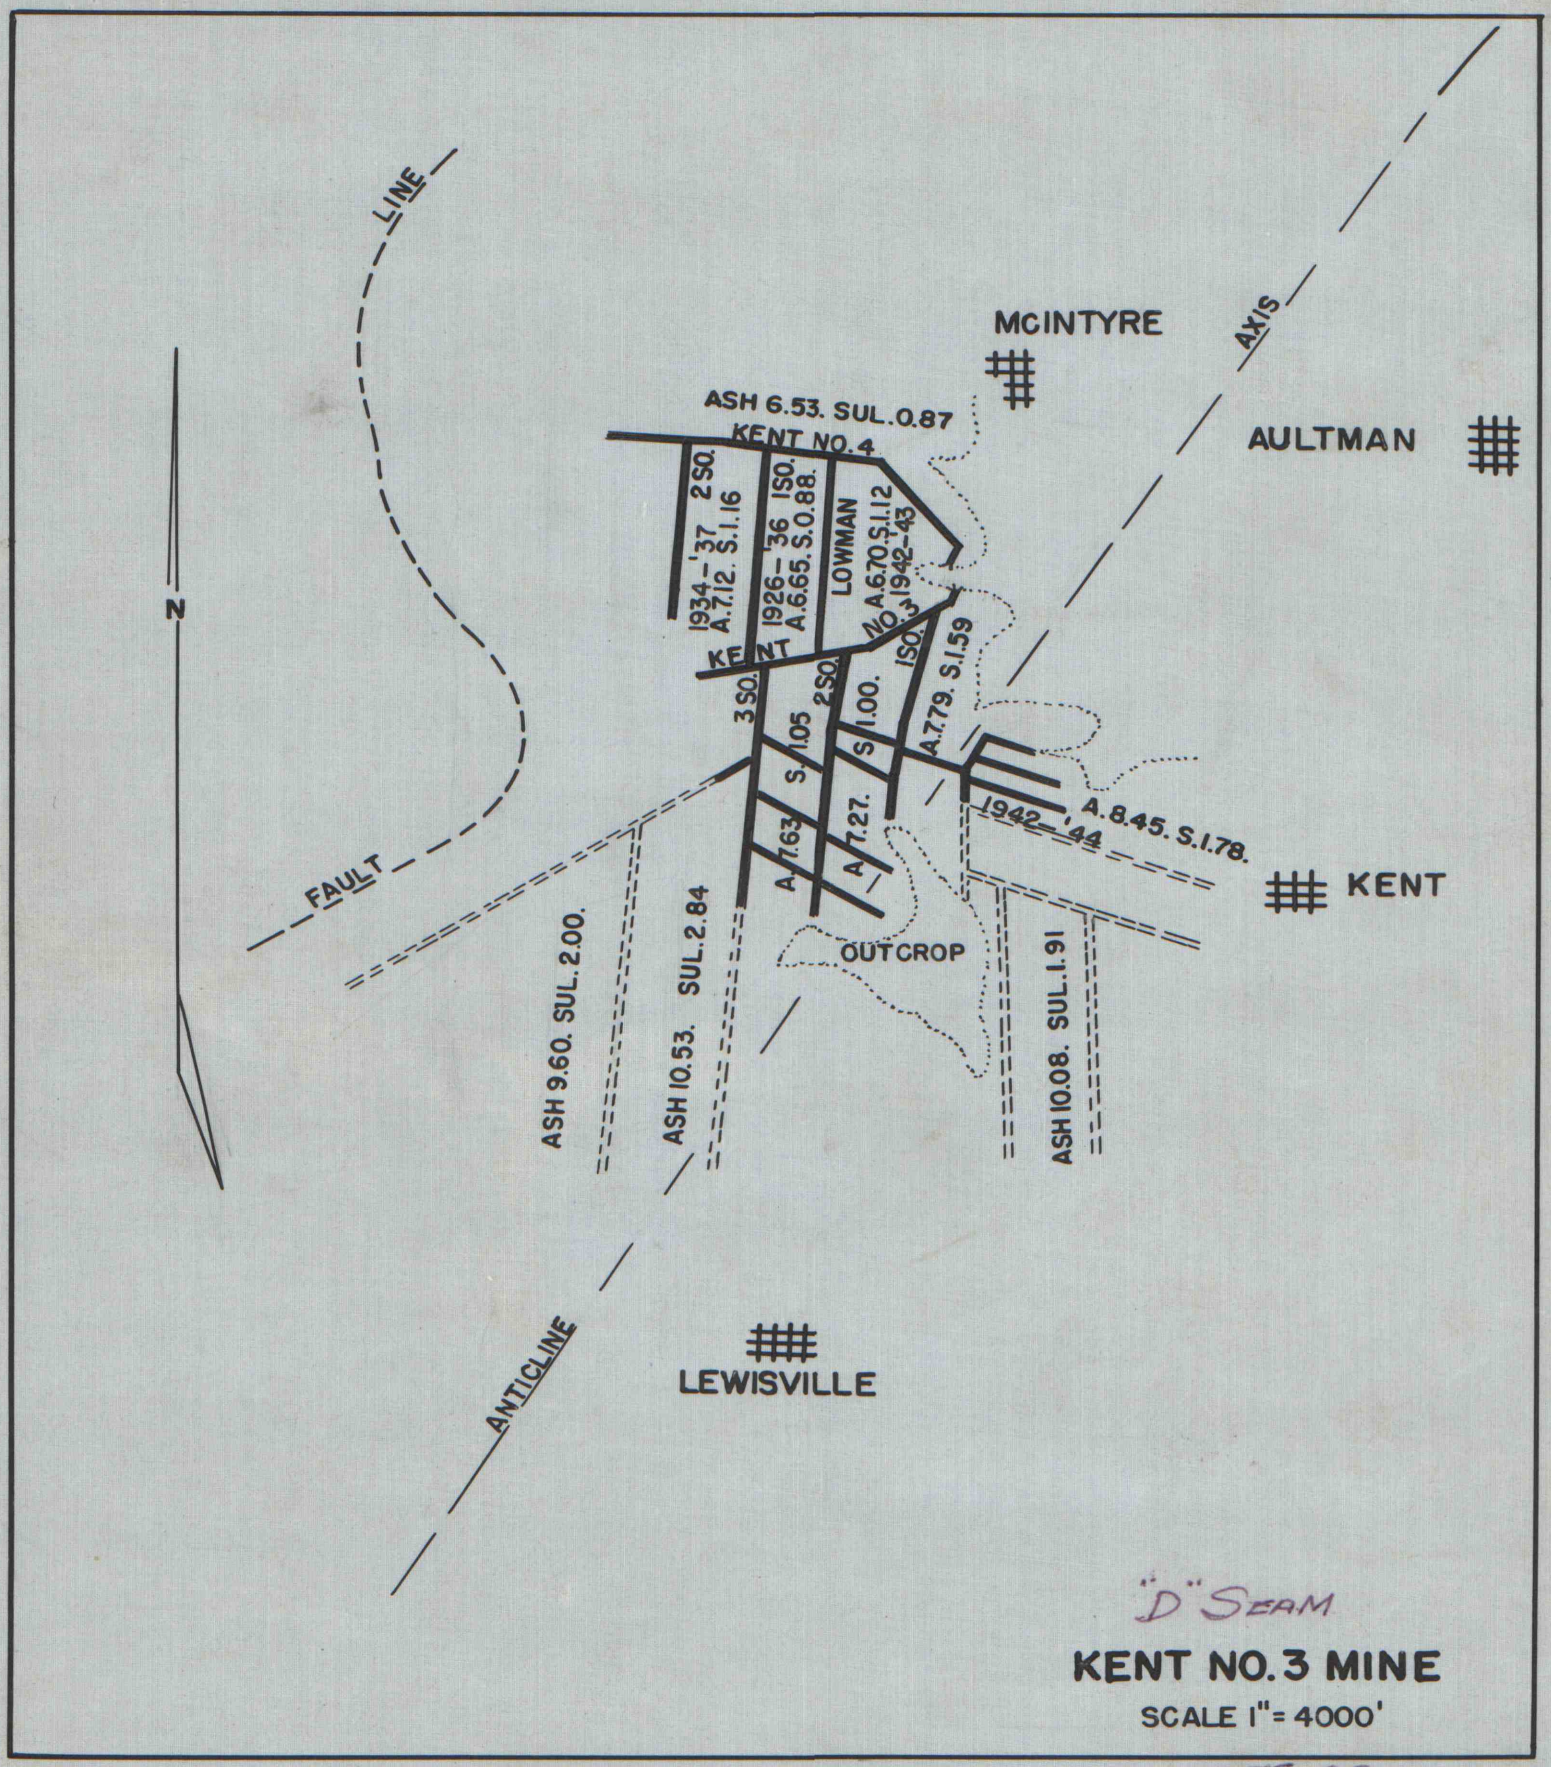

"D" SEAM

KENT NO. 3 MINE

SCALE 1" = 4000'

12155-97