


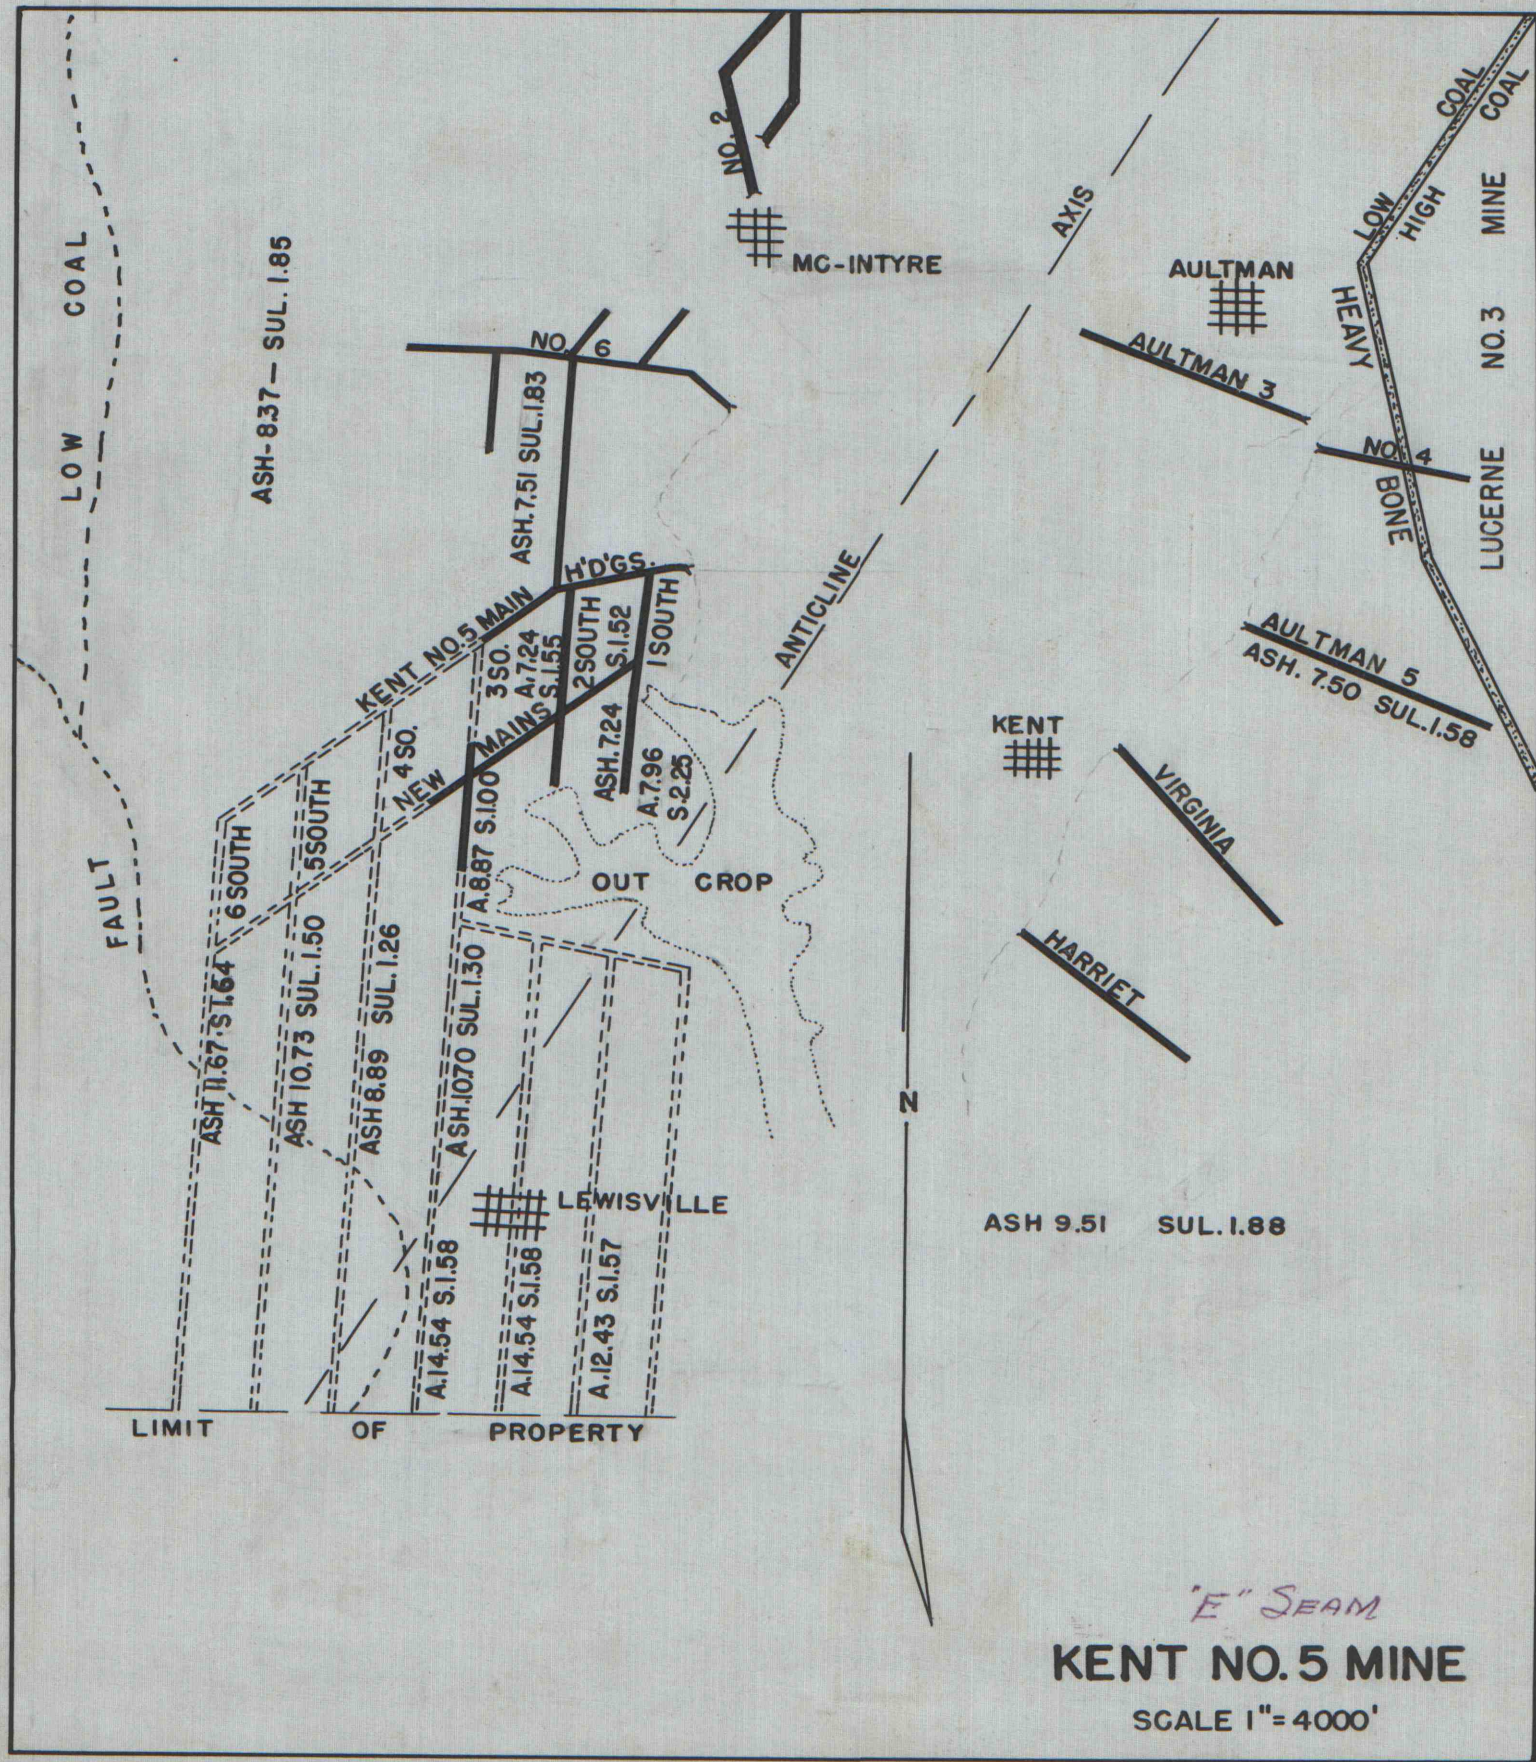

"E" SEAM
KENT NO. 5 MINE
SCALE 1" = 4000'

12155-97