


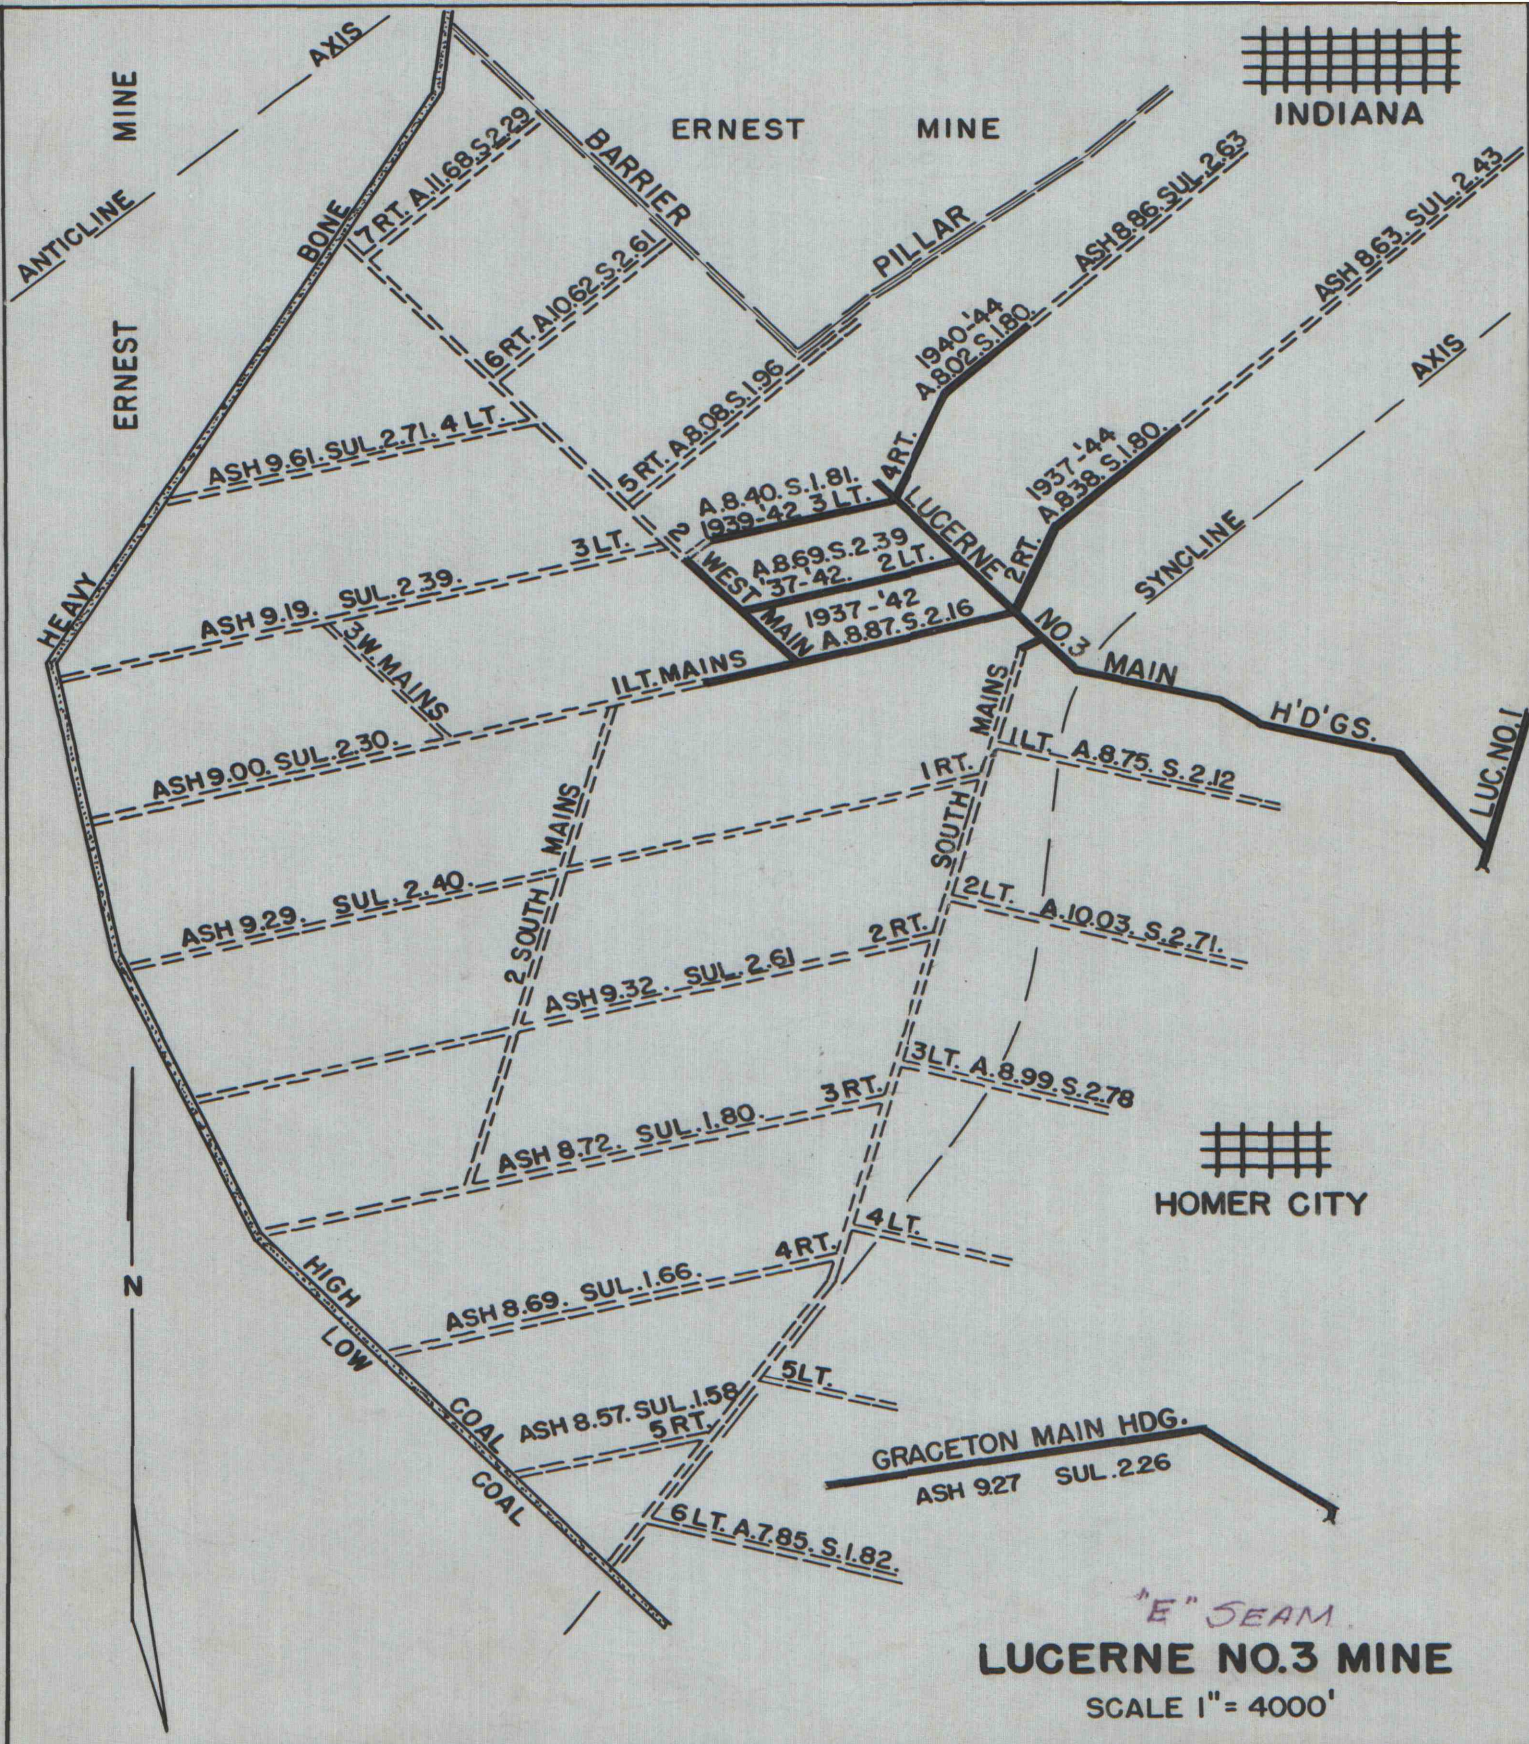

"E" SEAM

LUCERNE NO. 3 MINE

SCALE 1" = 4000'

12155-97