


10825-97

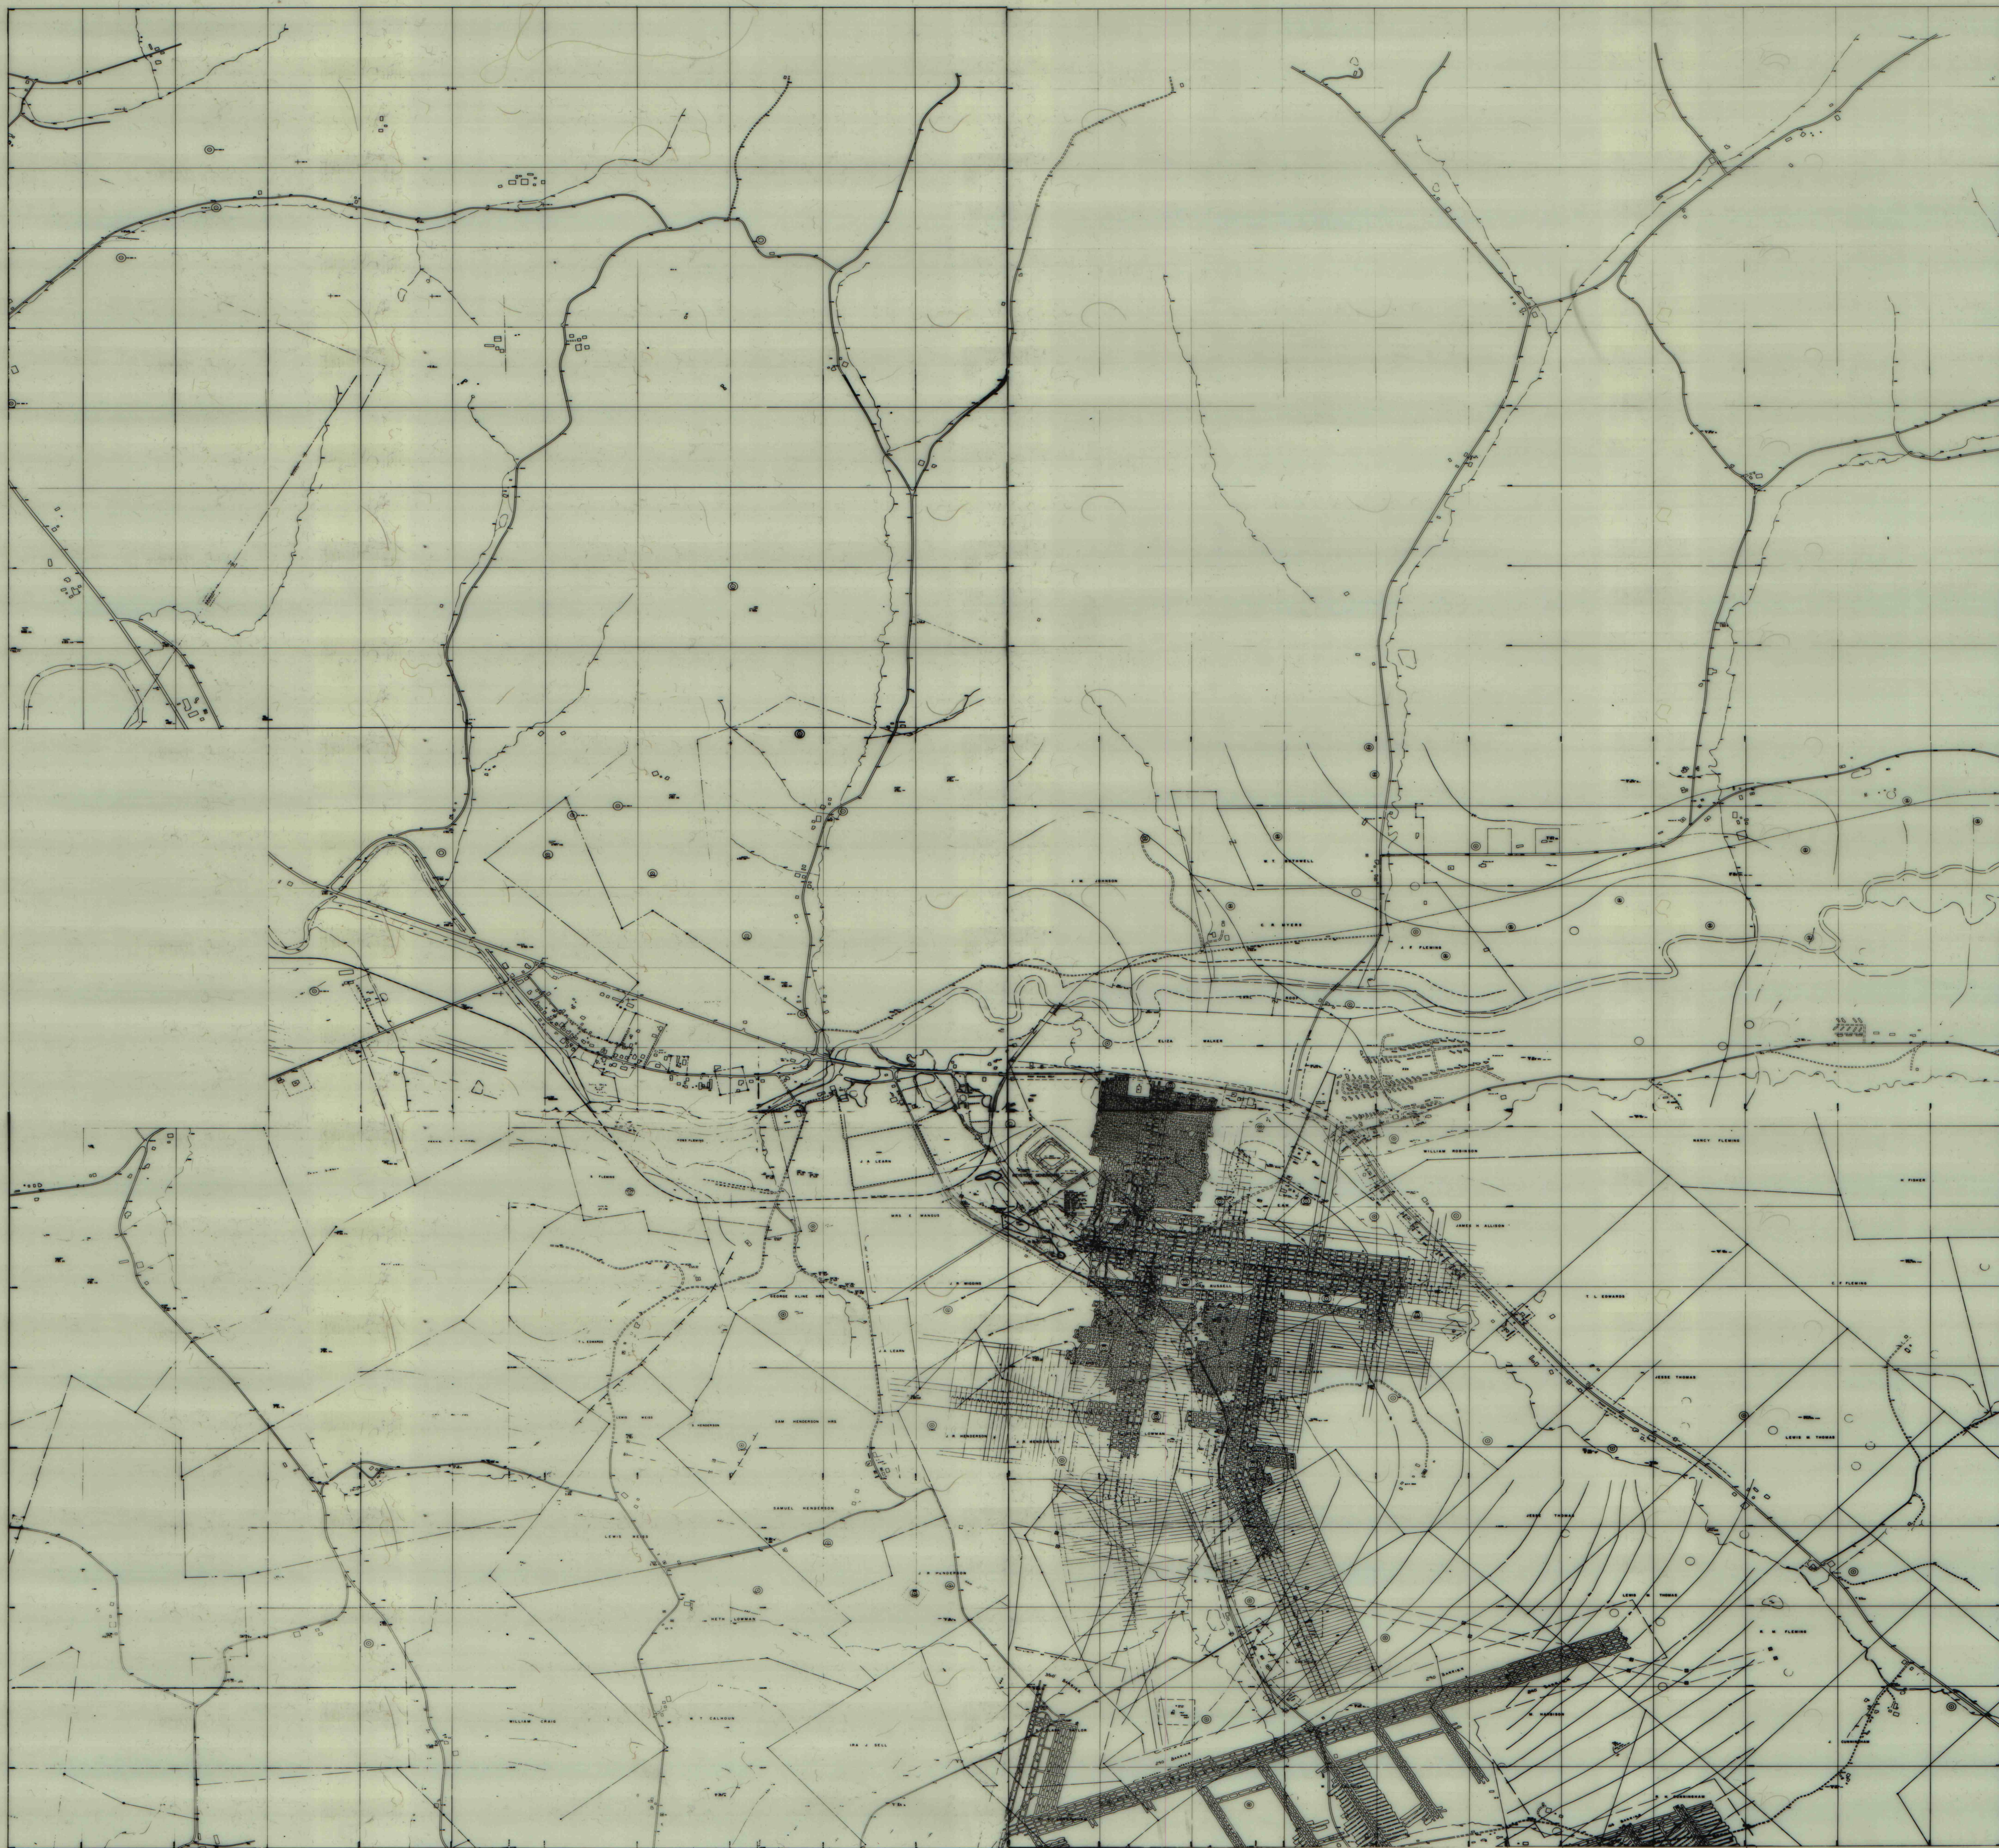

URLING NO. 2 MINE
UPPER FREEPORT "E" SEAM

10825-97