12531-97

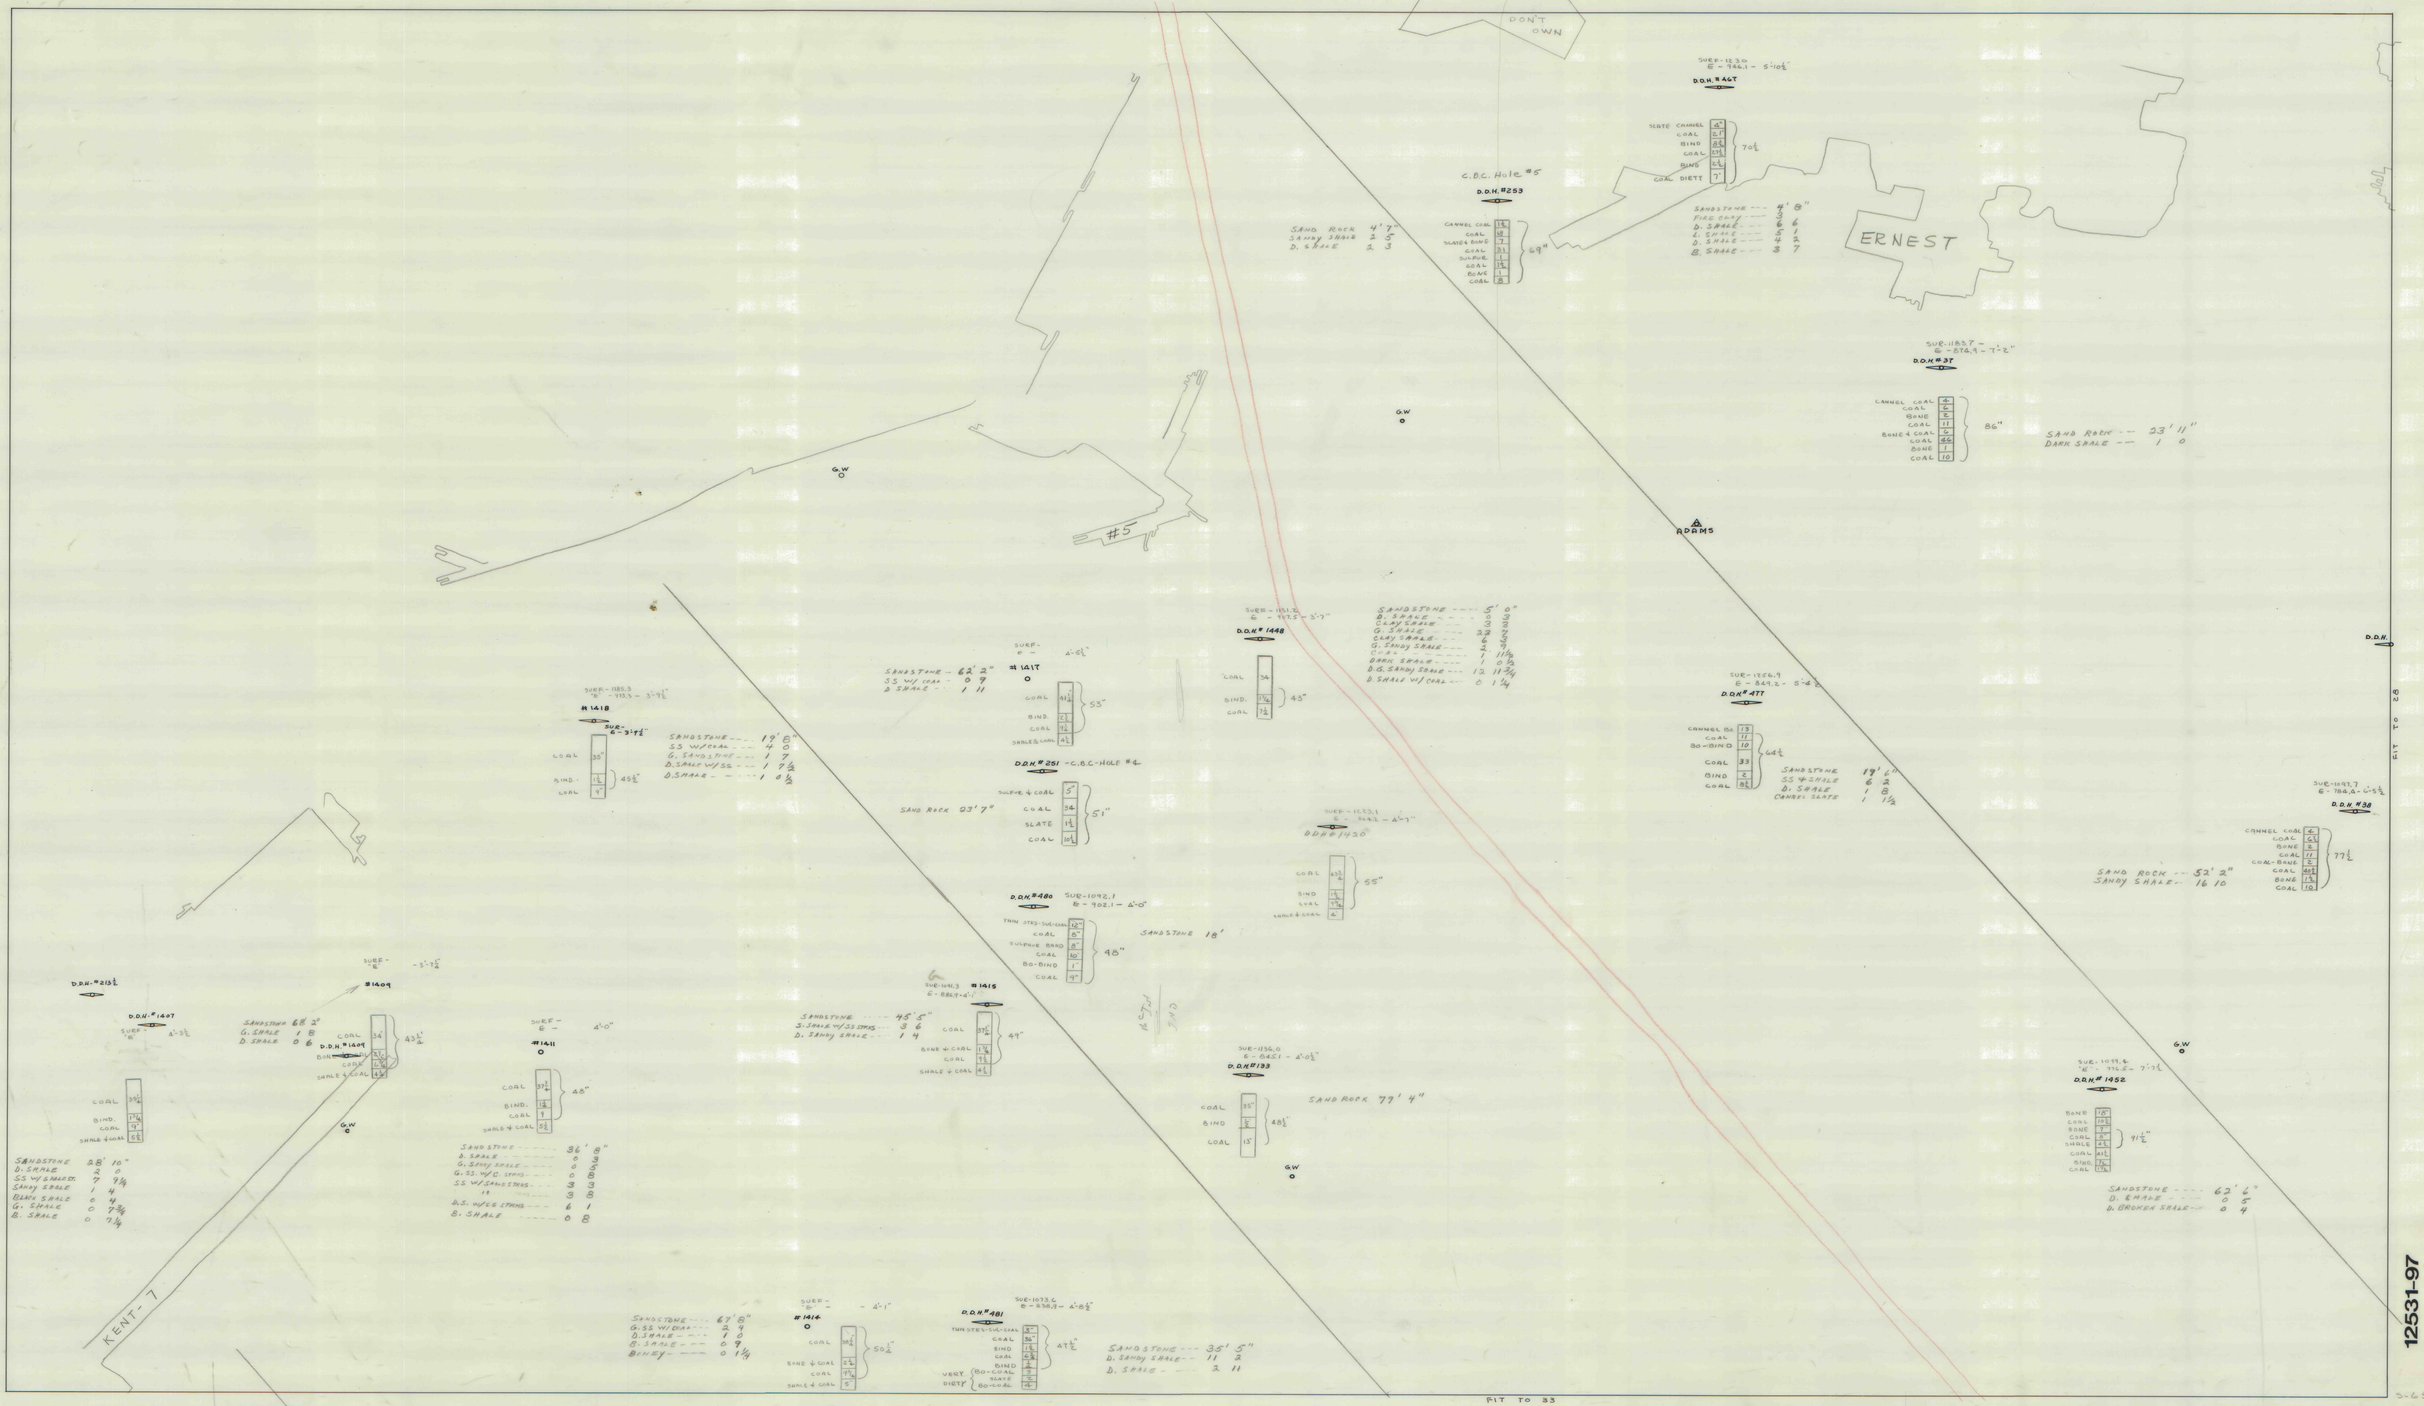

12531-97

PENN NO. 1 "E" SEAM COAL HEIGHT CONTOURS 27

LUC 76

REV- 6-25-67