


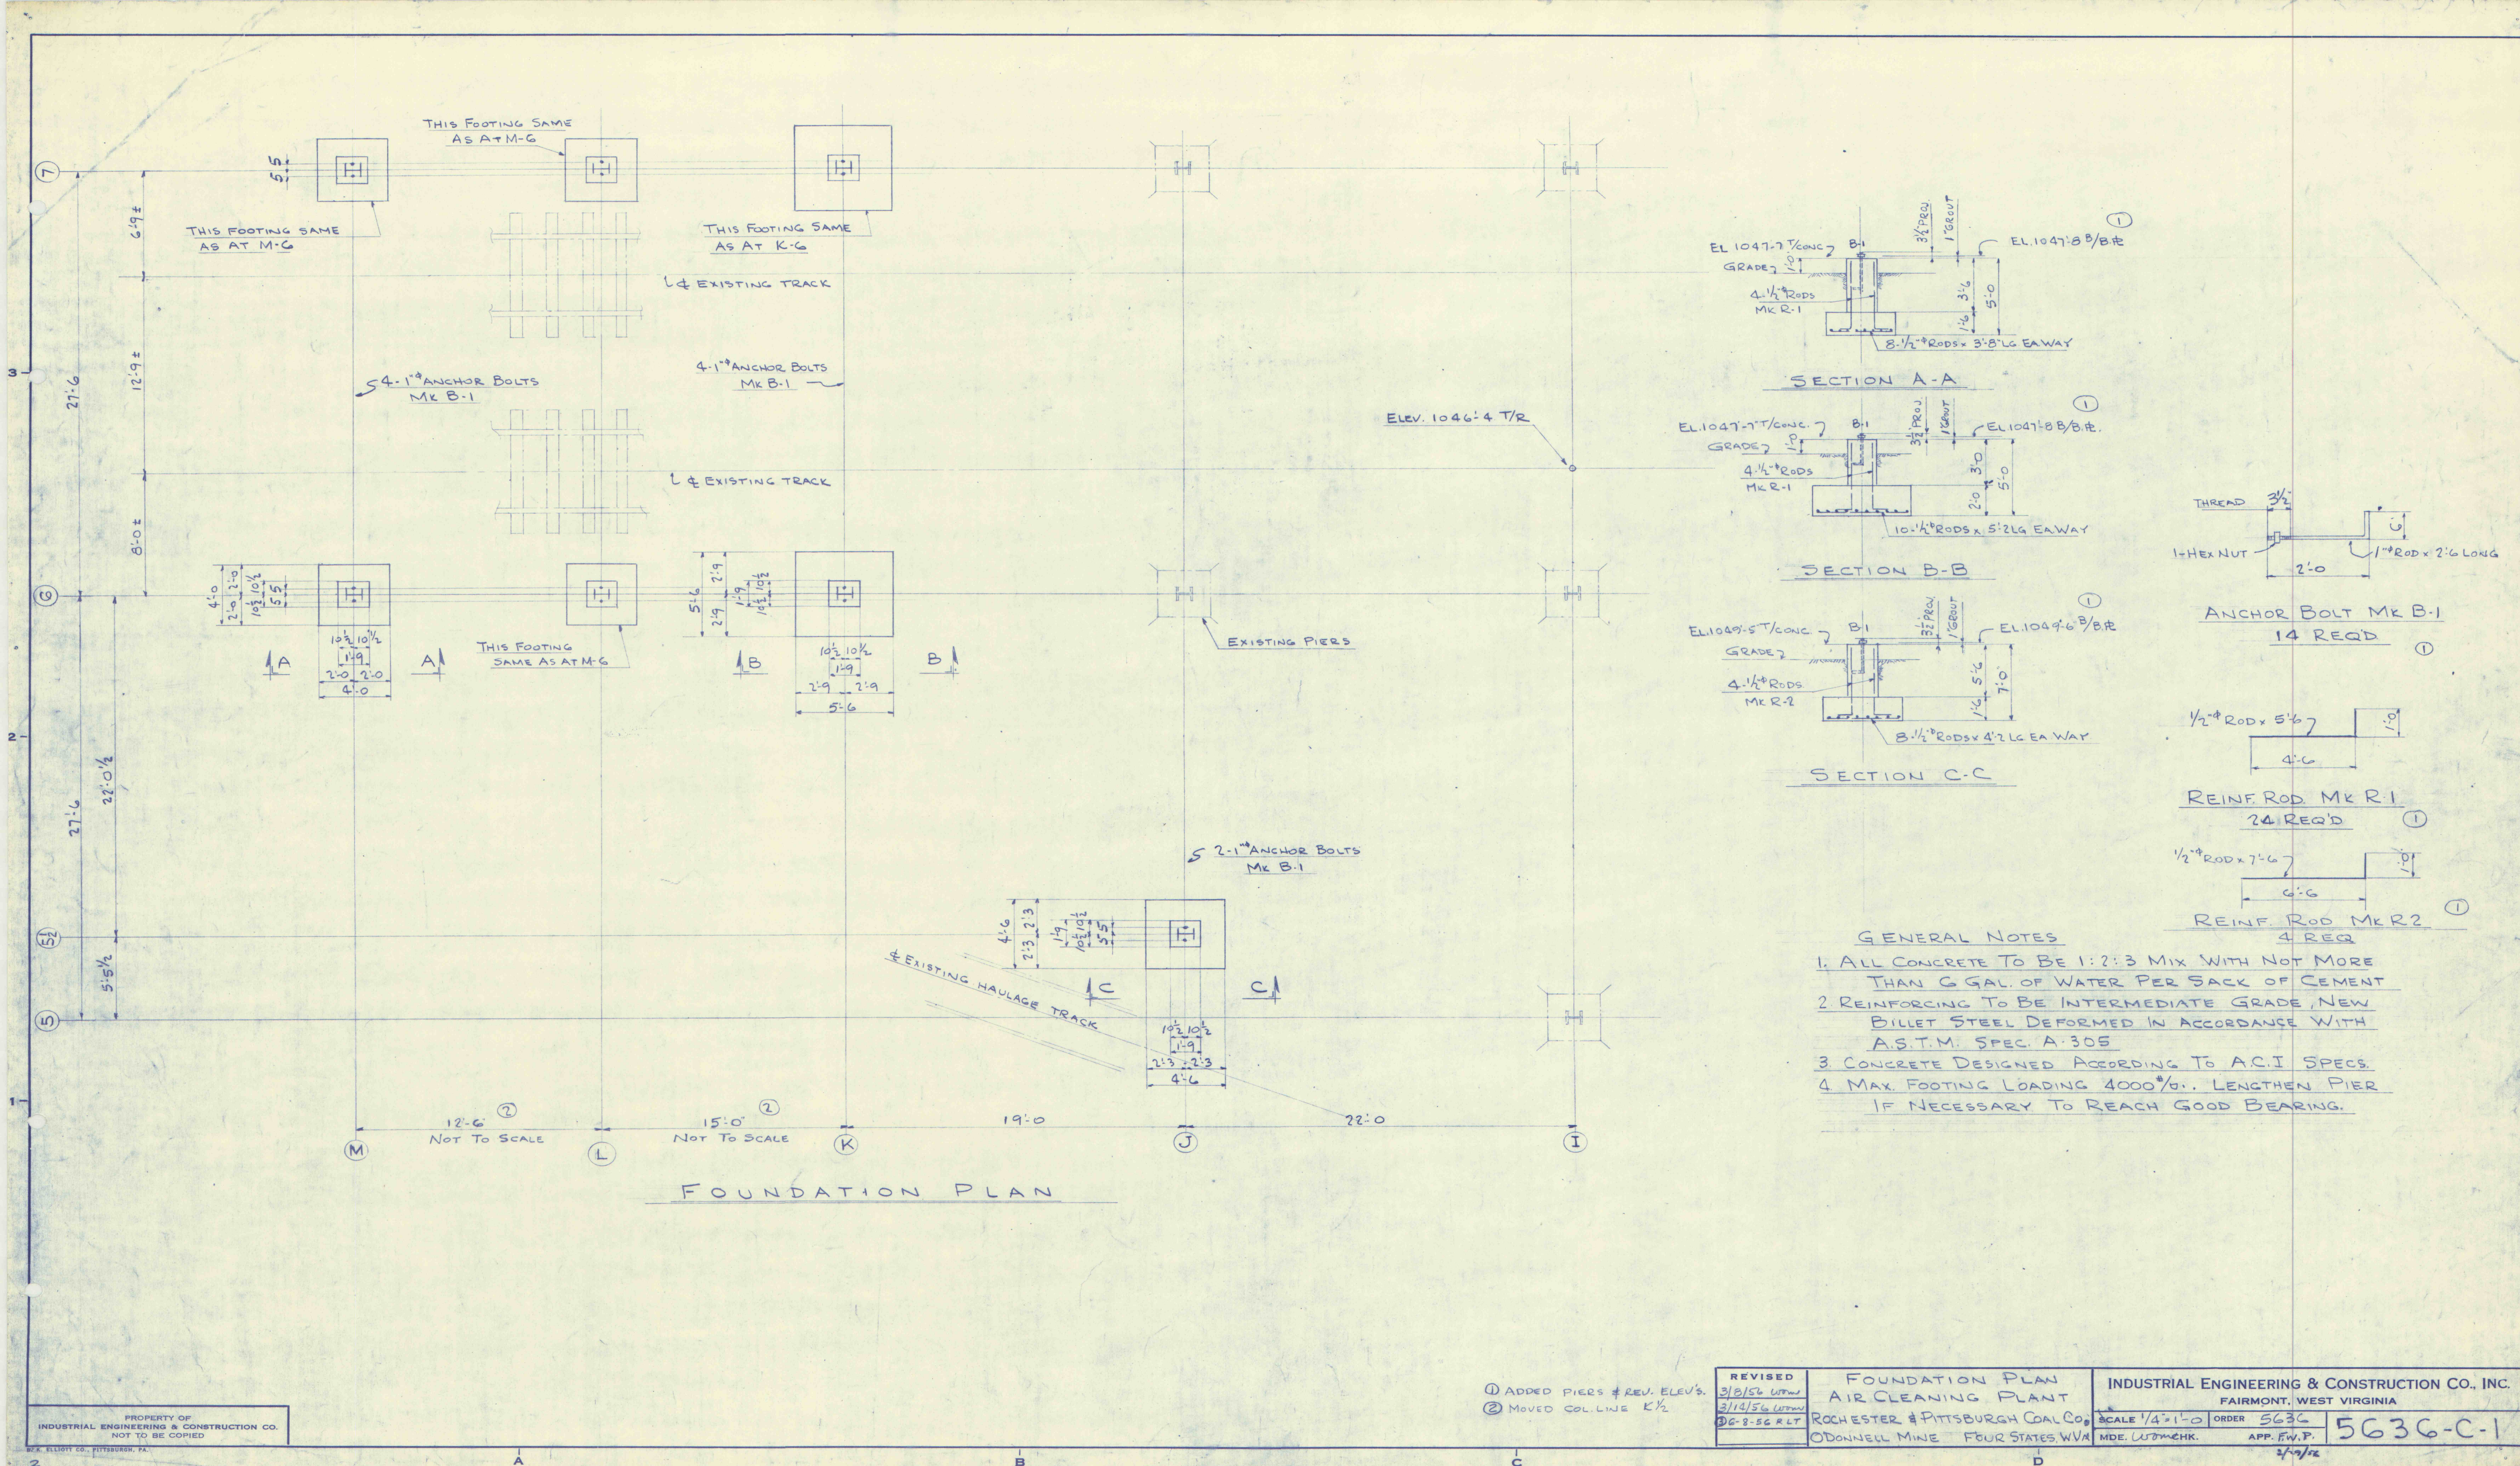

PROPERTY OF
INDUSTRIAL ENGINEERING & CONSTRUCTION CO.
NOT TO BE COPIED

① ADDED PIERS & REV. ELEV'S.
② MOVED COL. LINE K 1/2

REVISED 3/8/56 WPMW 3/14/56 WPMW 36-8-56 RLT	FOUNDATION PLAN AIR CLEANING PLANT ROCHESTER & PITTSBURGH COAL CO. ODONNELL MINE FOUR STATES, WVA	INDUSTRIAL ENGINEERING & CONSTRUCTION CO., INC. FAIRMONT, WEST VIRGINIA SCALE 1/4"=1'-0" ORDER 5636 MDE. WDMCHK. APP. FW.P. 5636-C-1
---	--	--