


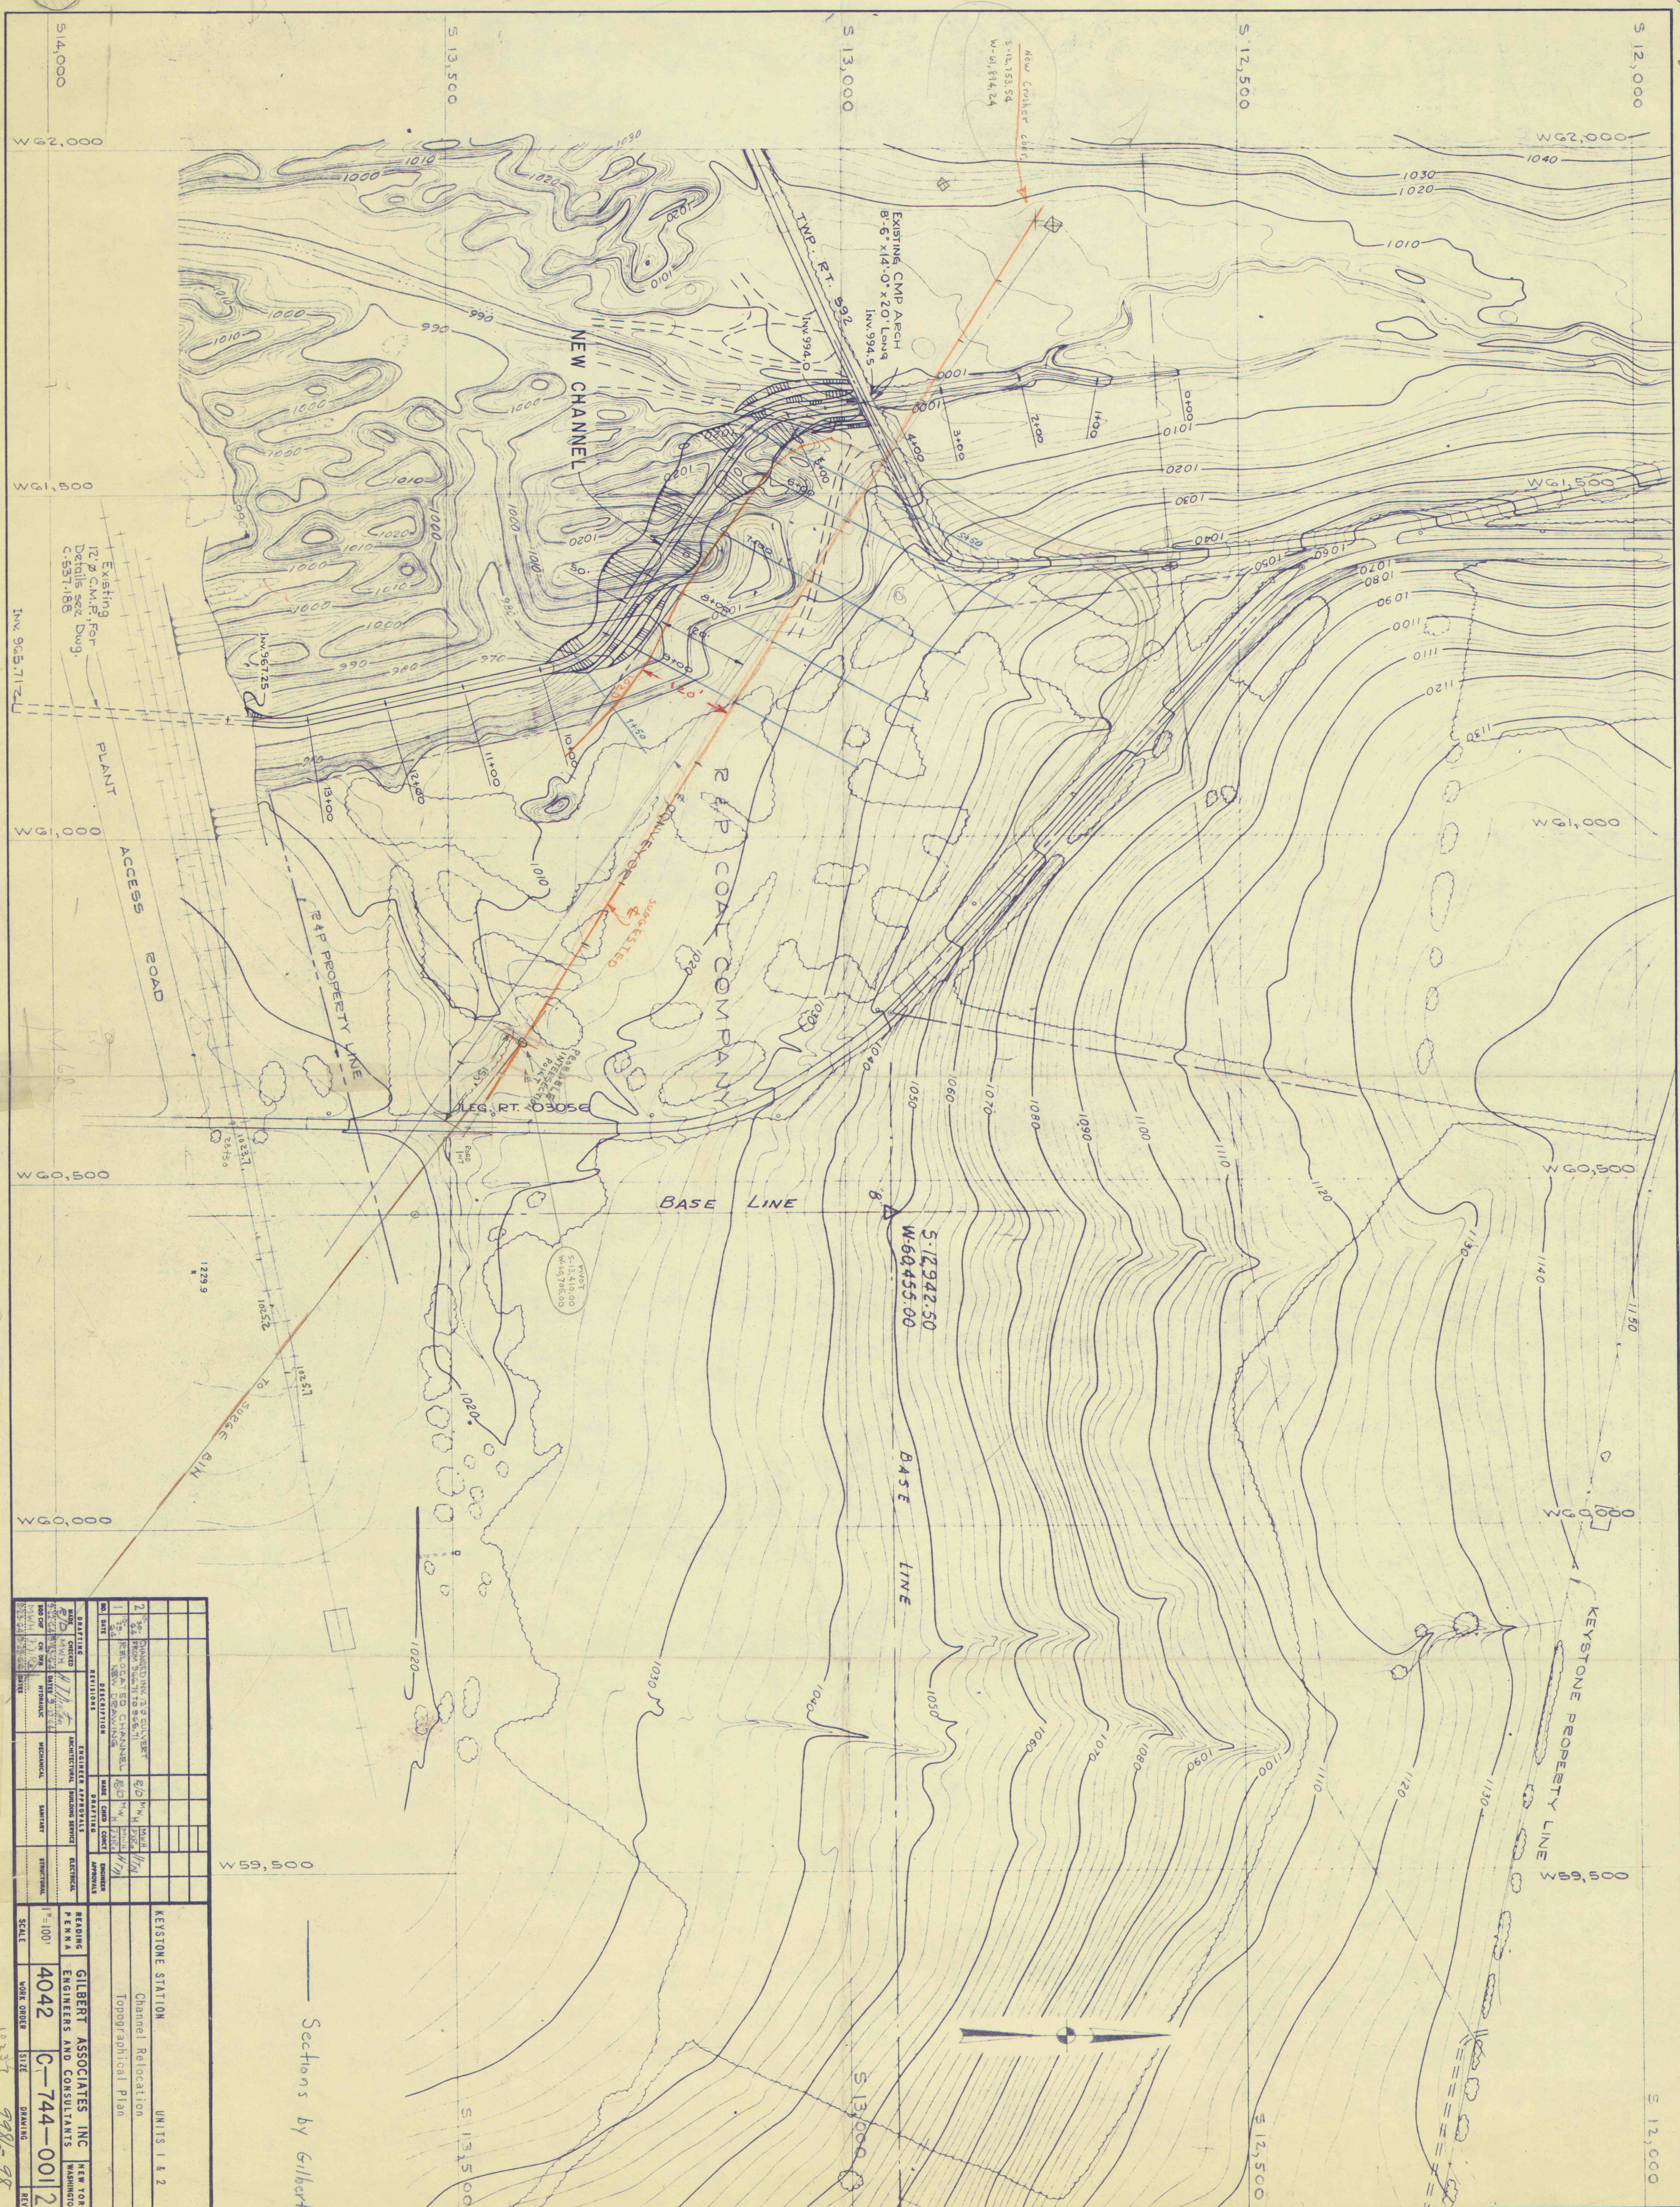

Sections by Gilbert

REVISIONS		PROJECT APPROVALS		READING	
NO.	DATE	BY	REVISIONS	DATE	BY
1	11/15/77	CH	RELOCATED CHANNEL	11/15/77	CH
2	12/15/77	CH	CHANGED TO 3.0 CULVERT	12/15/77	CH
3	12/15/77	CH	FROM 3.0 TO 3.5	12/15/77	CH
