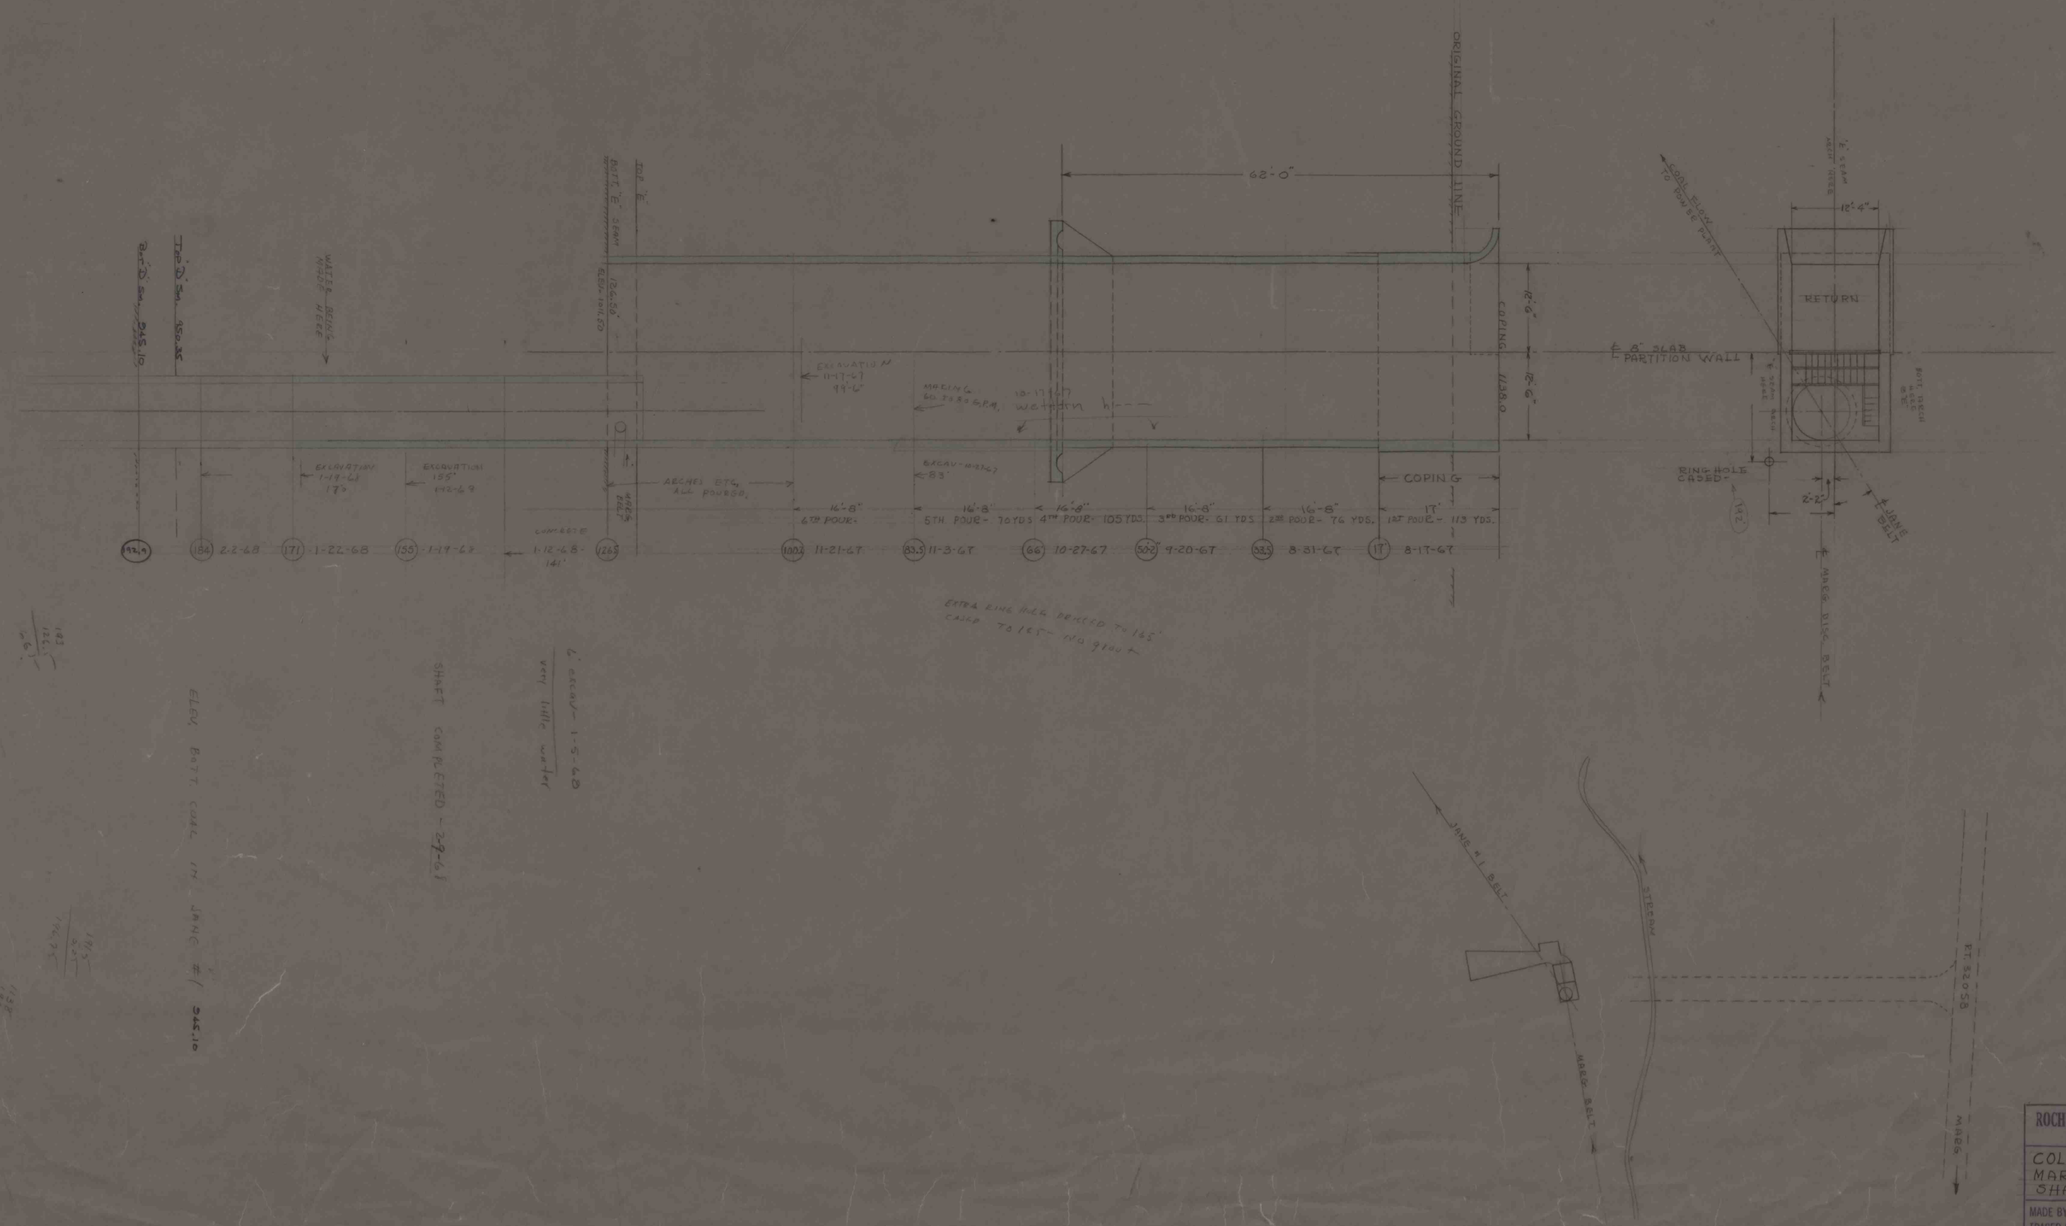
ORIGINAL GROUND LINE
62'-0"
COPING
COPING
PARTITION WALL
RETURN
12'-4"
RING HOLE CASED
JANE BELT
MARG. BELT
STREAM
JANE #1 BELT
MARG. BELT
EXCAVATION 1-19-68 17'
EXCAVATION 155' 1-12-69
ARCHES ETC. ALL POURED
CONCRETE 1-12-68 141'
EXCAVATION 11-17-67 99'-6"
MARING 60 TONS GRM.
EXCAVATION 83'
5TH POUR - 70 YDS
4TH POUR - 105 YDS
3RD POUR - 61 YDS
2ND POUR - 76 YDS.
1ST POUR - 113 YDS.
184 2-2-68
171 1-22-68
155 1-19-67
100 11-21-67
83.5 11-3-67
66 10-27-67
50.5 9-20-67
33.5 8-31-67
17 8-17-67
EXTRA LINE HOLE DRILLED TO 165' CASED TO 165' - NO GROUT
ELEV. BOTT. COAL IN JANE #1 345.10
SHAFT COMPLETED - 2-7-68
EXCAV. 1-5-68 VERY LITTLE WATER
ROCHESTER & PITTSBURGH COAL CO.
ENGINEERING DEPT., INDIANA, PA
COLUMNAR SECTION
MARGARET & JANE #1
SHAFT
MADE BY E.S.
TRACED BY S.H.Z.
SCALE 1" = 10'
DATE AUG. 1967
CHECKED BY
NO. 9704-99