


DETAIL OF PROPOSED TRIP MARKER

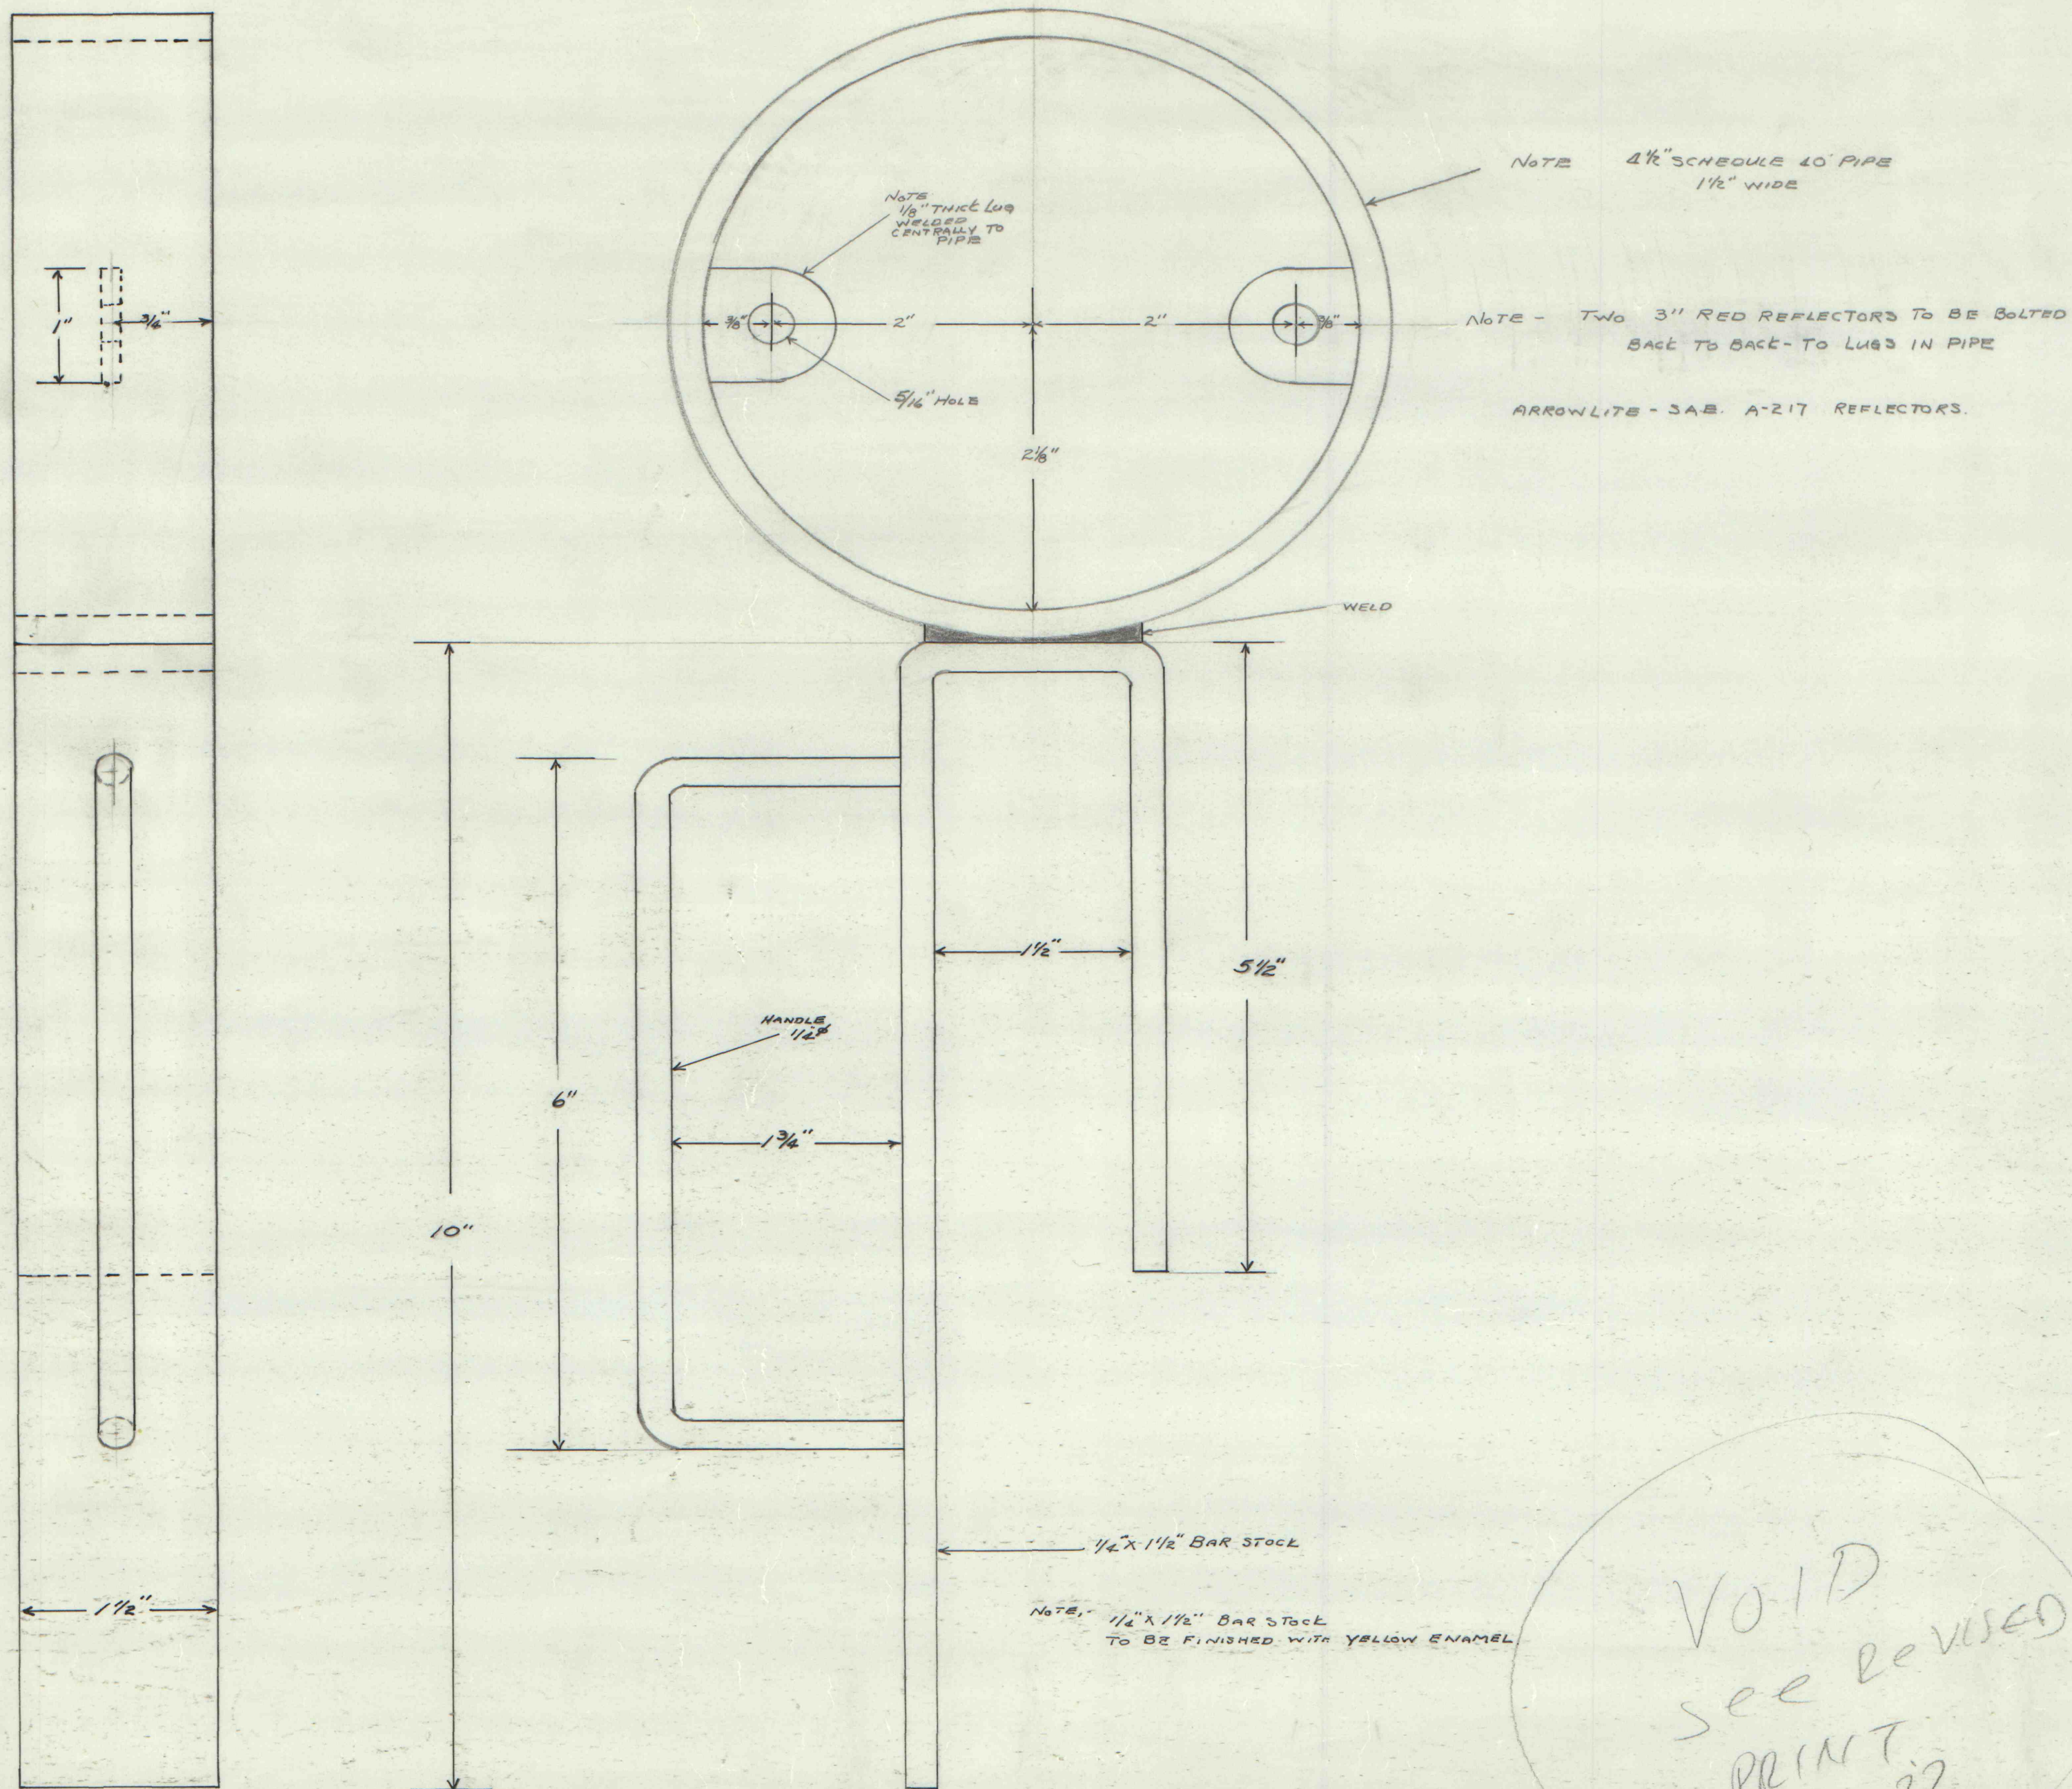

VOID
see revised
PRINT
DATED 1-77