


12667-101

GREENWICH COLLIERIES

- DIAMOND DRILL HOLE
 - ⊙ GAS WELL, E-LOG
 - × IN MINE COAL HEIGHT
 - Ⓜ RESERVED
 - Ⓜ/NOT CONTROLLED
 - Ⓜ "E" SEAM MINING
 - Ⓜ "D" SEAM MINING
 - Ⓜ "B" SEAM MINING
 - PROPERTY LINE
- N/D NOT DEEP ENOUGH

SCALE 1"=1,000'

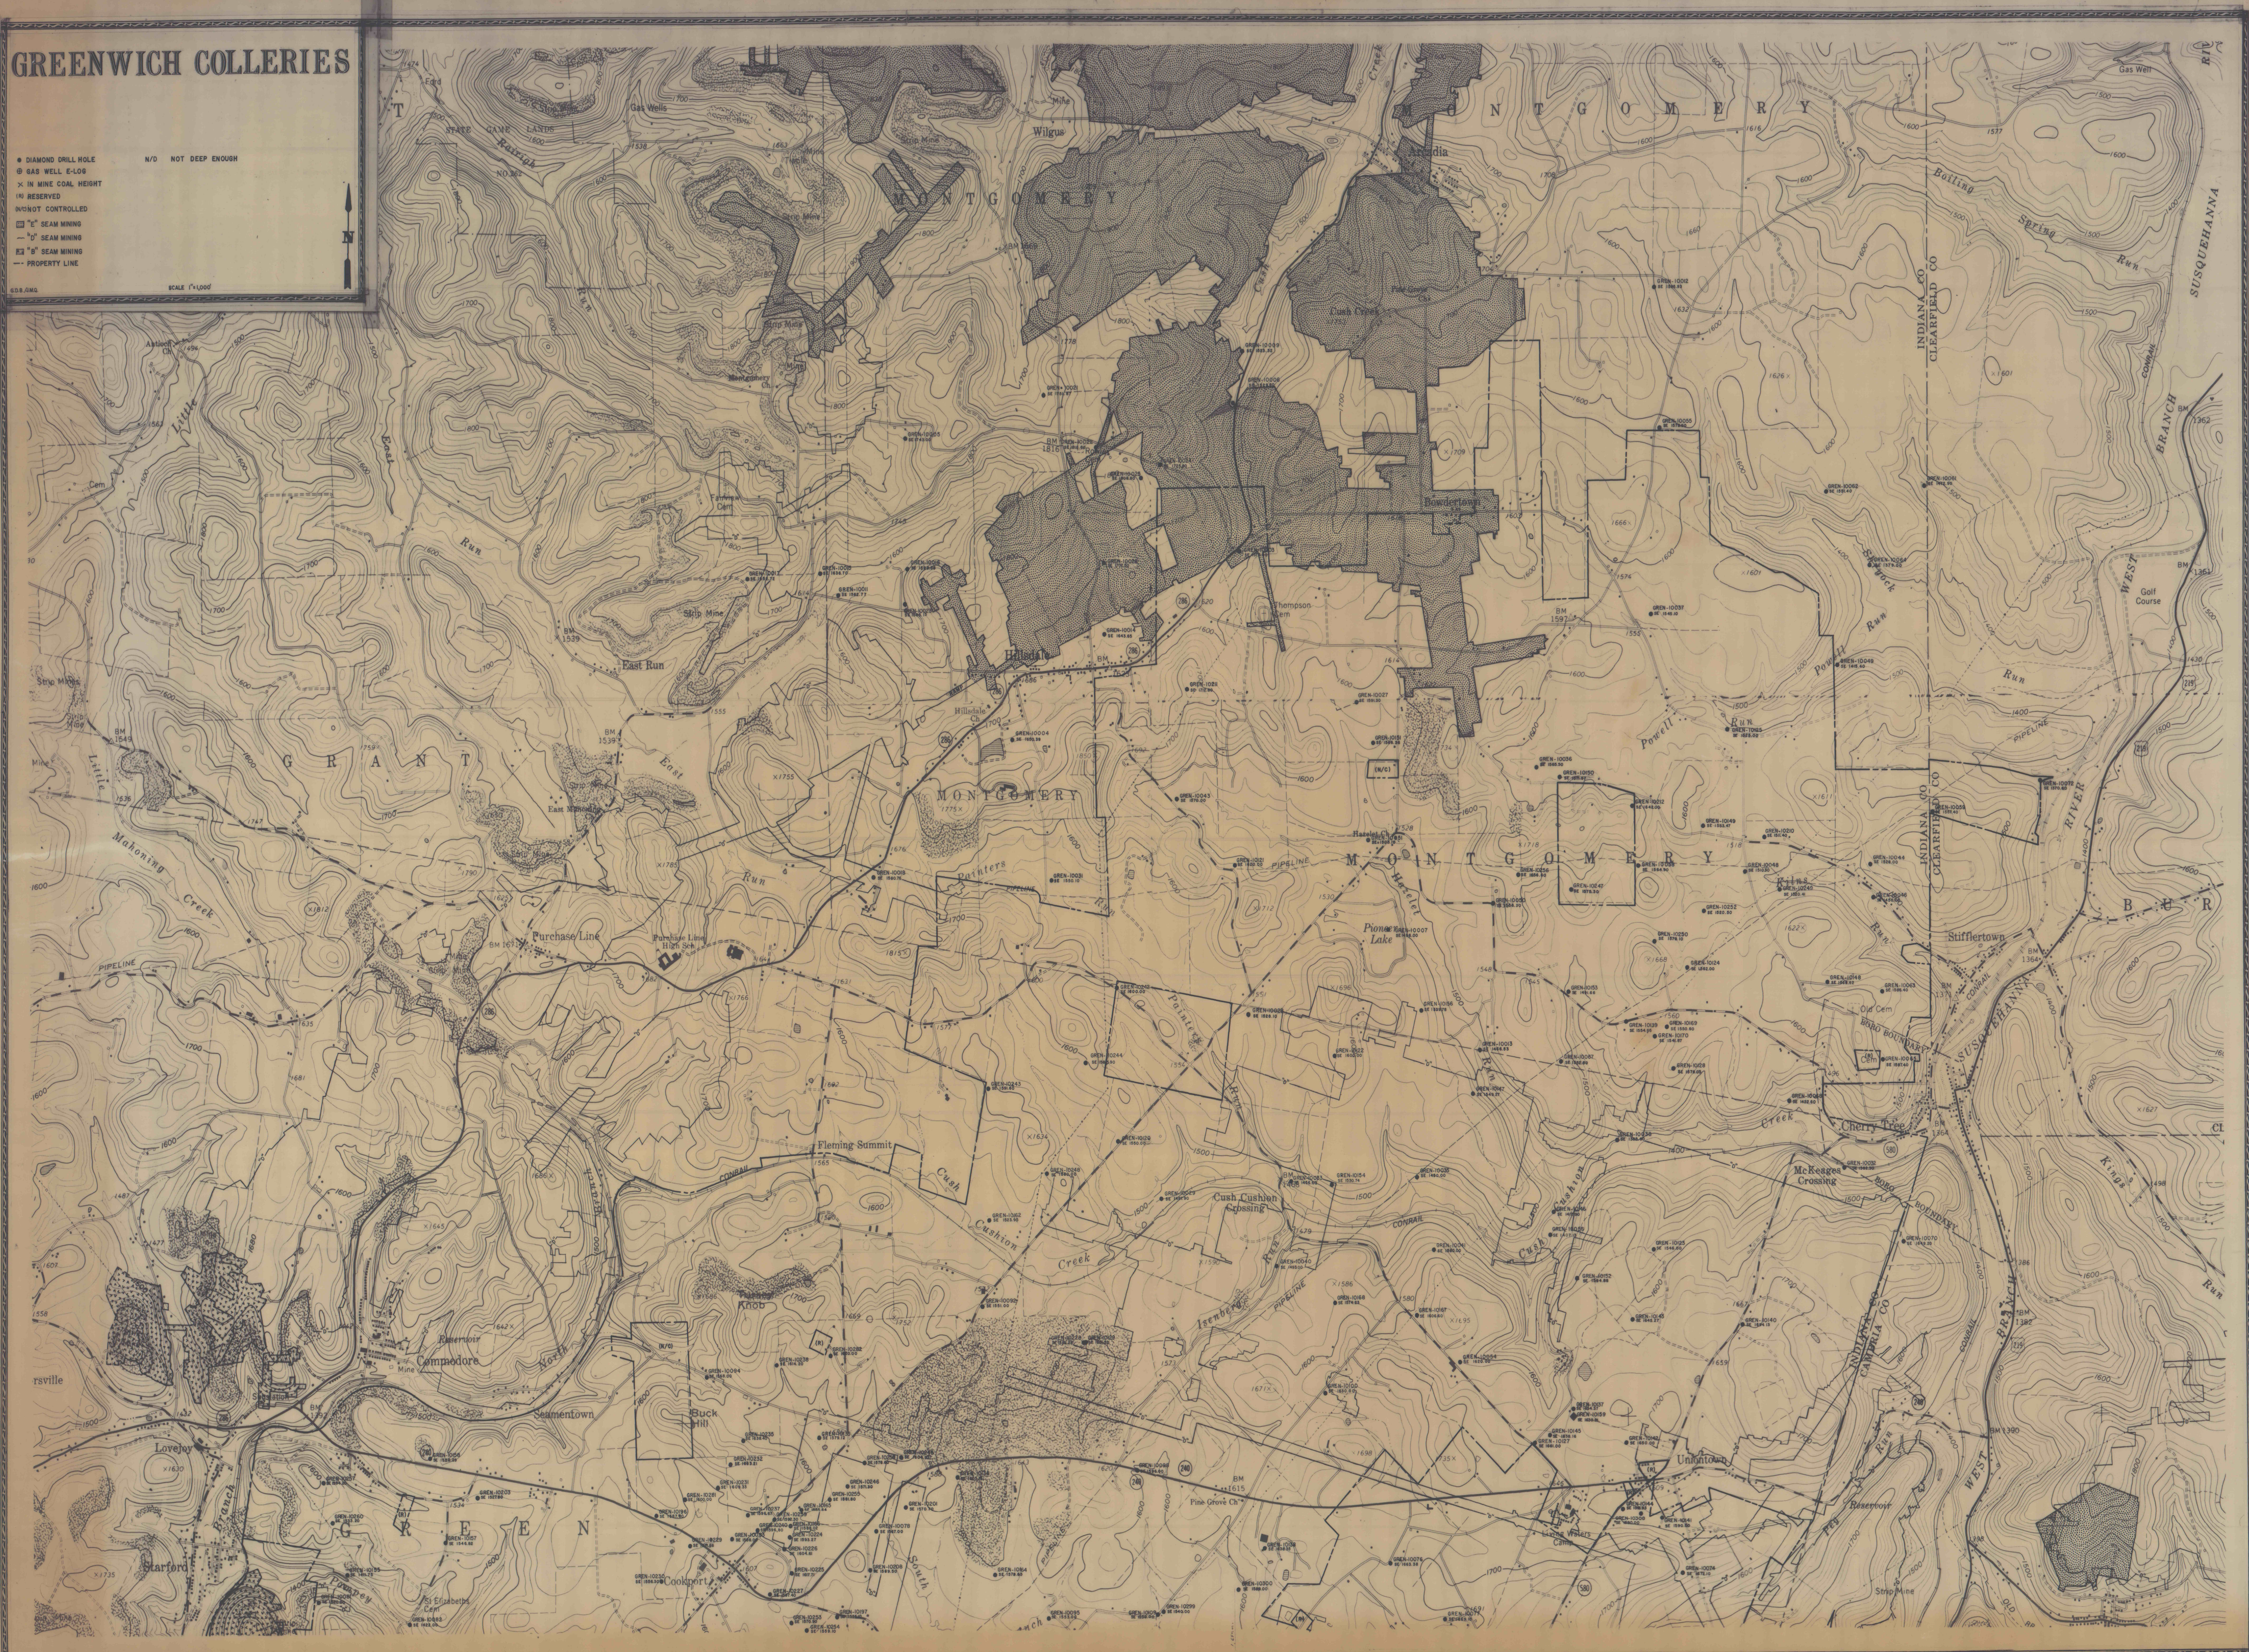

12667-101