


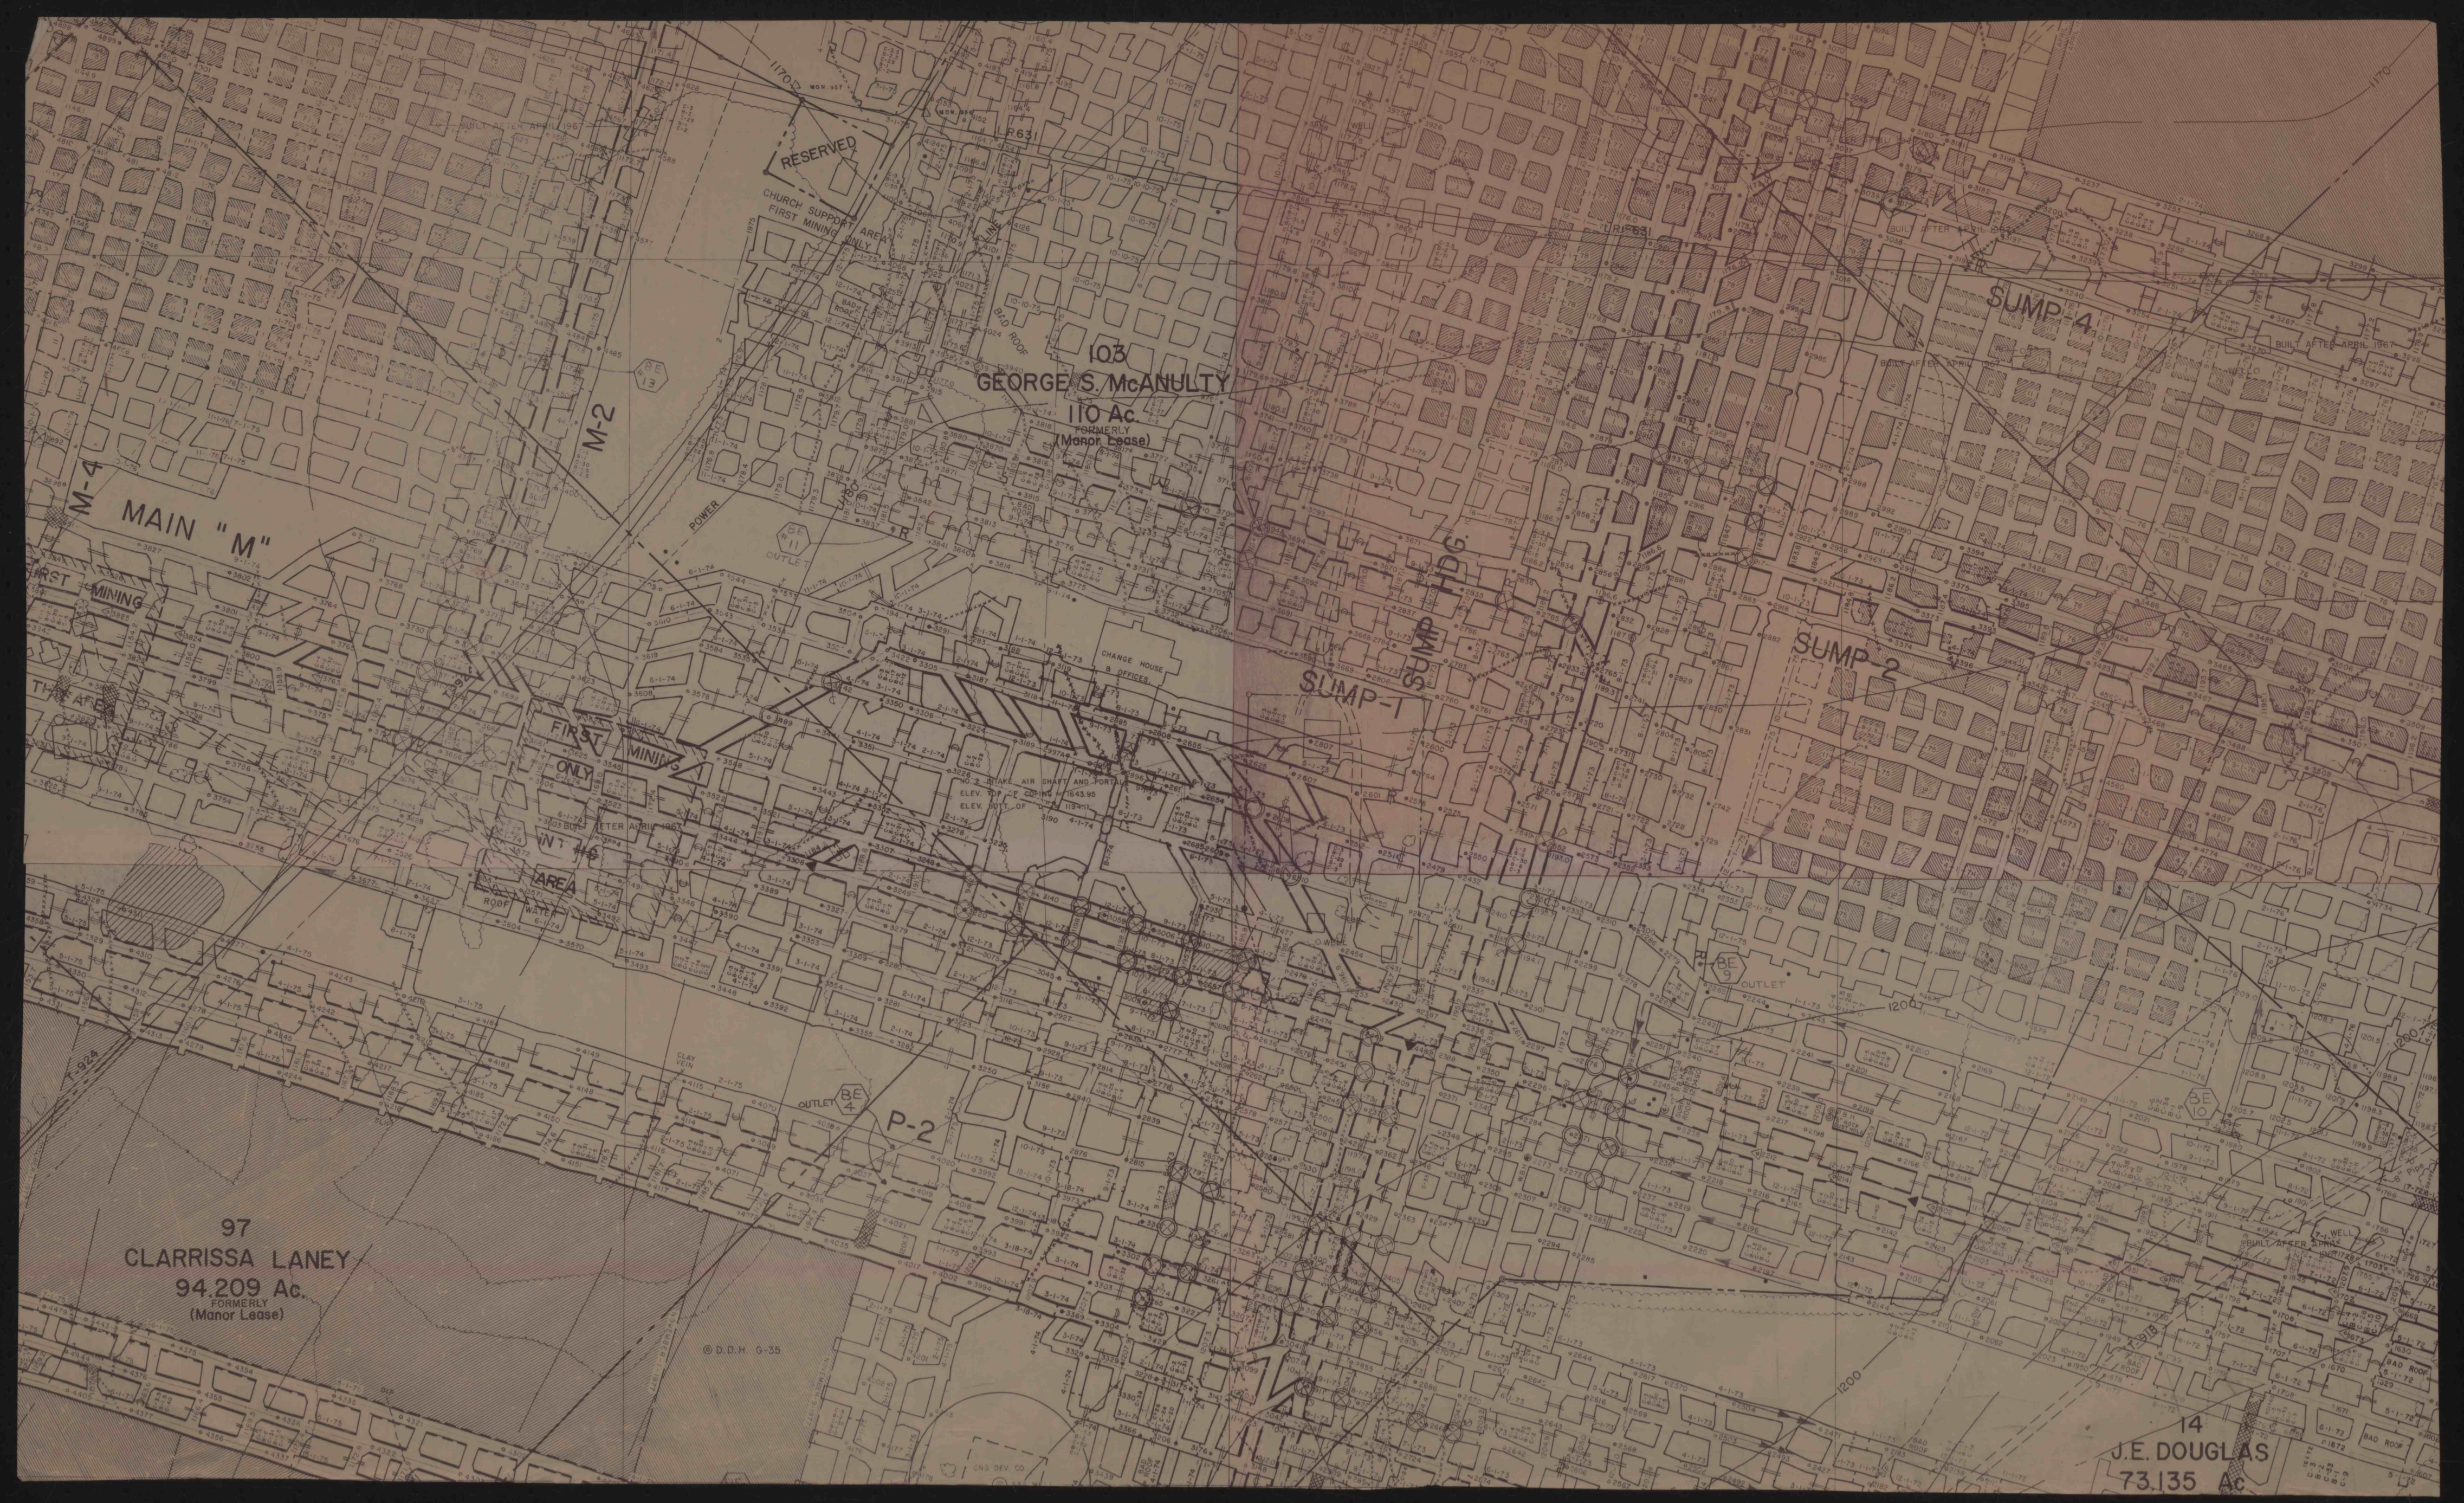

RESERVED

CHURCH SUPPORT
AREA
FIRST MINING

103
GEORGE S. McANULTY
110 Ac.
FORMERLY
(Manor Lease)

SUMP 4

SUMP 2

SUMP 1

MAIN "M"

M-2

FIRST MINING
ONLY

AREA

97
CLARRISSA LANEY
94.209 Ac.
FORMERLY
(Manor Lease)

© D.D.M. G-35

P-2

14
J.E. DOUGLAS
73.135 Ac