


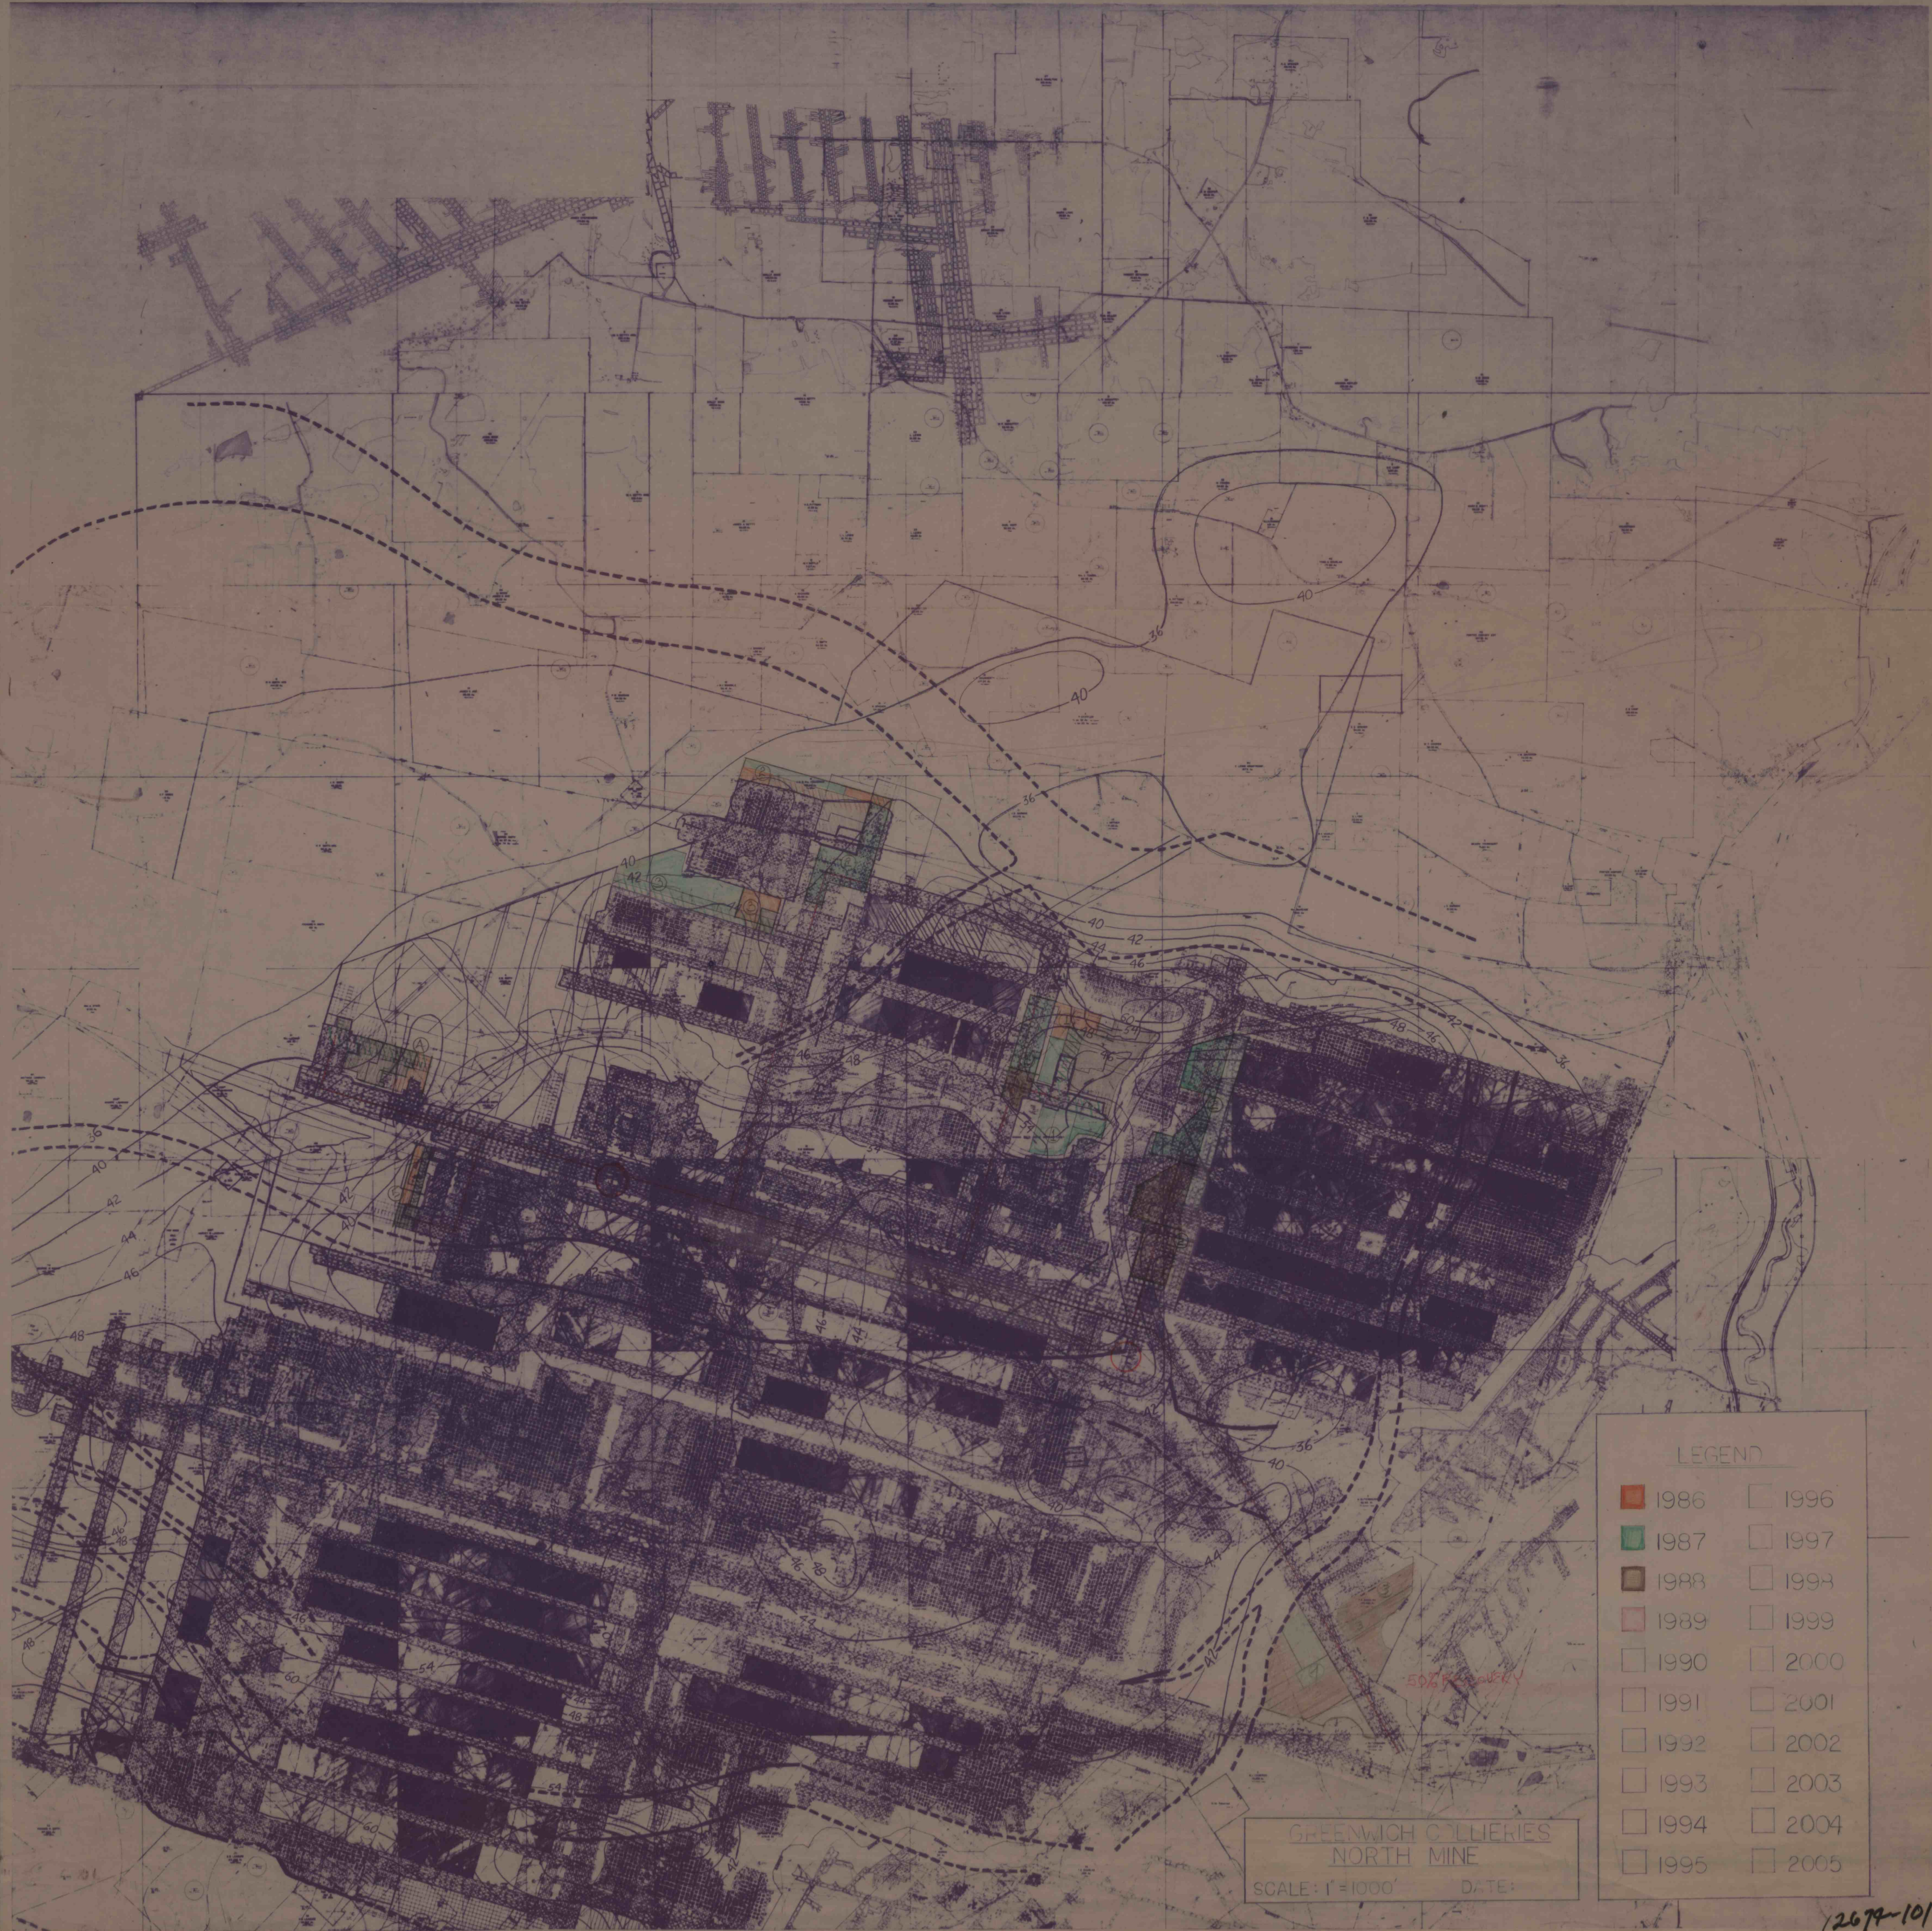

LEGEND

1986	1996
1987	1997
1988	1998
1989	1999
1990	2000
1991	2001
1992	2002
1993	2003
1994	2004
1995	2005

GREENWICH COLLIERIES
NORTH MINE

SCALE: 1" = 1000' DATE:

12674-101