


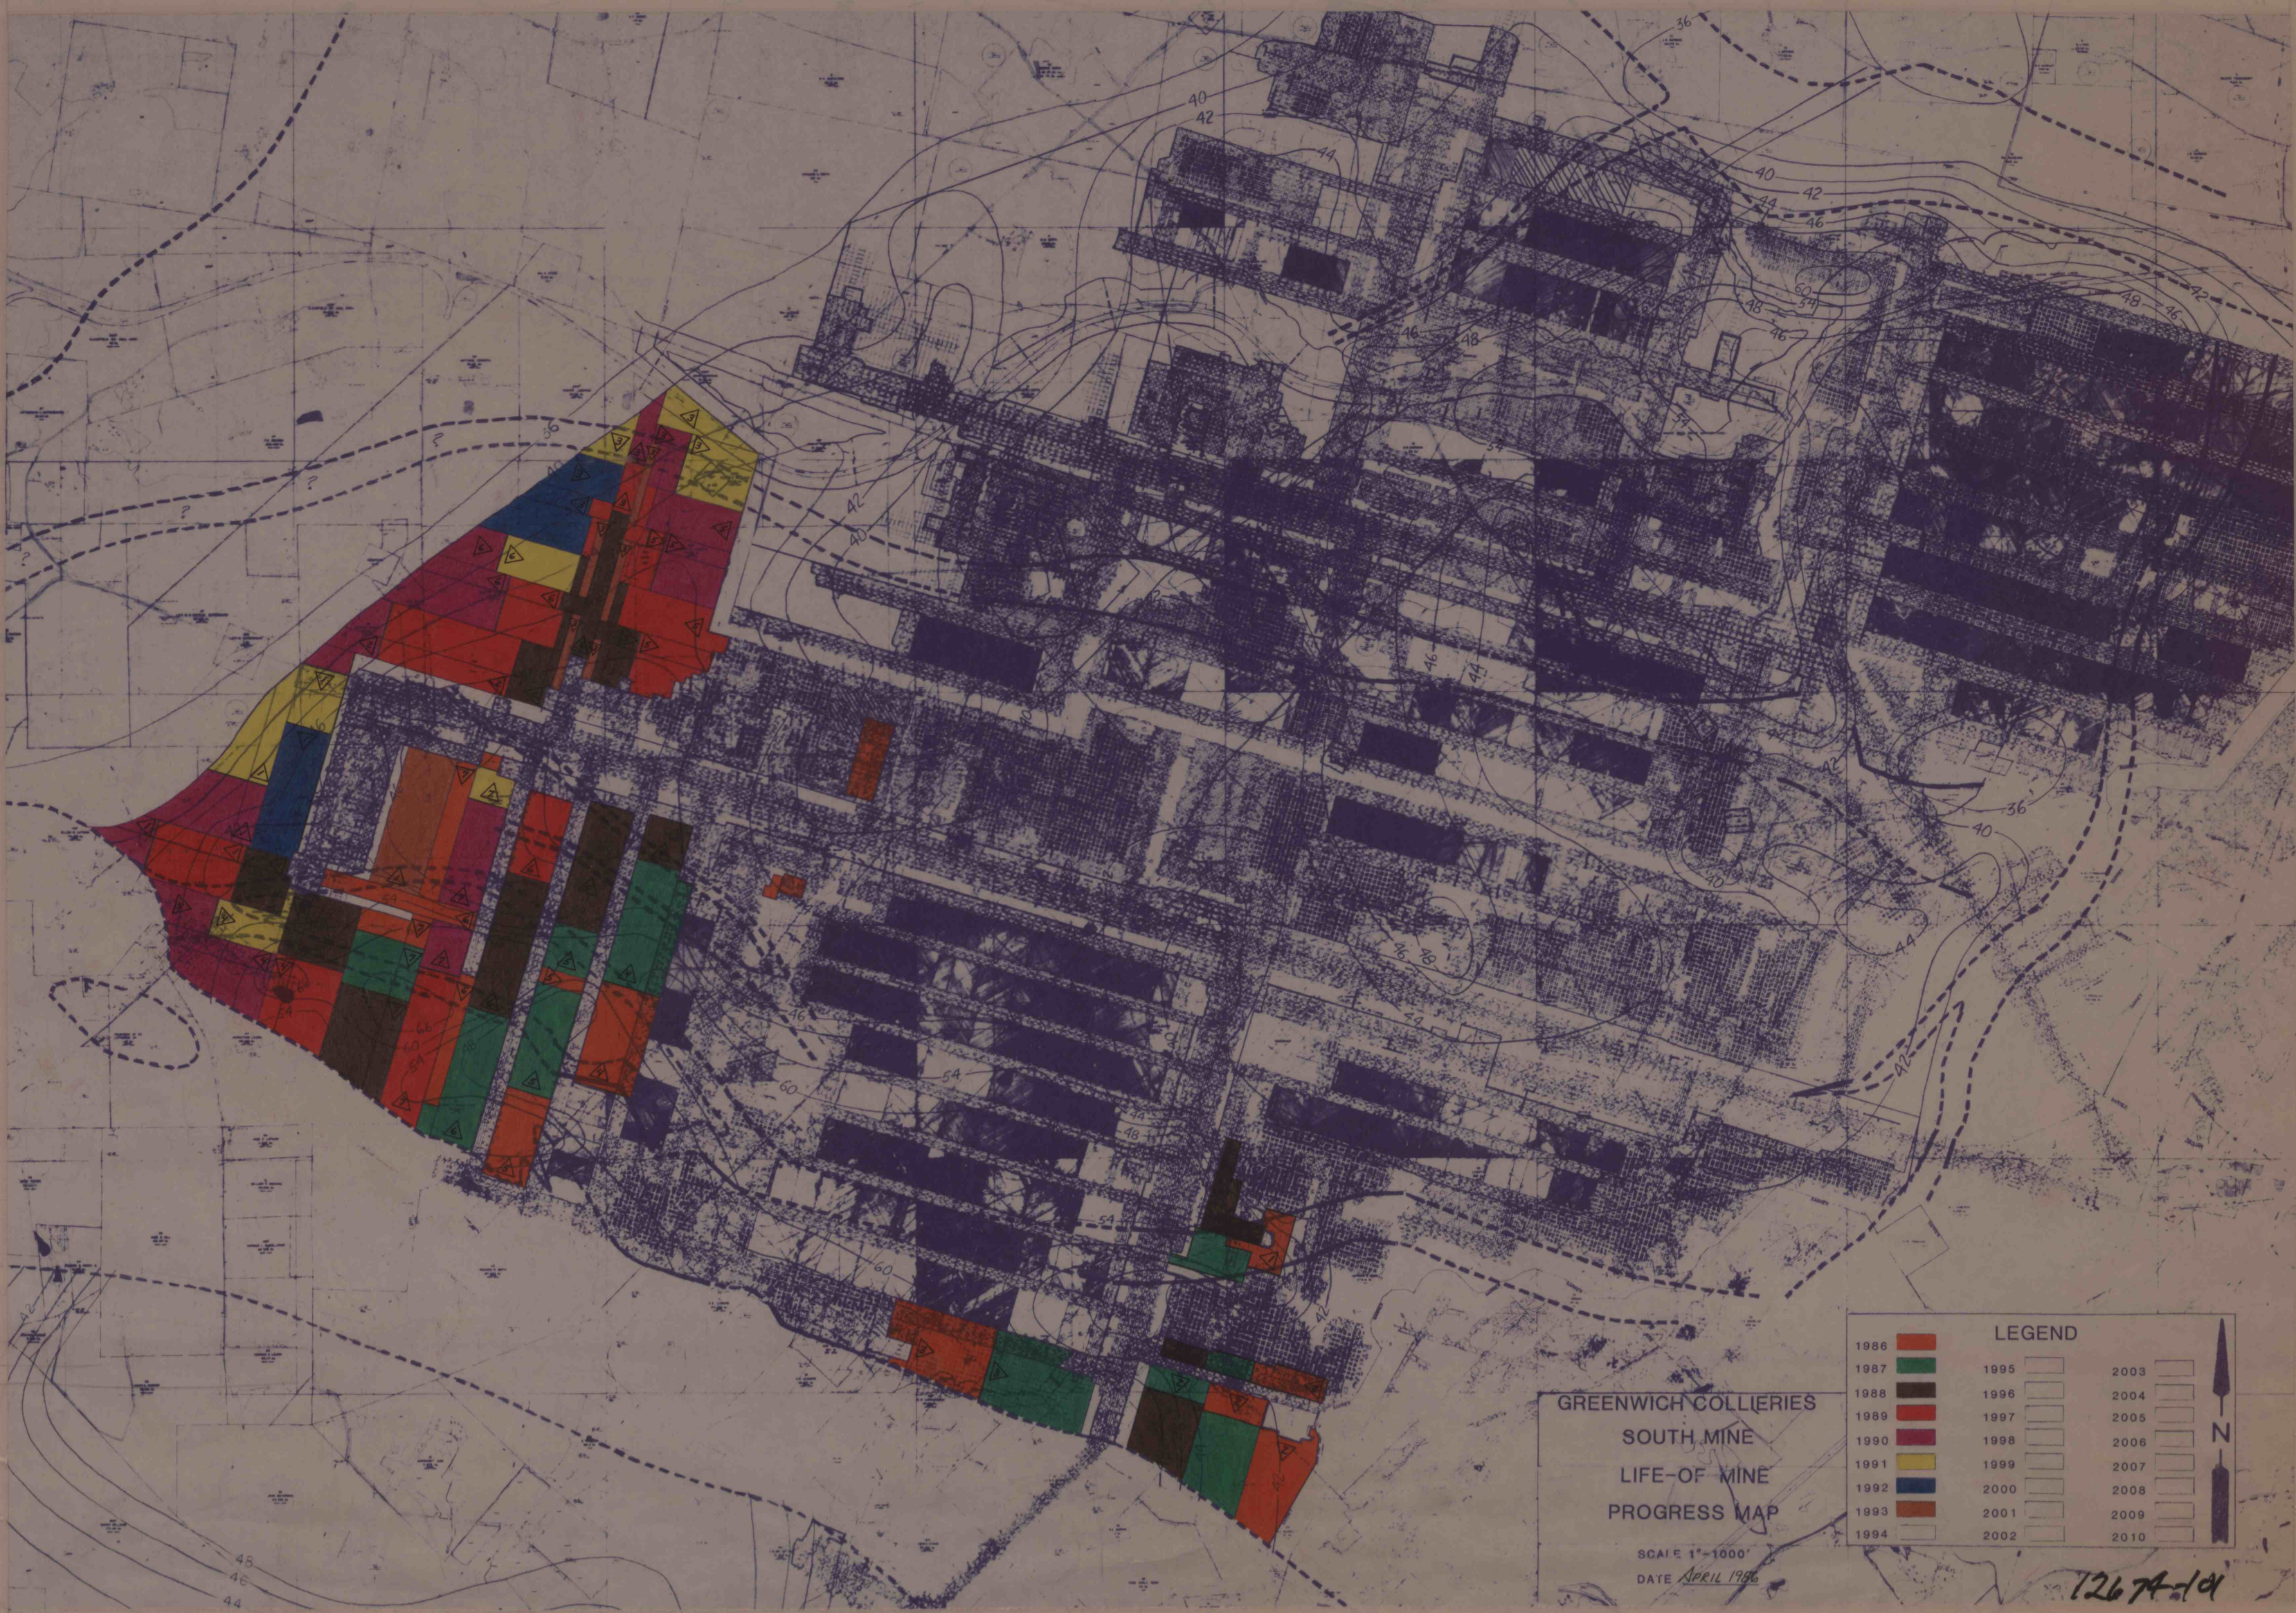

GREENWICH COLLIERIES
SOUTH MINE
LIFE-OF MINE
PROGRESS MAP

SCALE 1" = 1000'
DATE April 1986

LEGEND			
1986		1995	
1987		1996	
1988		1997	
1989		1998	
1990		1999	
1991		2000	
1992		2001	
1993		2002	
		2003	
		2004	
		2005	
		2006	
		2007	
		2008	
		2009	
		2010	

12674-101