


YATESBORO
CITY RECORD
DRAWER 103
N 12800

4.

12687-103

E 4000

N 10800

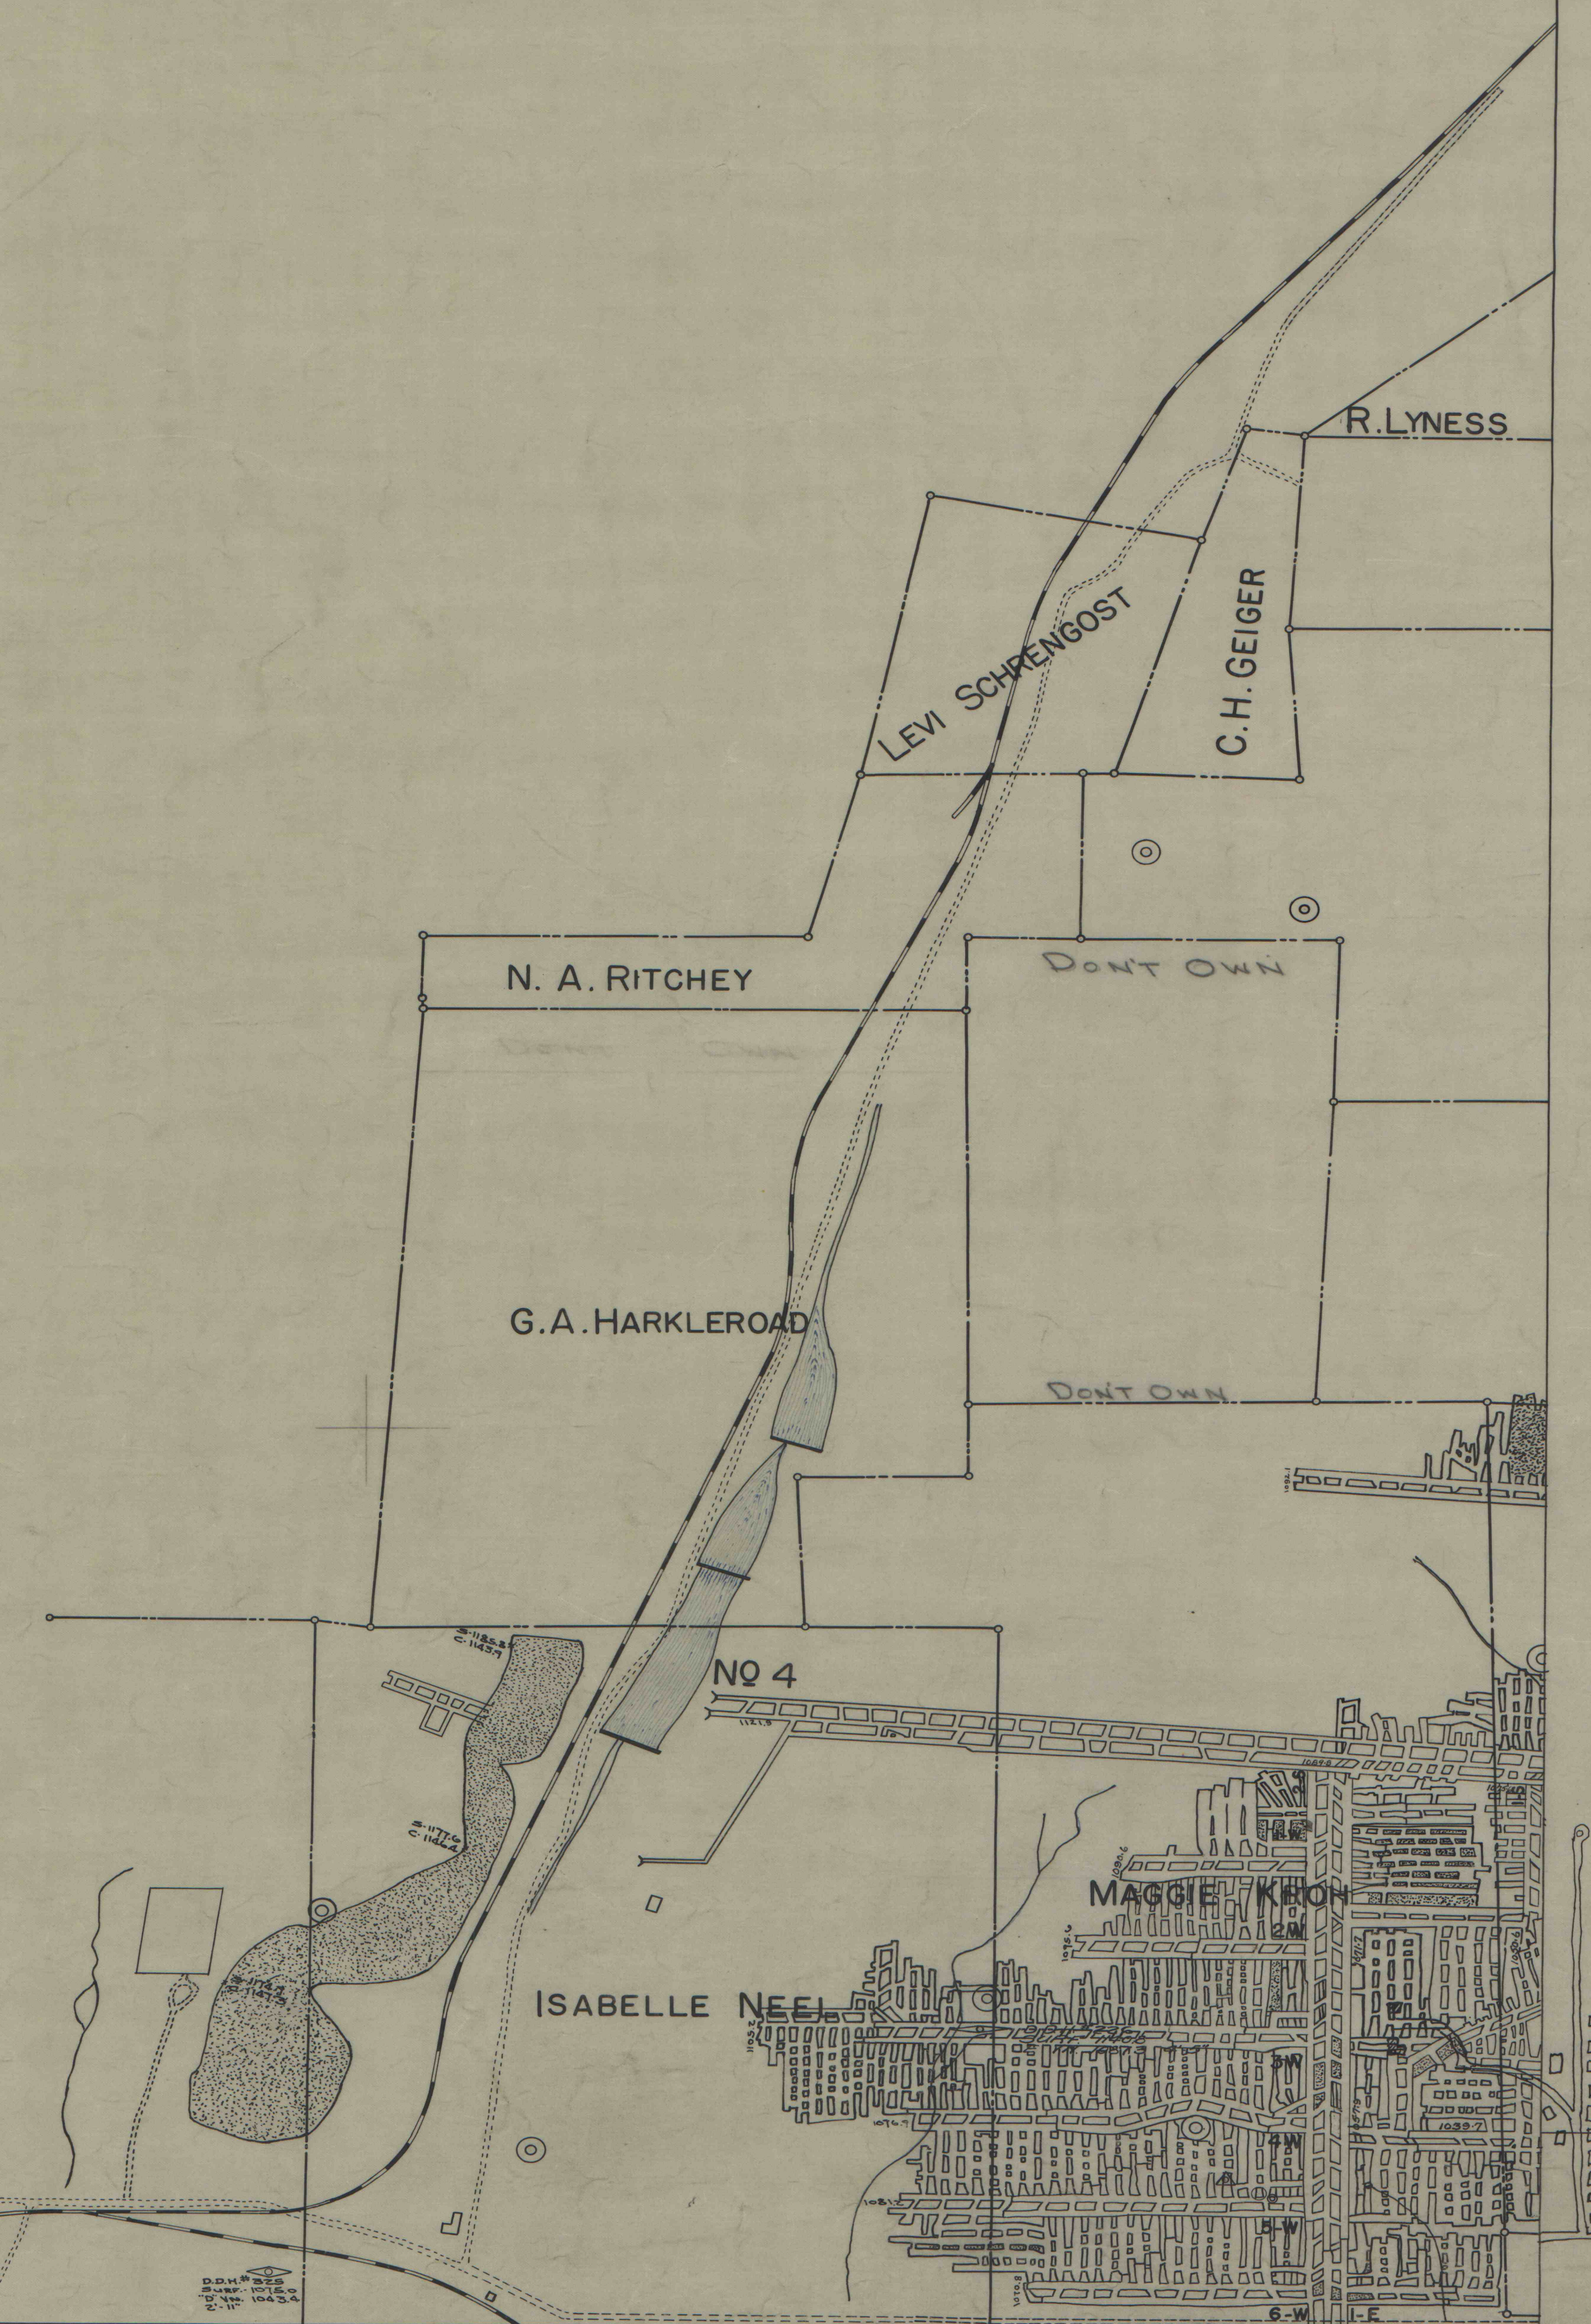

12687-103

YATESBORO
UPPER LEIN
DRAWER #103

4.