


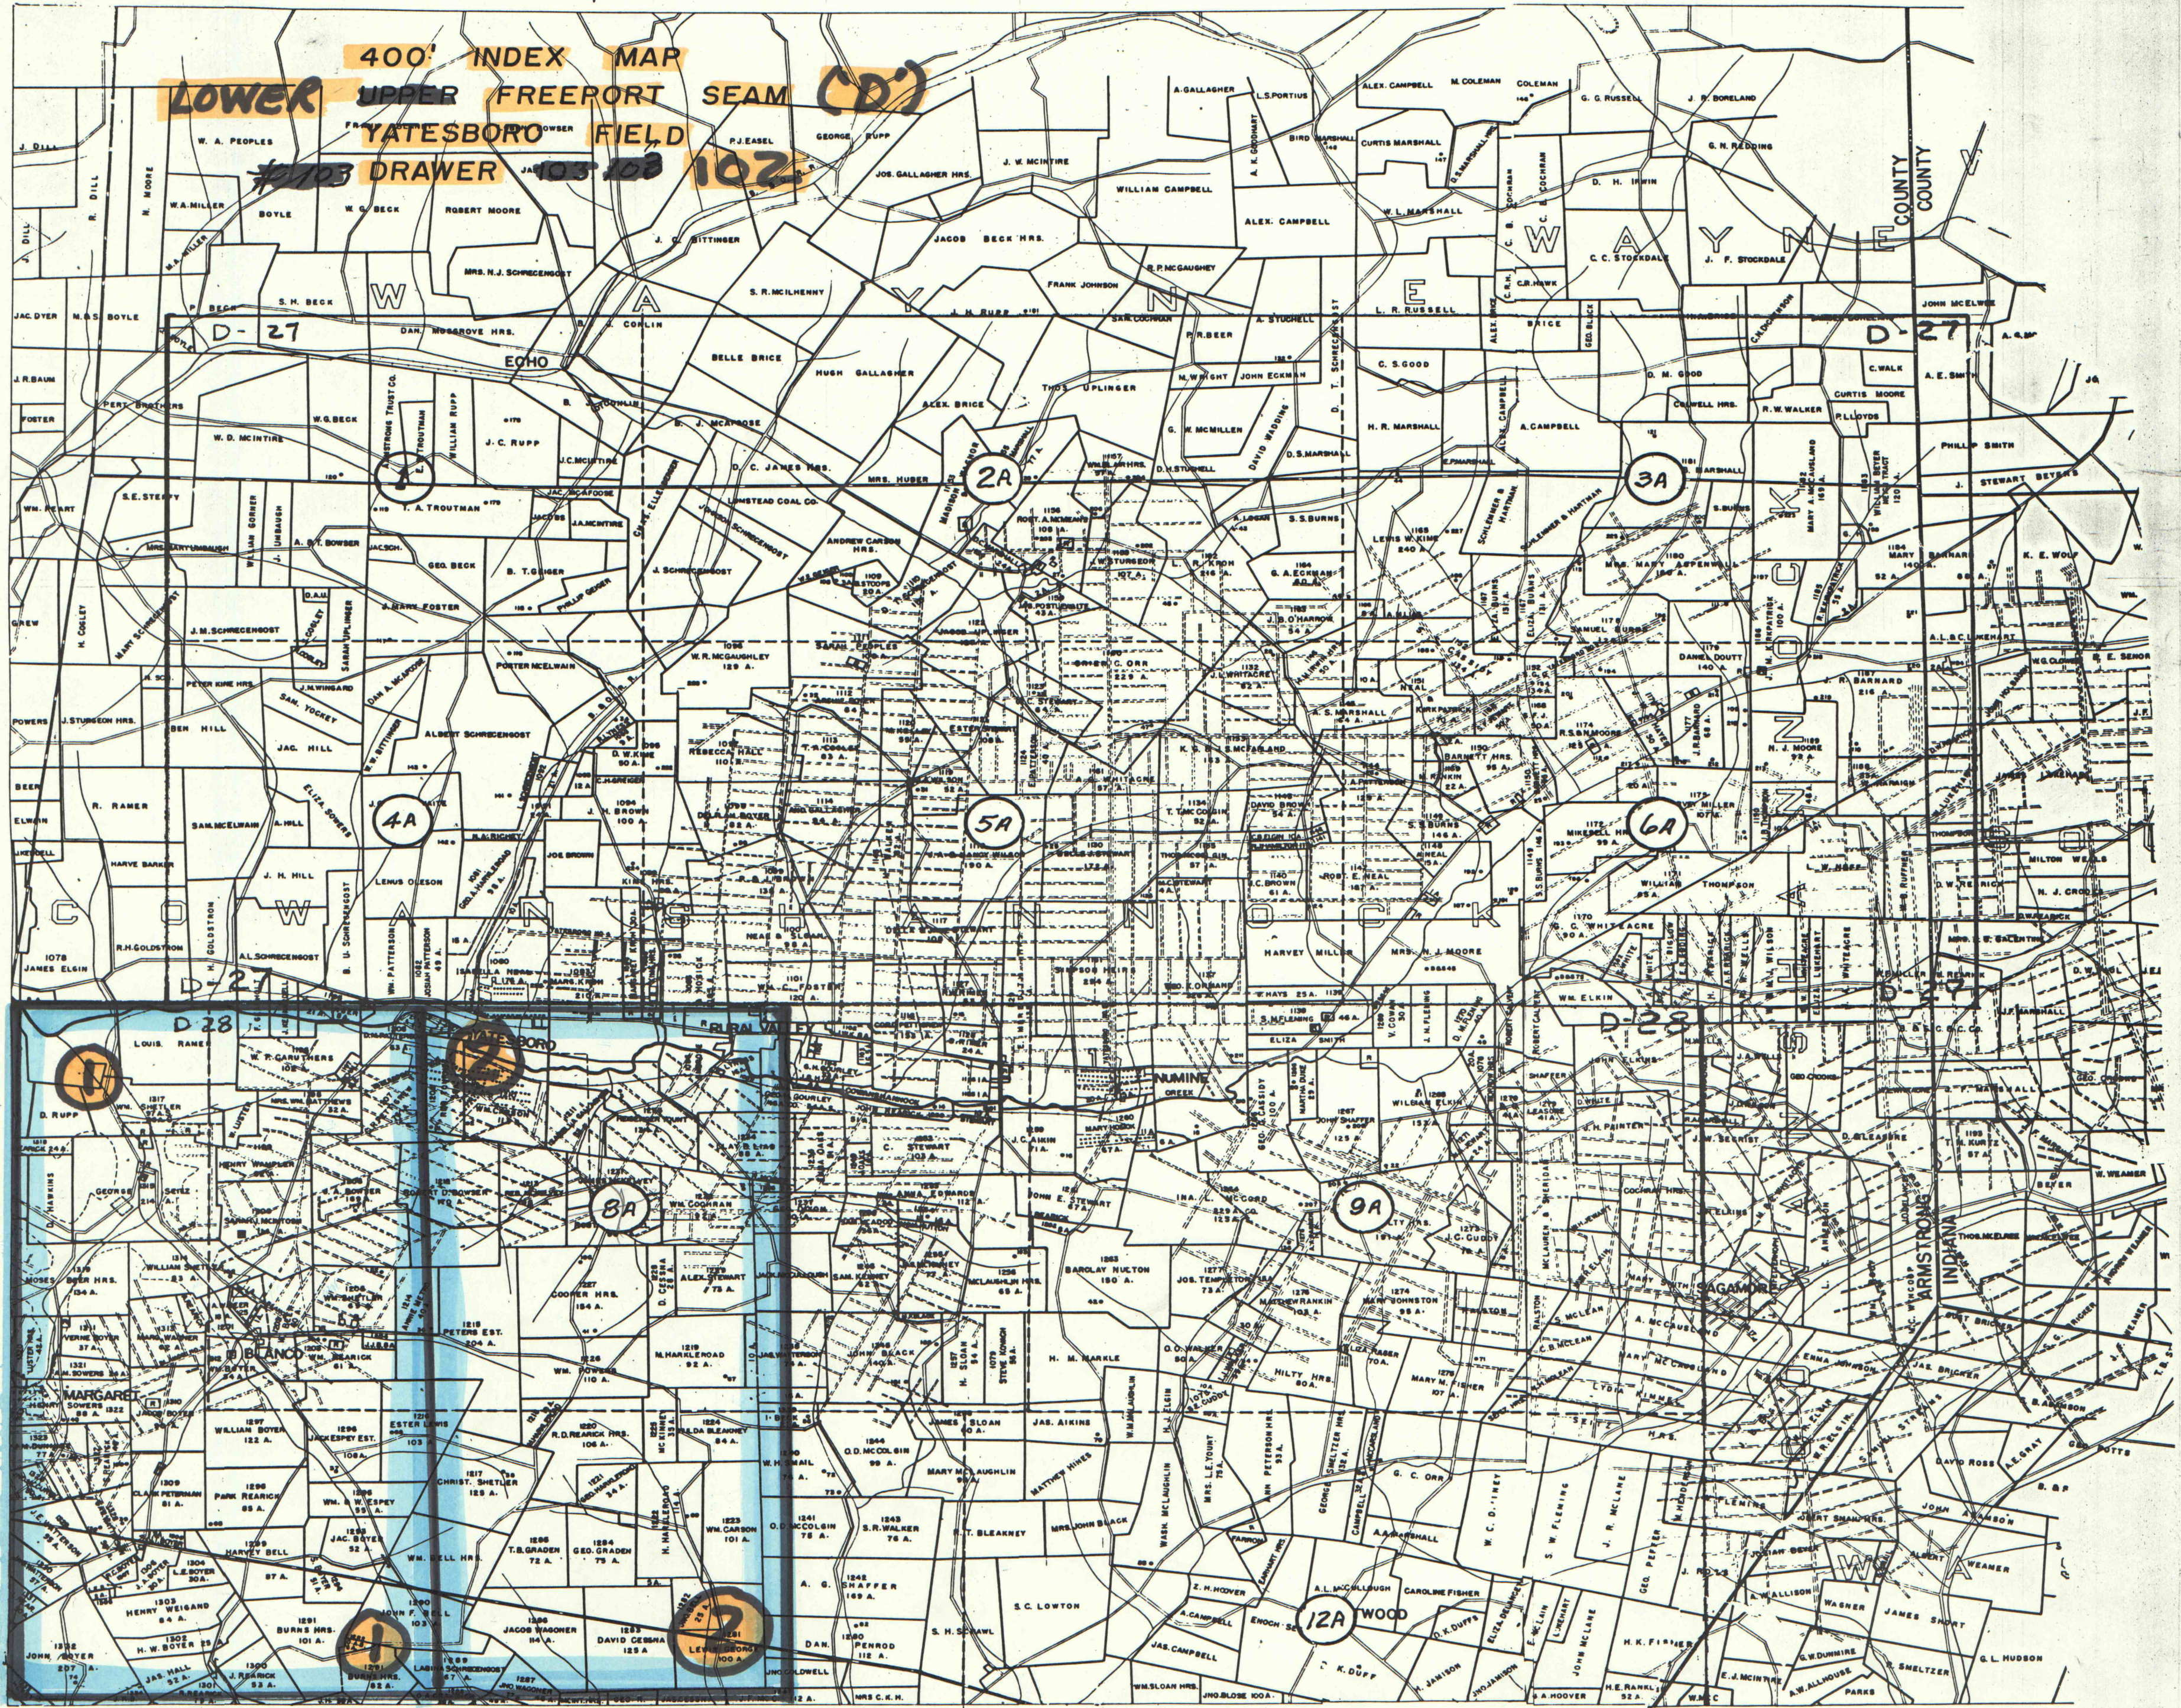

FILE NO. 12683-102

D SEAM 400' IN DRAWER 102