


12568-103

M-2

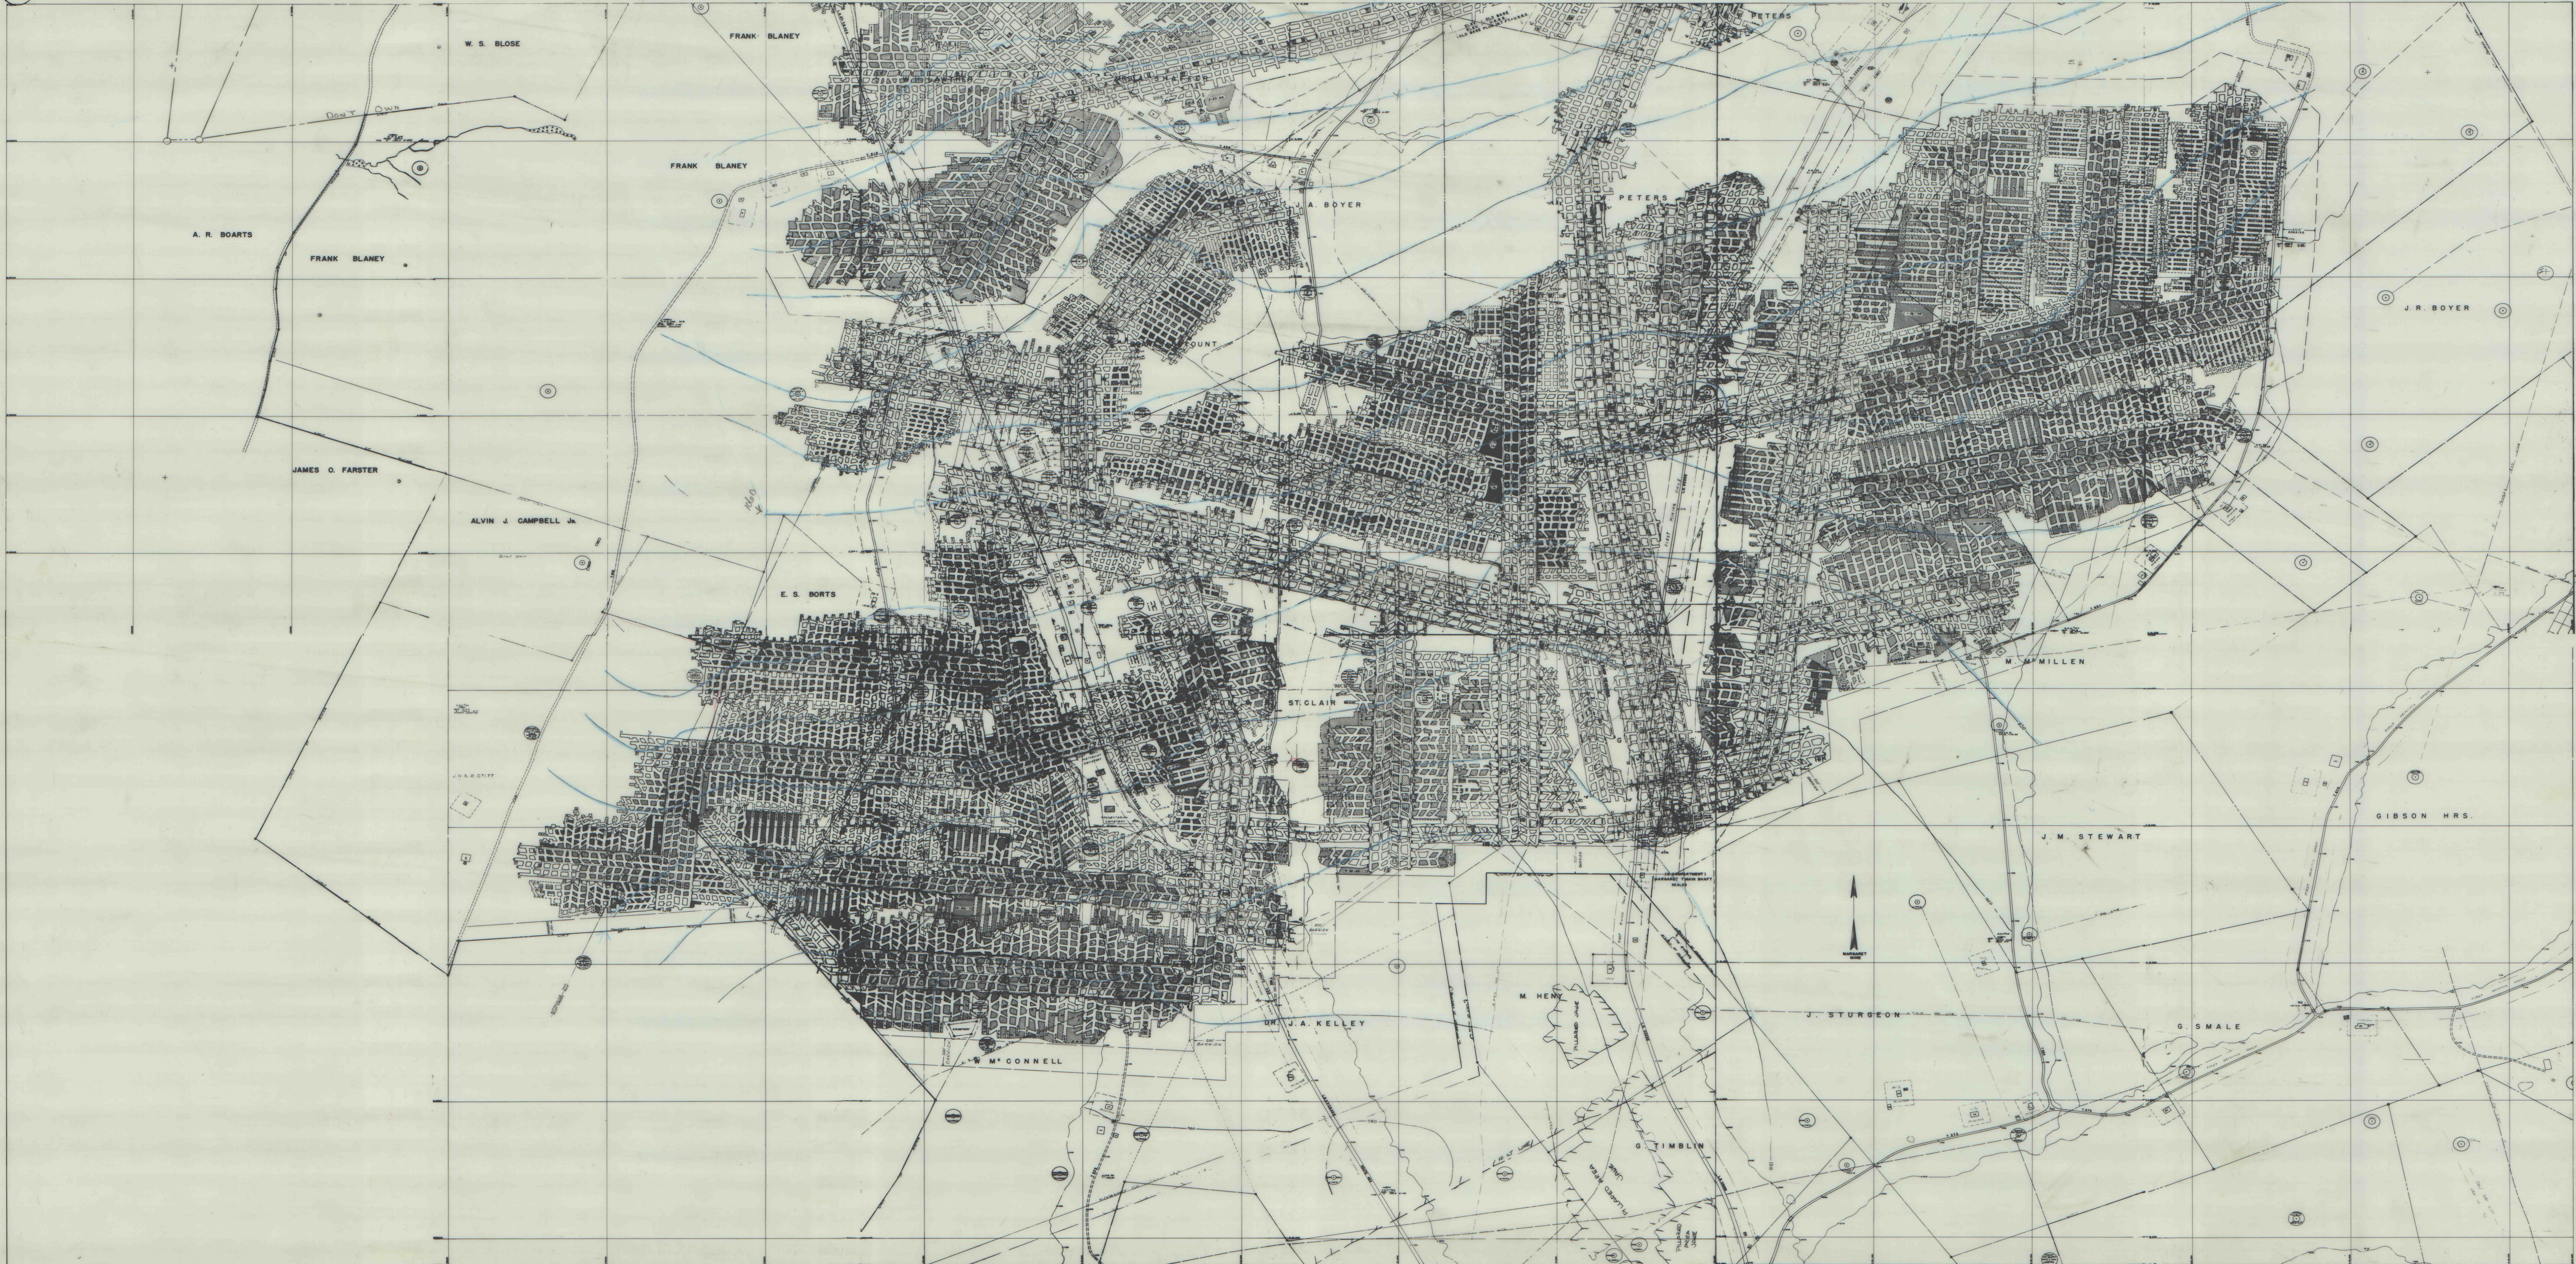

MARGARET NO. 7 (FINAL POSTING 9-30-77)

M-2

1" = 400'

12568-103

Drawer 103