


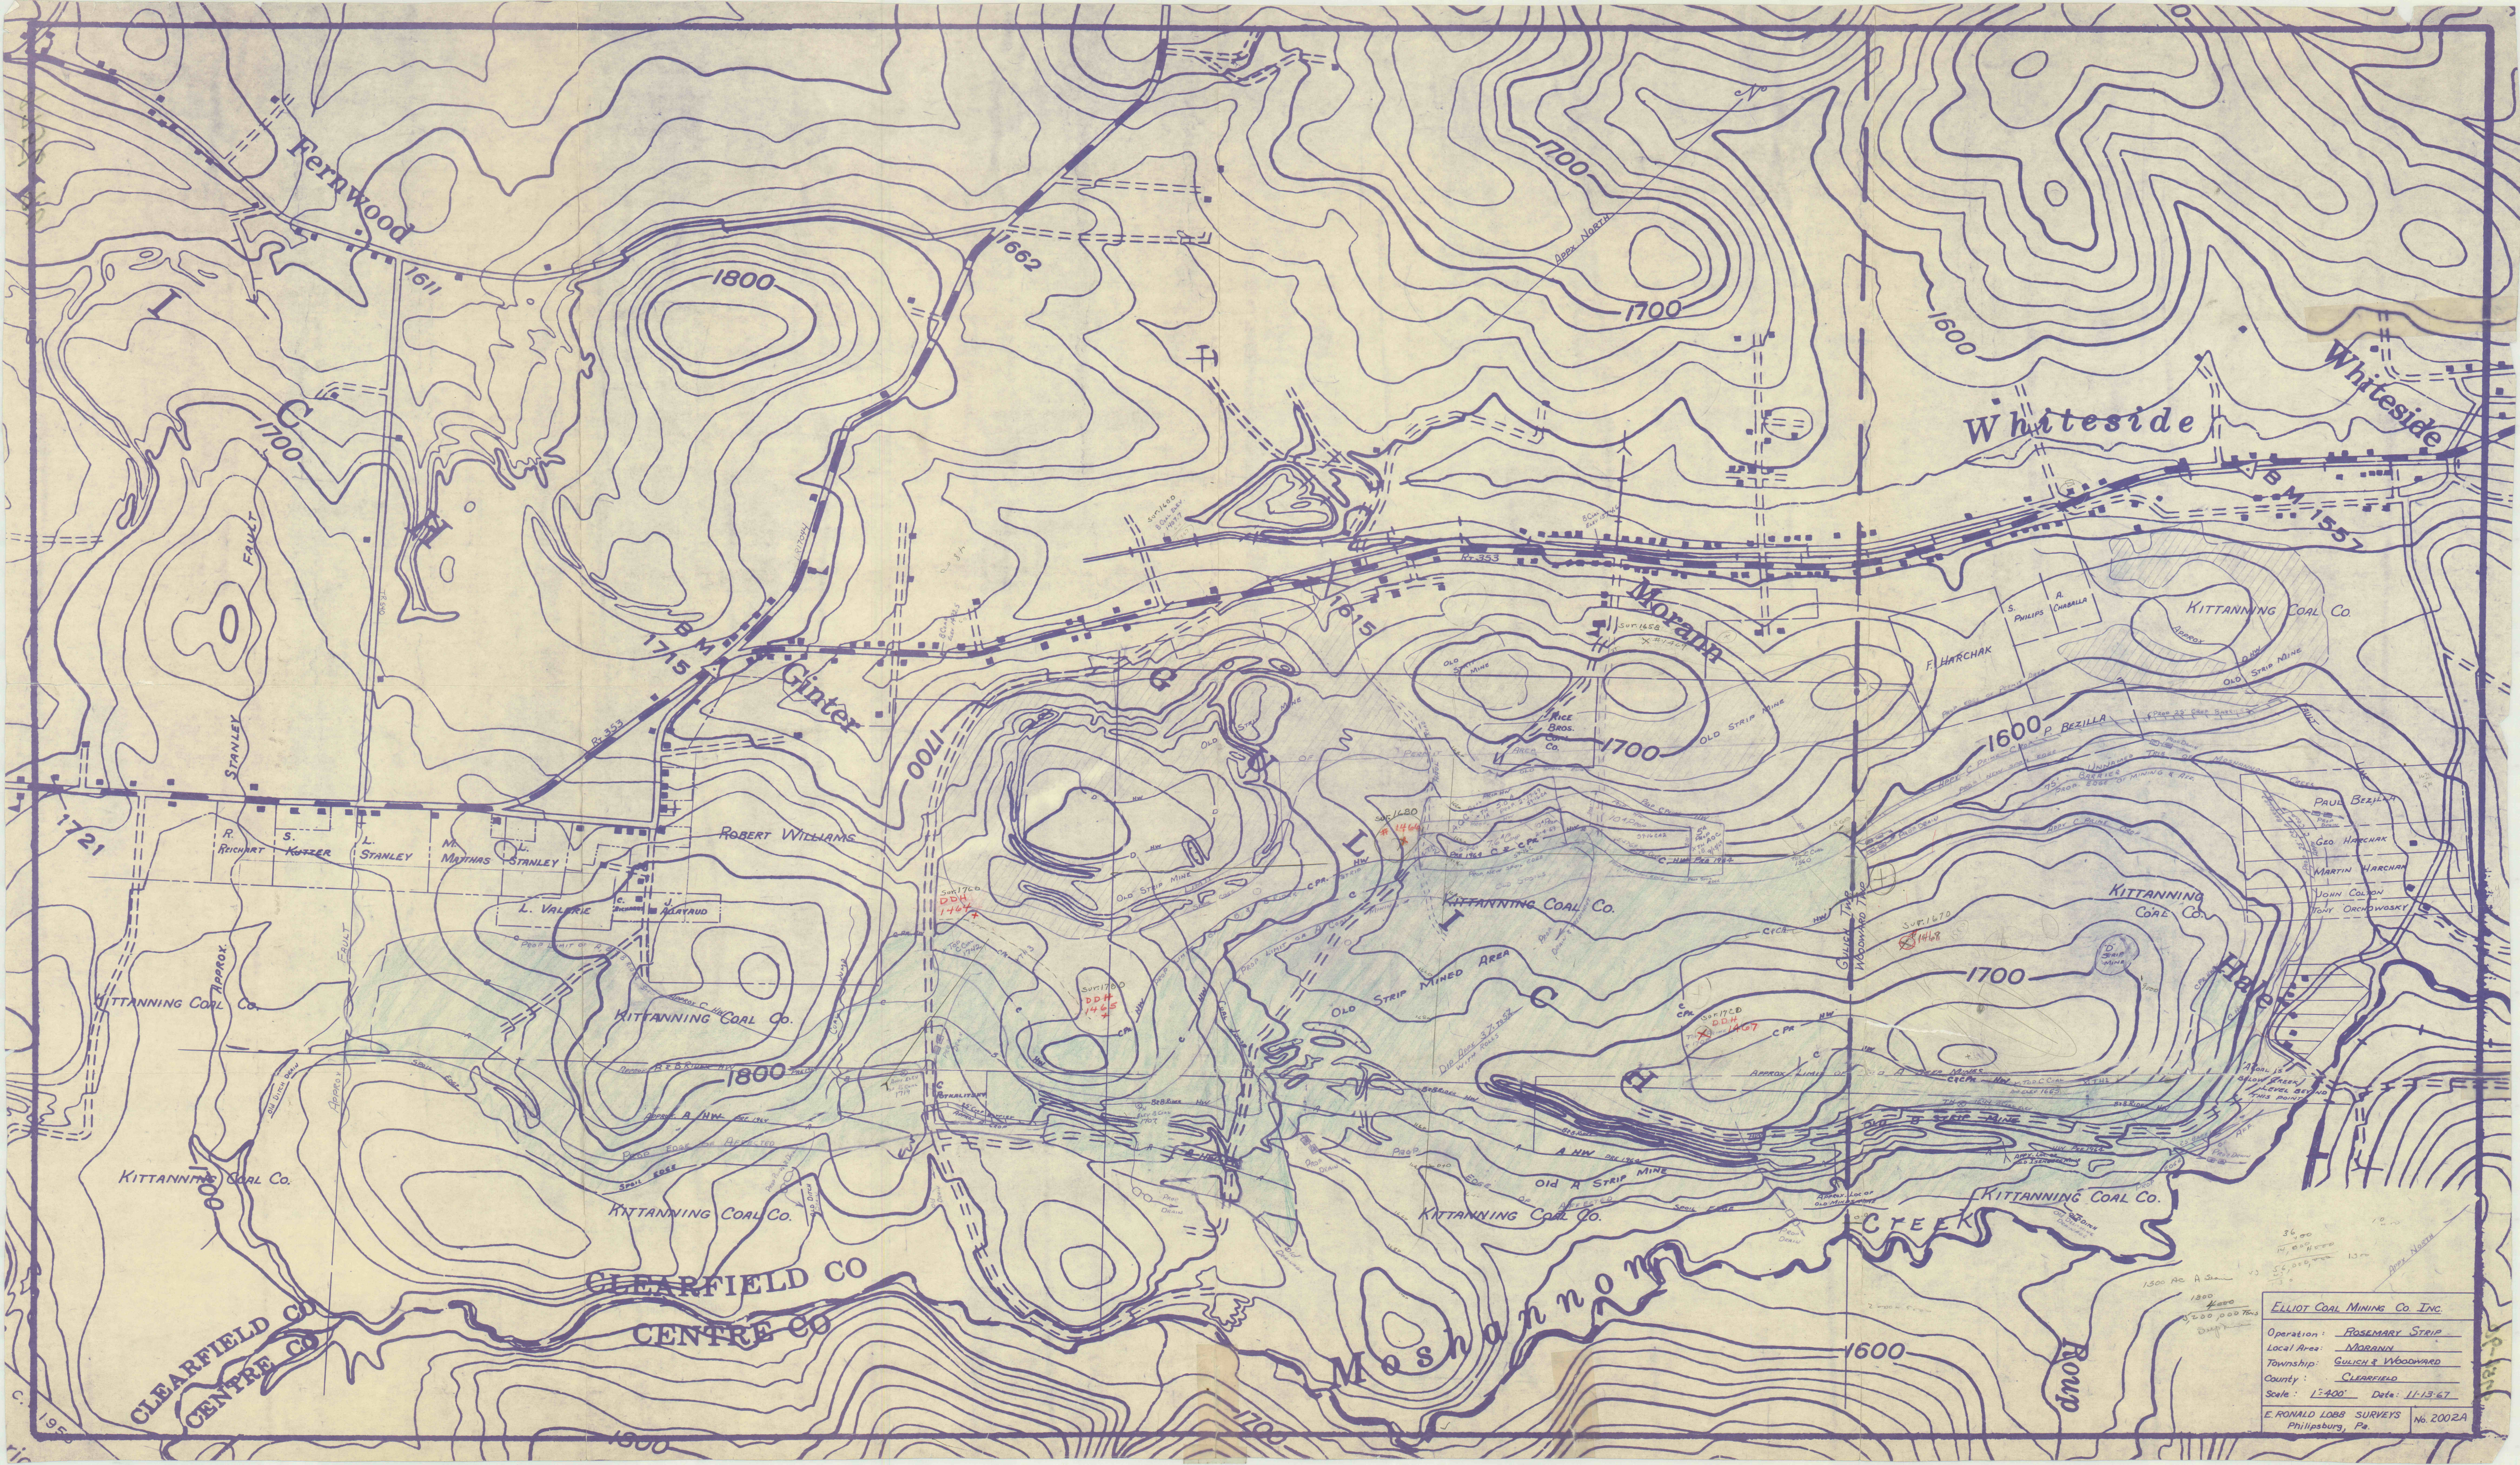

ELLIOT COAL MINING CO. INC.
Operation: ROSEMARY STRIP
Local Area: MORANA
Township: GULICH & WOODWARD
County: CLEARFIELD
Scale: 1"=400' Date: 11-13-67
E. RONALD LOBB SURVEYS No. 2002A
Philipsburg, Pa.