


⑤ DW - 104 MICROFILM 03 20 D-13 5 104

HC D-13

MARGARET

FIT TO 10

⑤

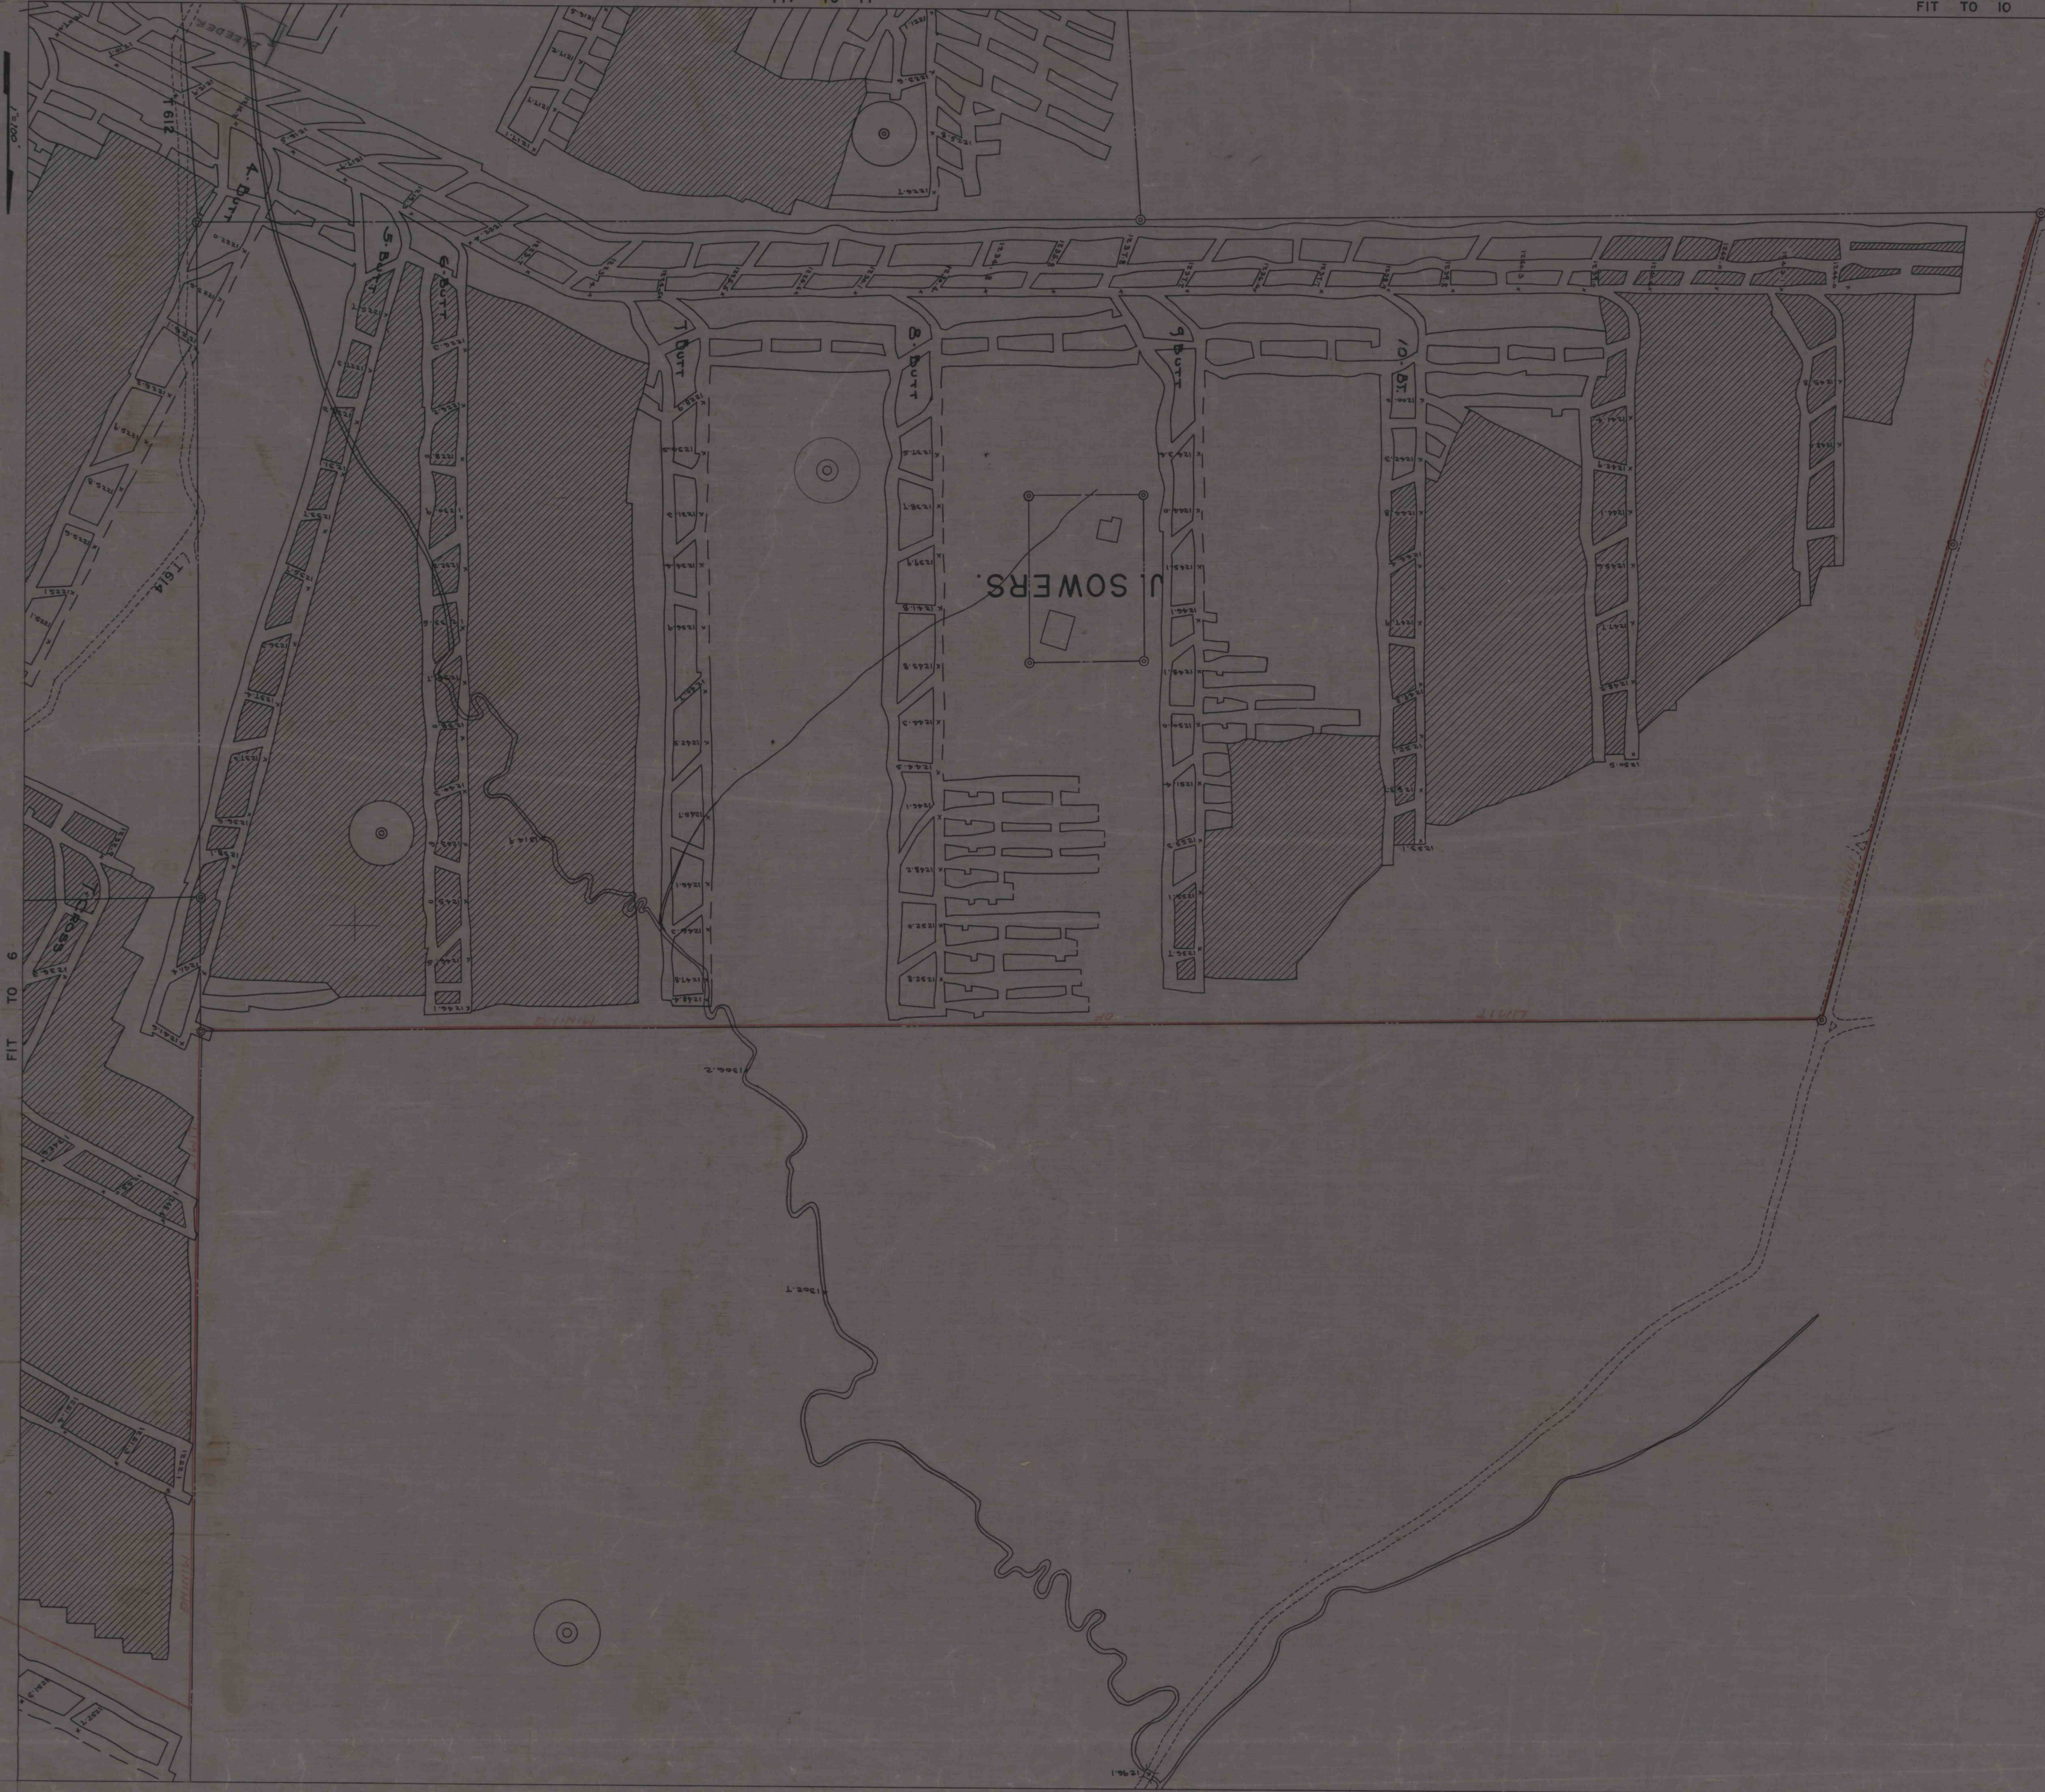

12691-104

12691-104

MARGARET

DW- 104

⑤