


E-2

TRACING E-2

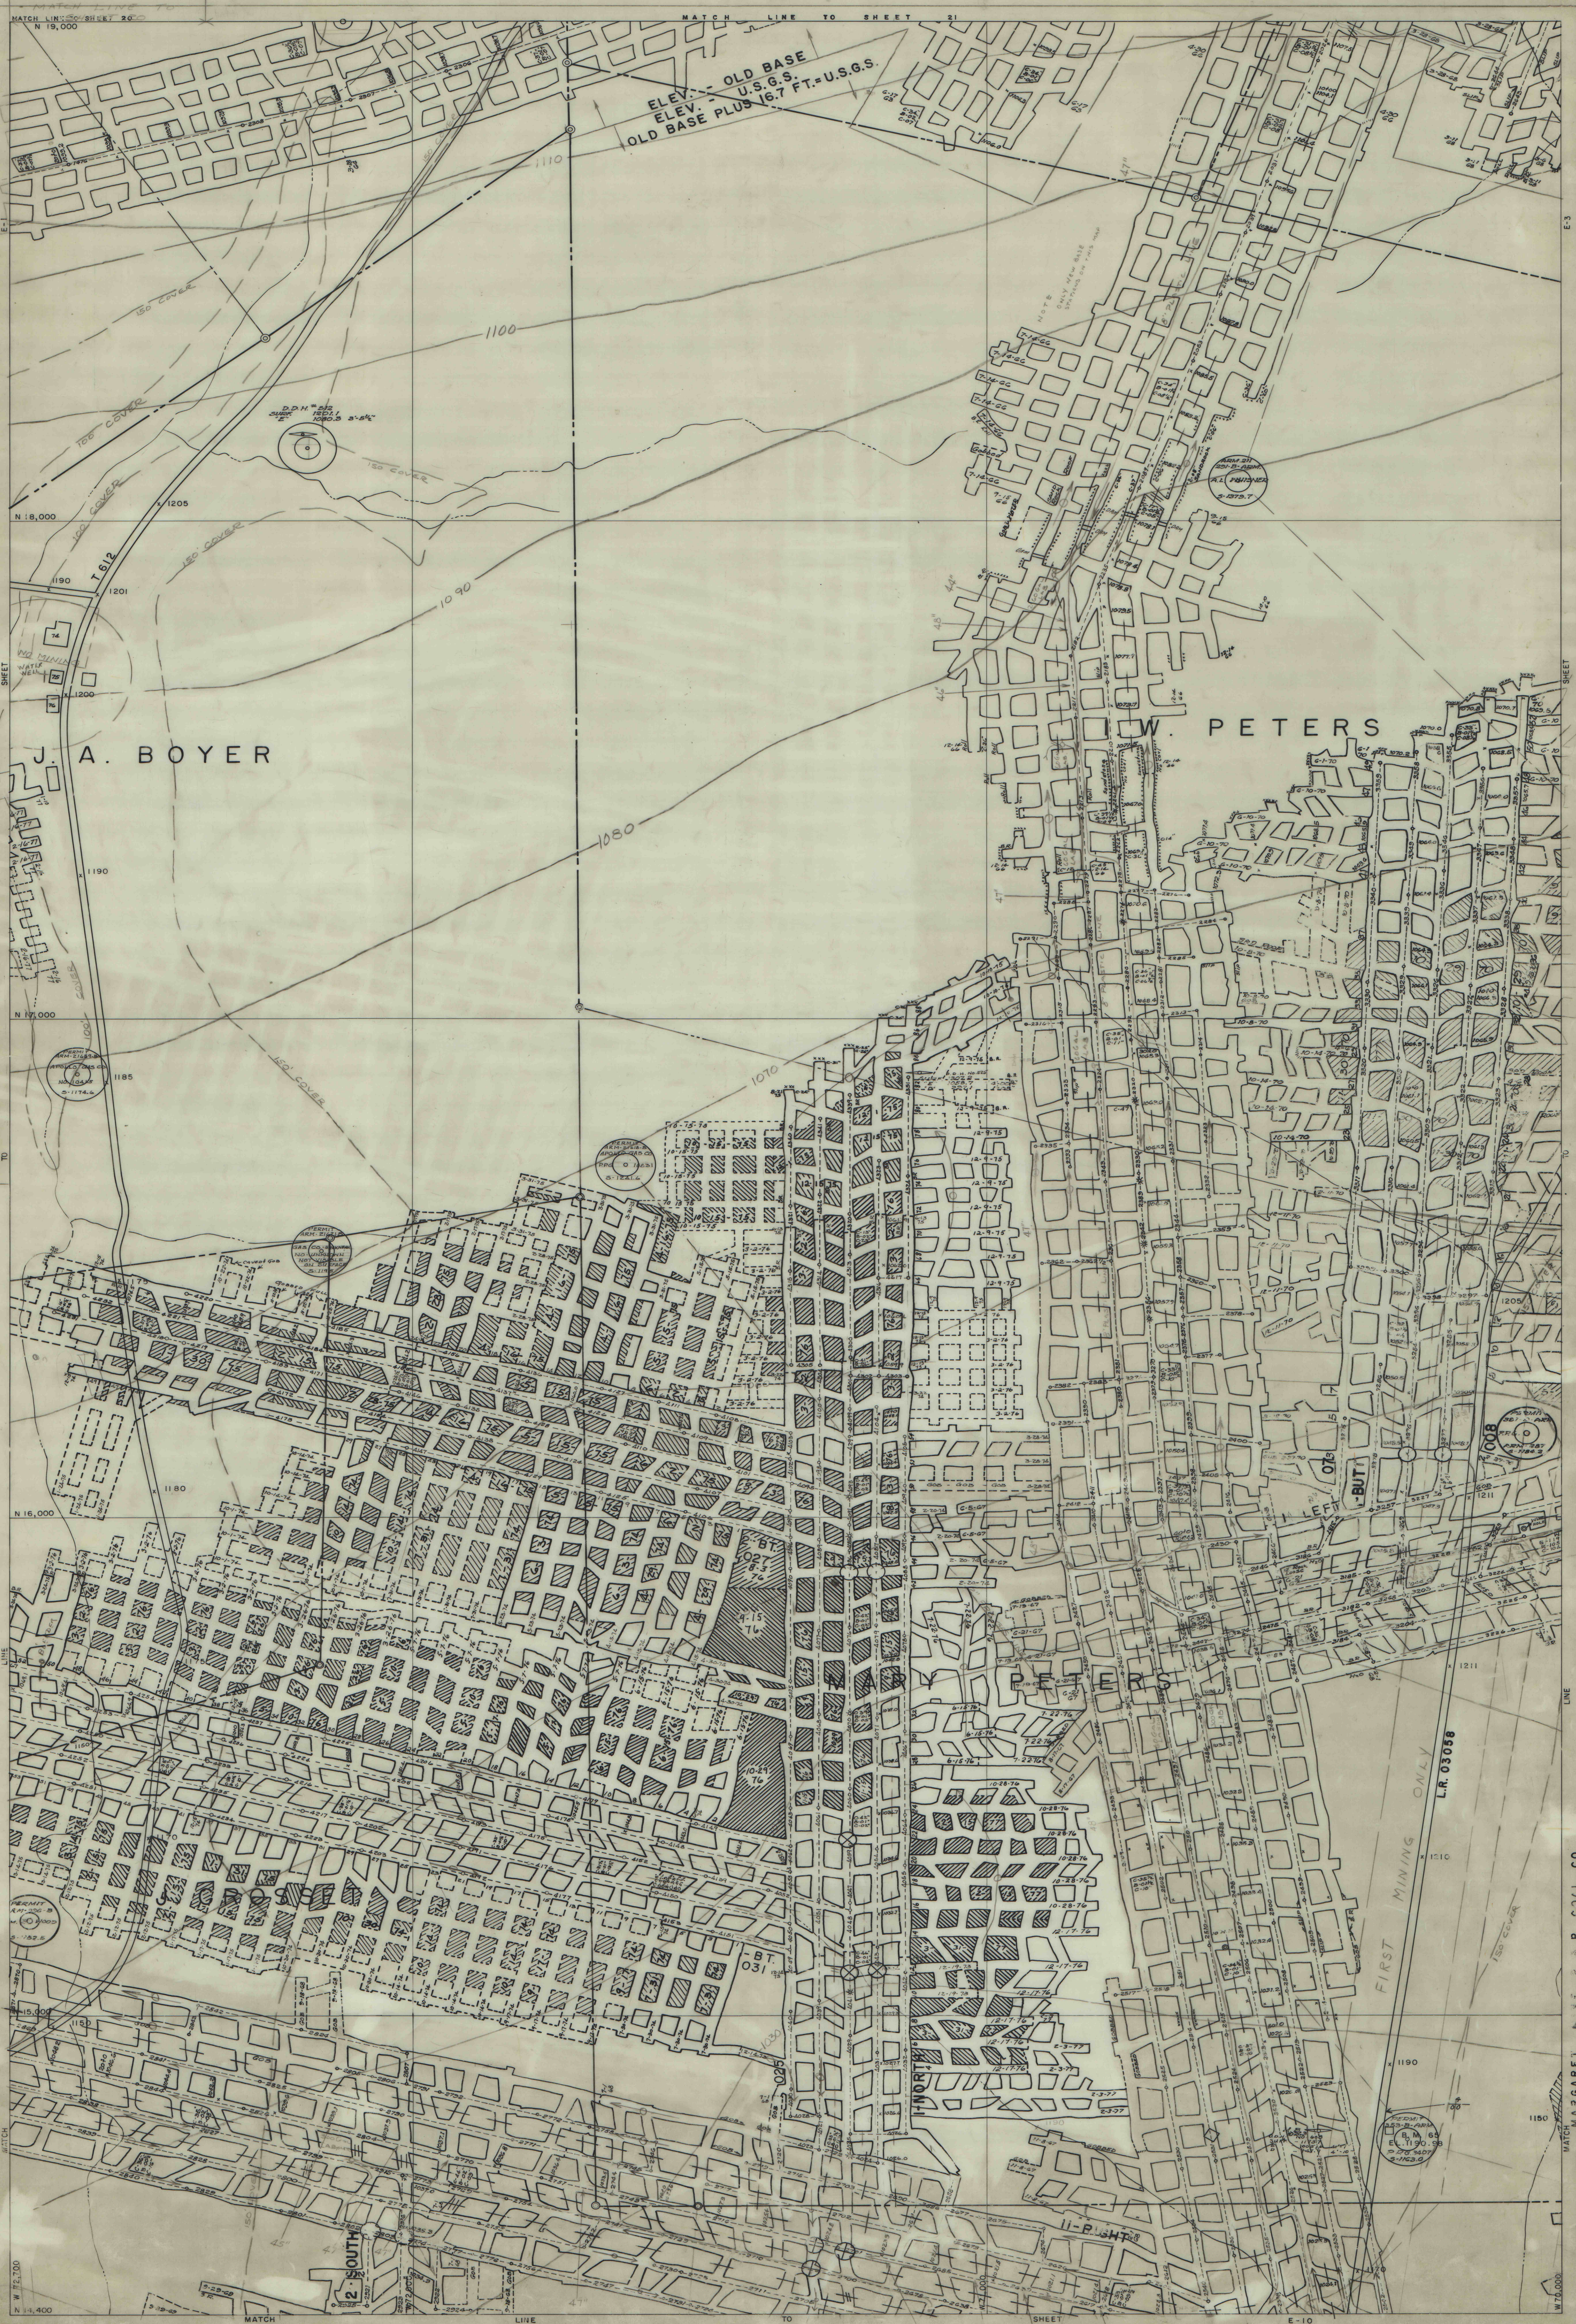

DRAWER 104

DRAWER 104

TRACING E-2

E-2

HC E-1

03 18 E-1 E-2 104