

E-9A


E-9A

TRACING

DRAWER 104

MARGARET MINE R. & P. COAL CO.
KITTINGING AND PLUM CREEK TWPS. ARMSTRONG CO.

E-9A

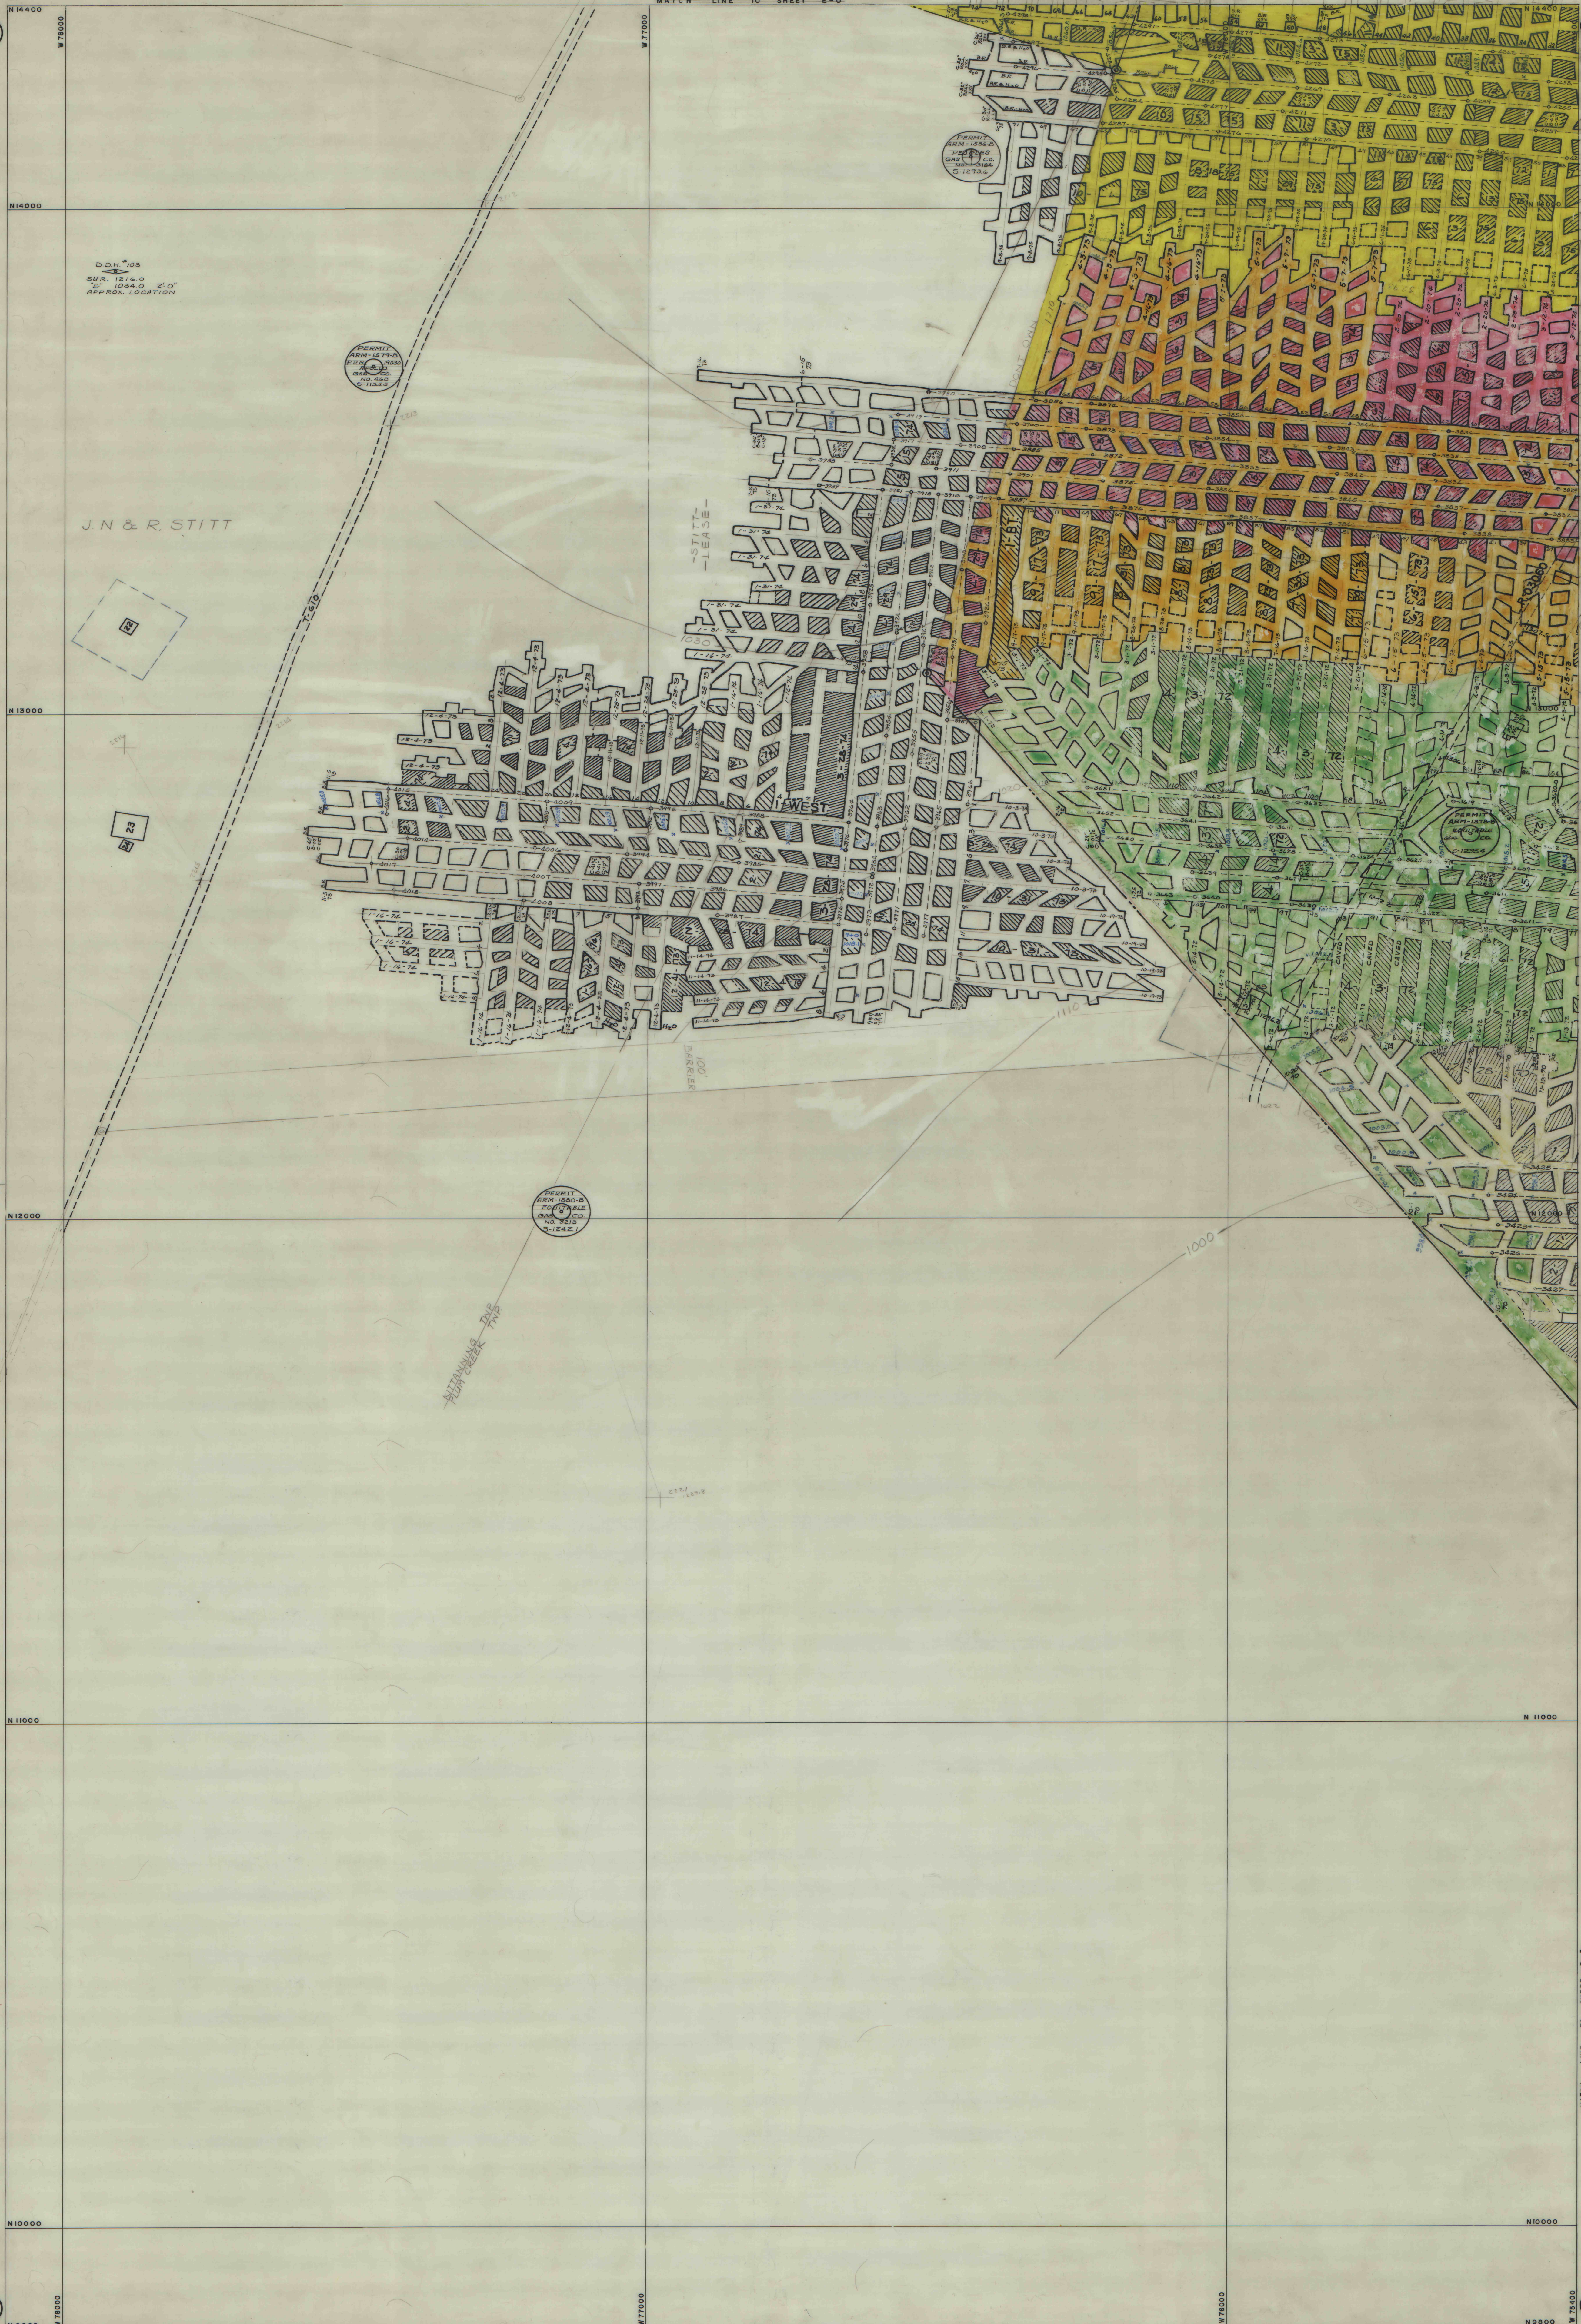

DRAWER 104

TRACING E-9A
EXTENSION TO
E-3 HARD COPY