


E-1

TRACING E-1

DRAWER 104

DRAWER 104

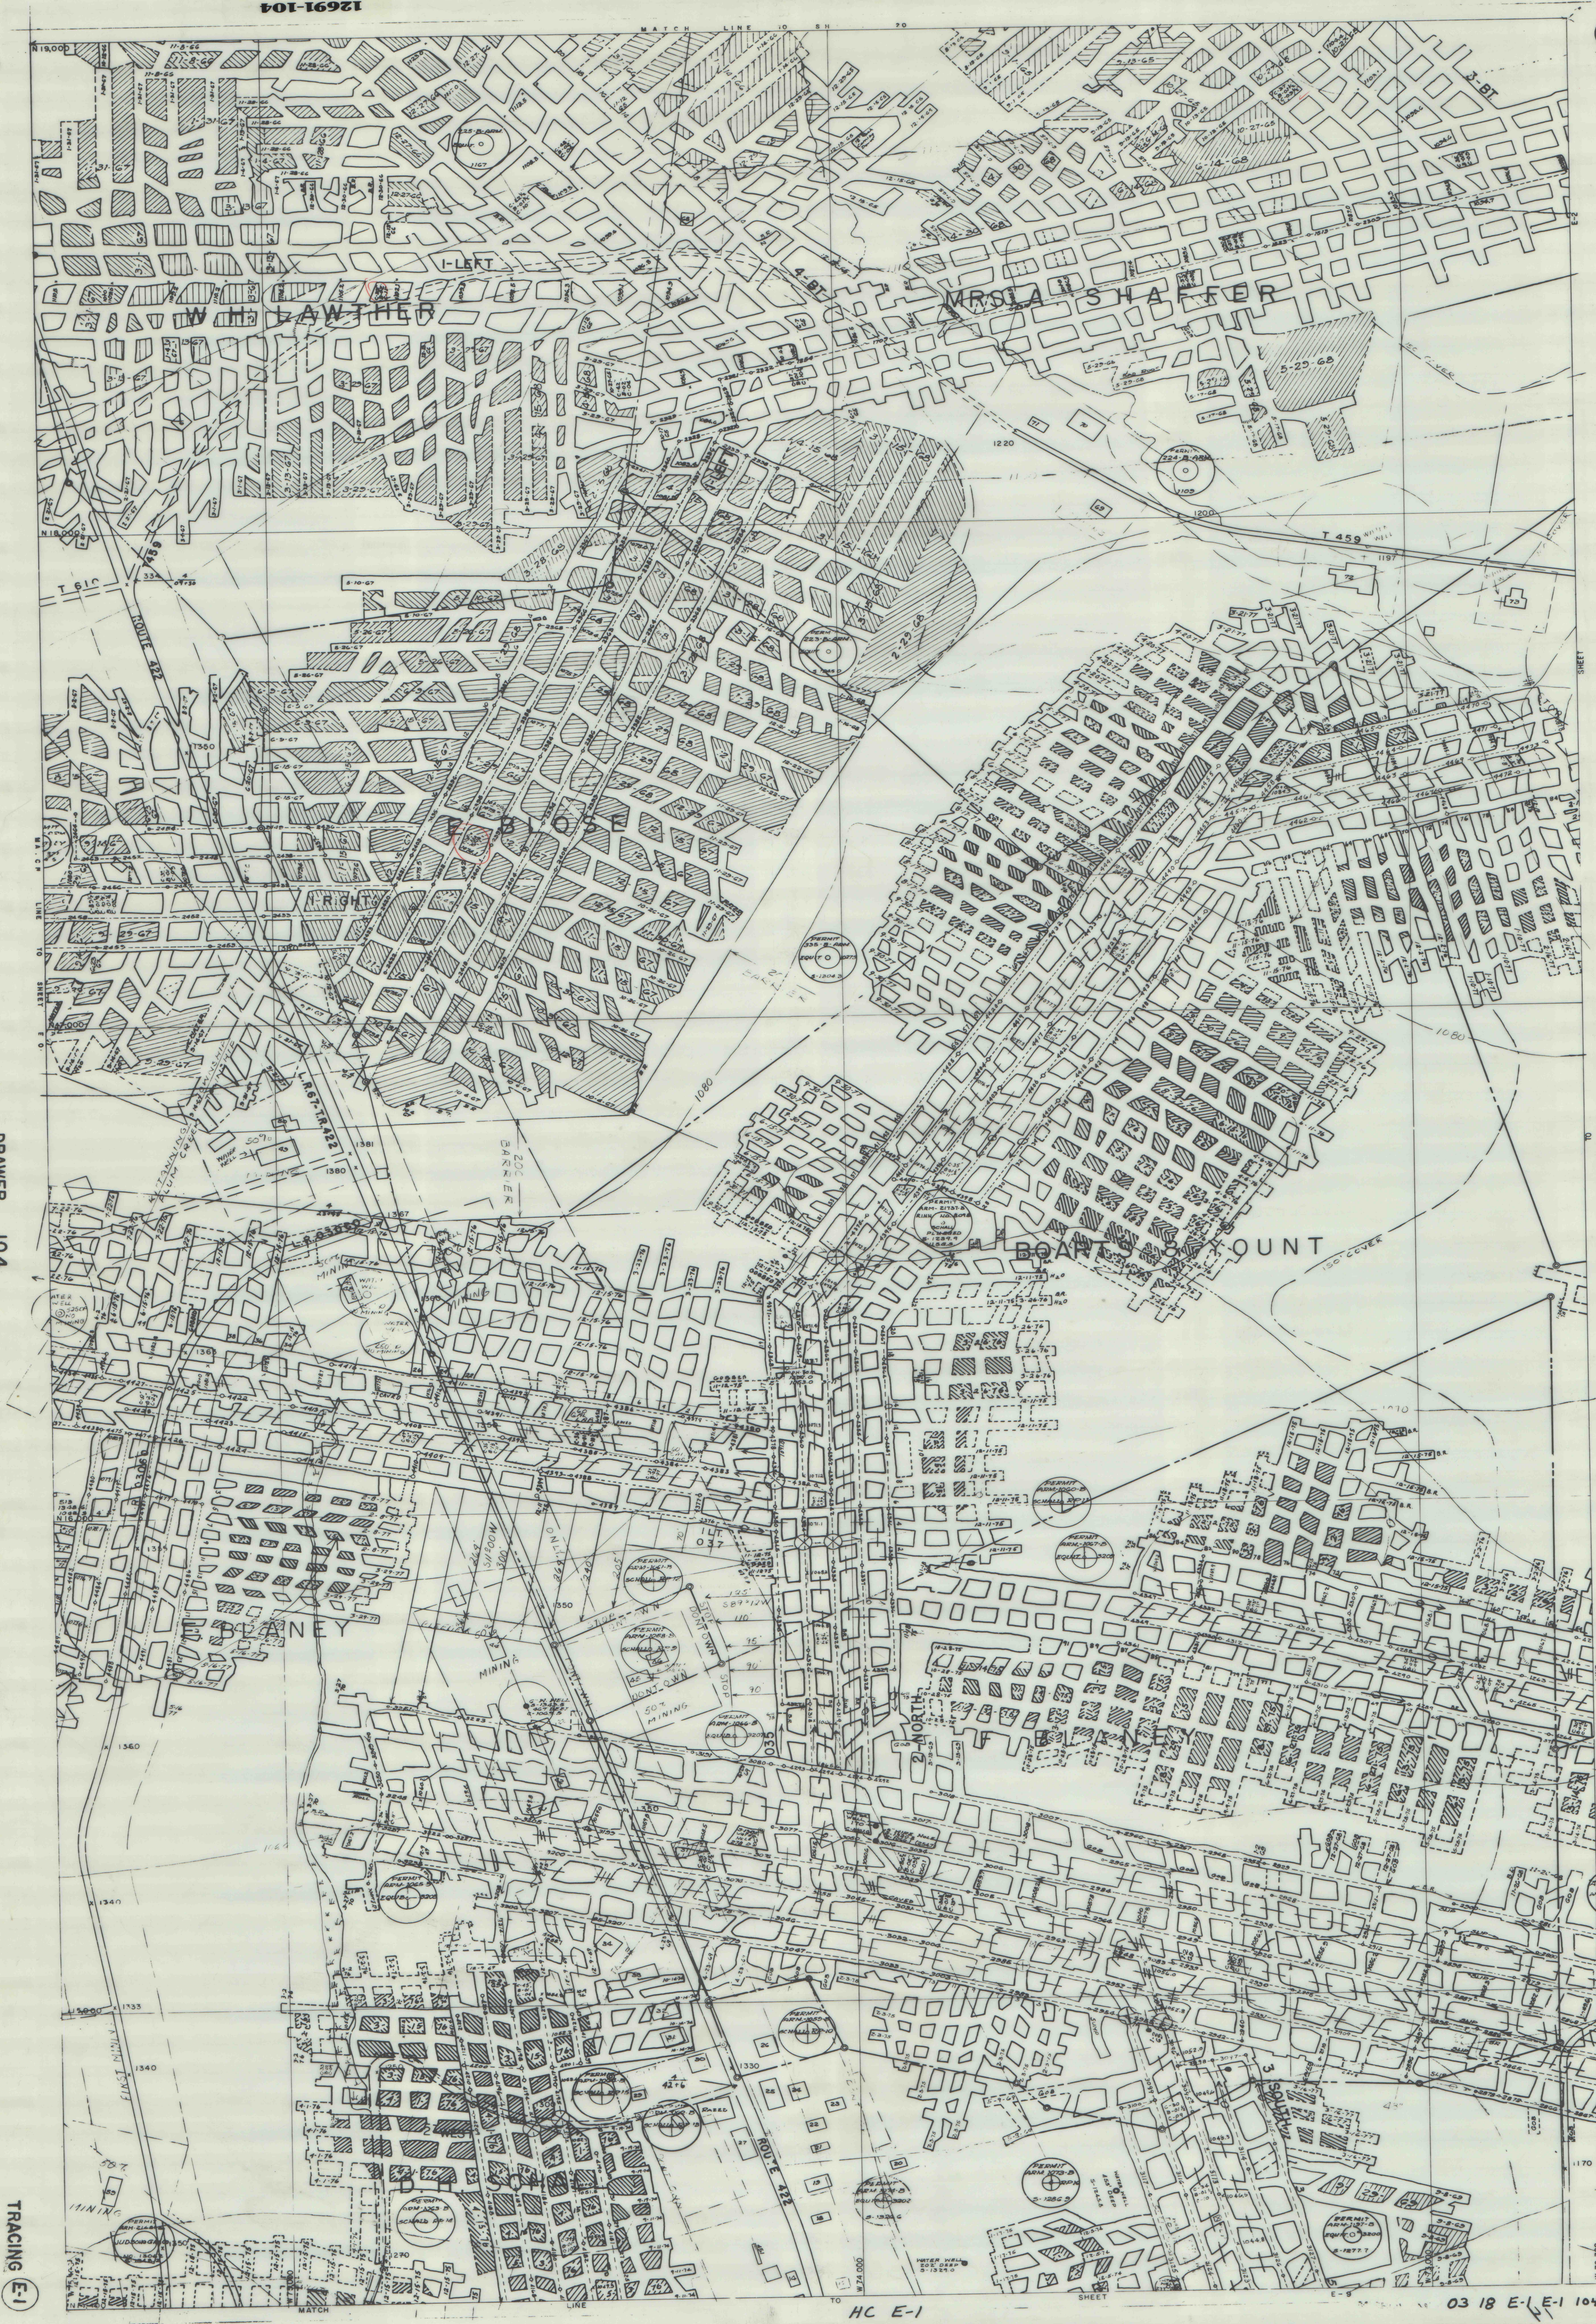

TRACING E-1

E-1

HC E-1

03 18 E-1 104

12691-104

