


TRACING E-2

DRAWER 104

E-2

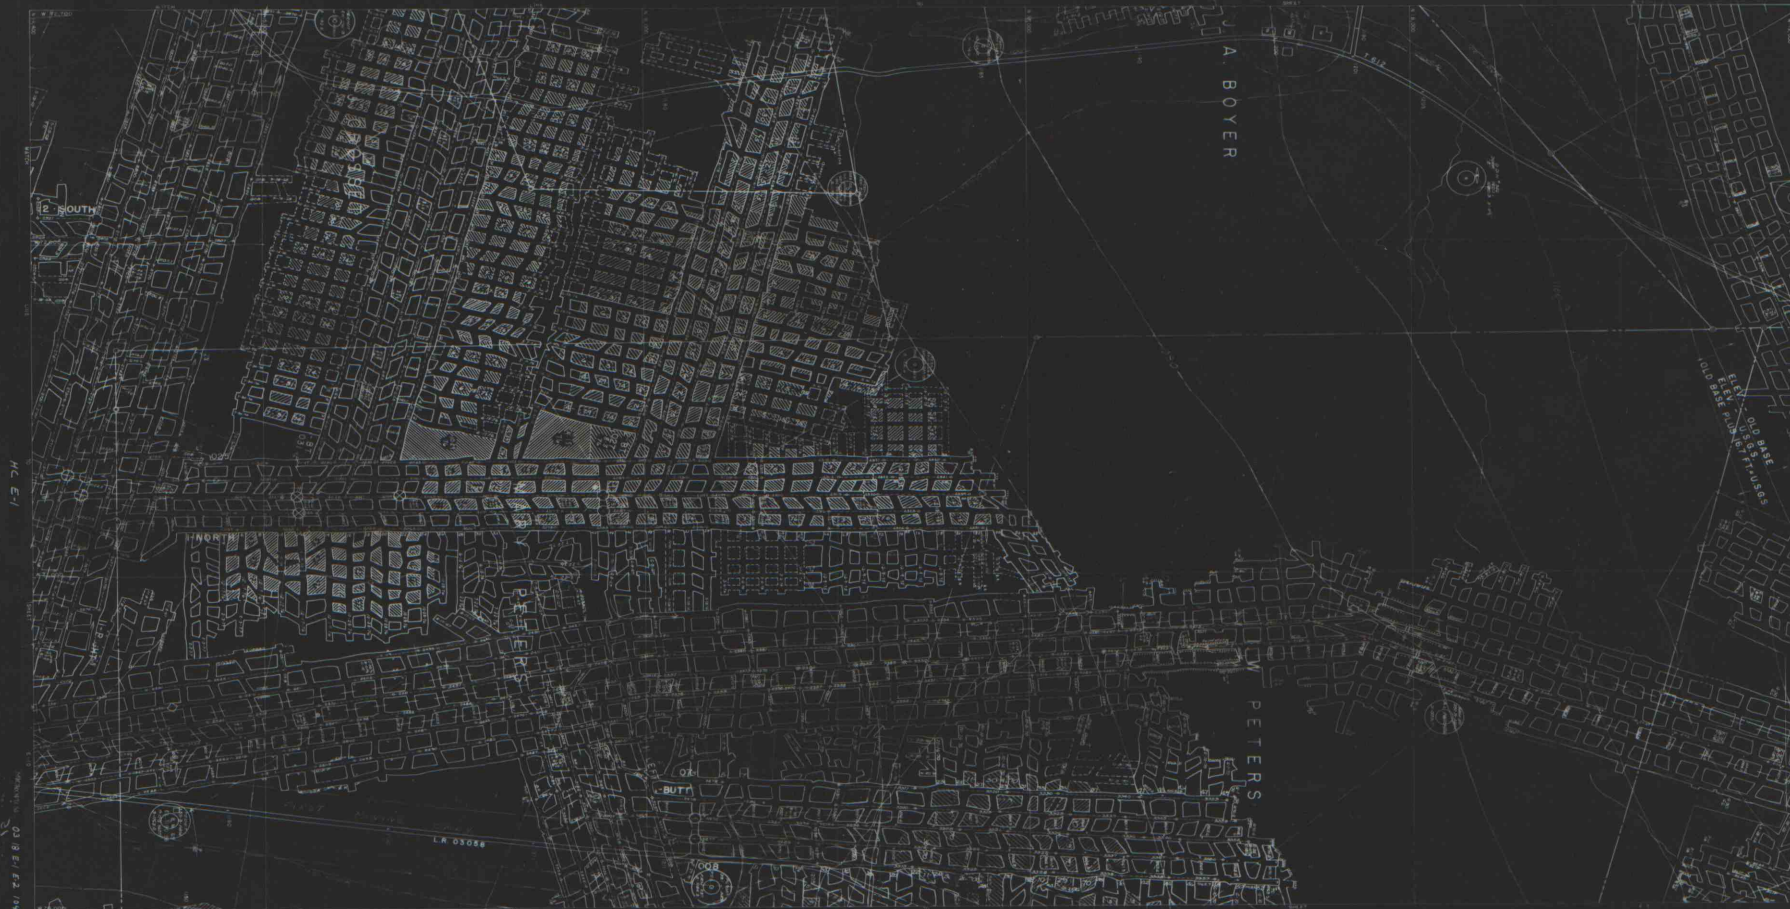

HC E-1

03 8 E/ E2 104

E-2

DRAWER 104

TRACING E-2

12692-104