




JAMES ROSS

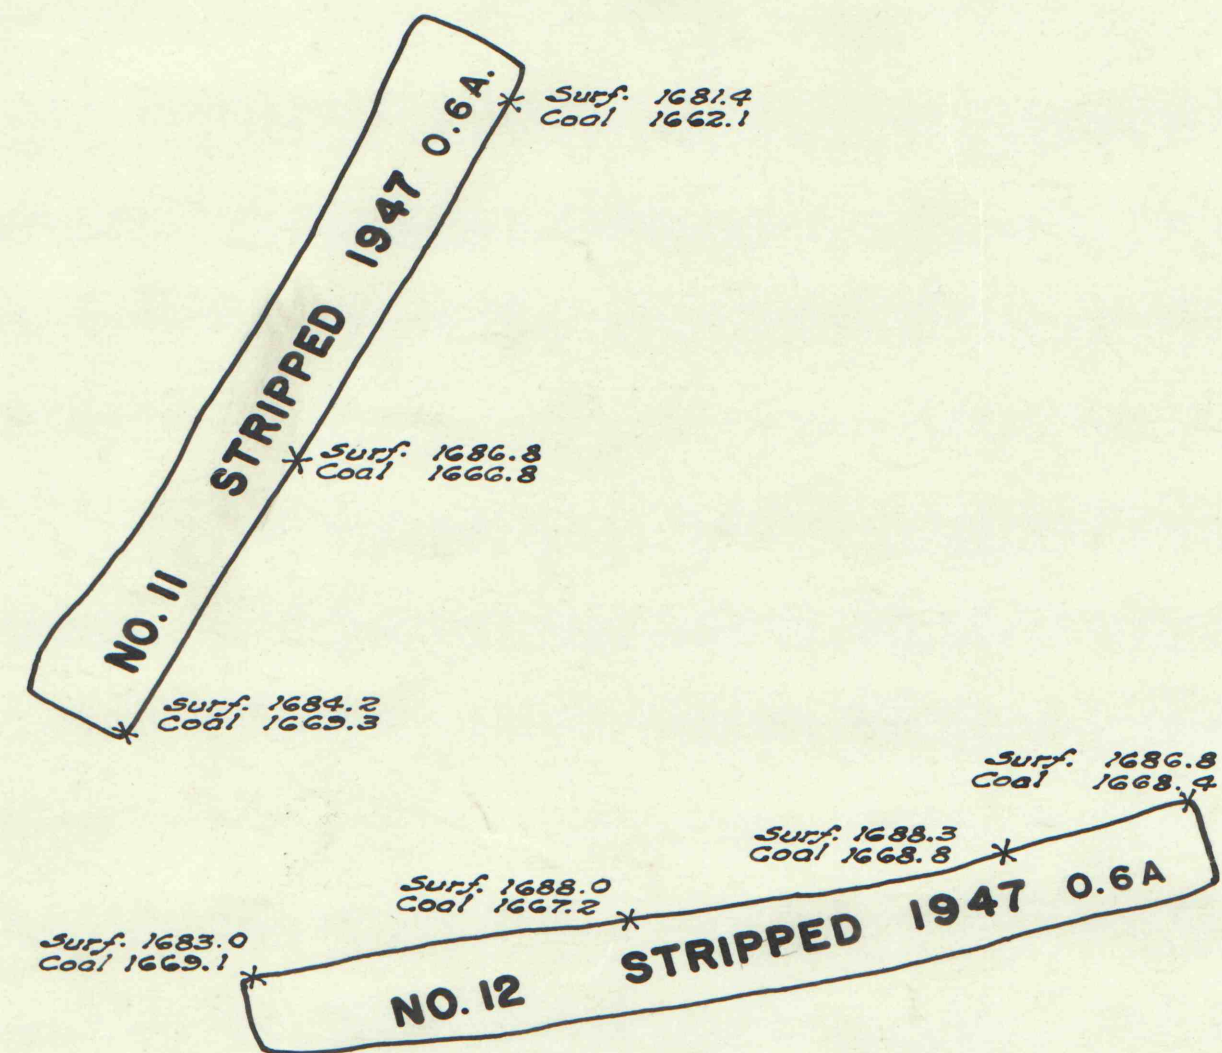

ROCHESTER AND PITTSBURGH COAL CO.
INDIANA PA.
BEECHTREE STRIP OPERATION
STRIP PIT NO. 11 & 12
JAMES ROSS TRACT
WASHINGTON TWP. JEFFERSON CO.
UPPER FREEPORT SEAM 34"
MAY 1948 SCALE 1"=100'