



F. D. MOTTERN

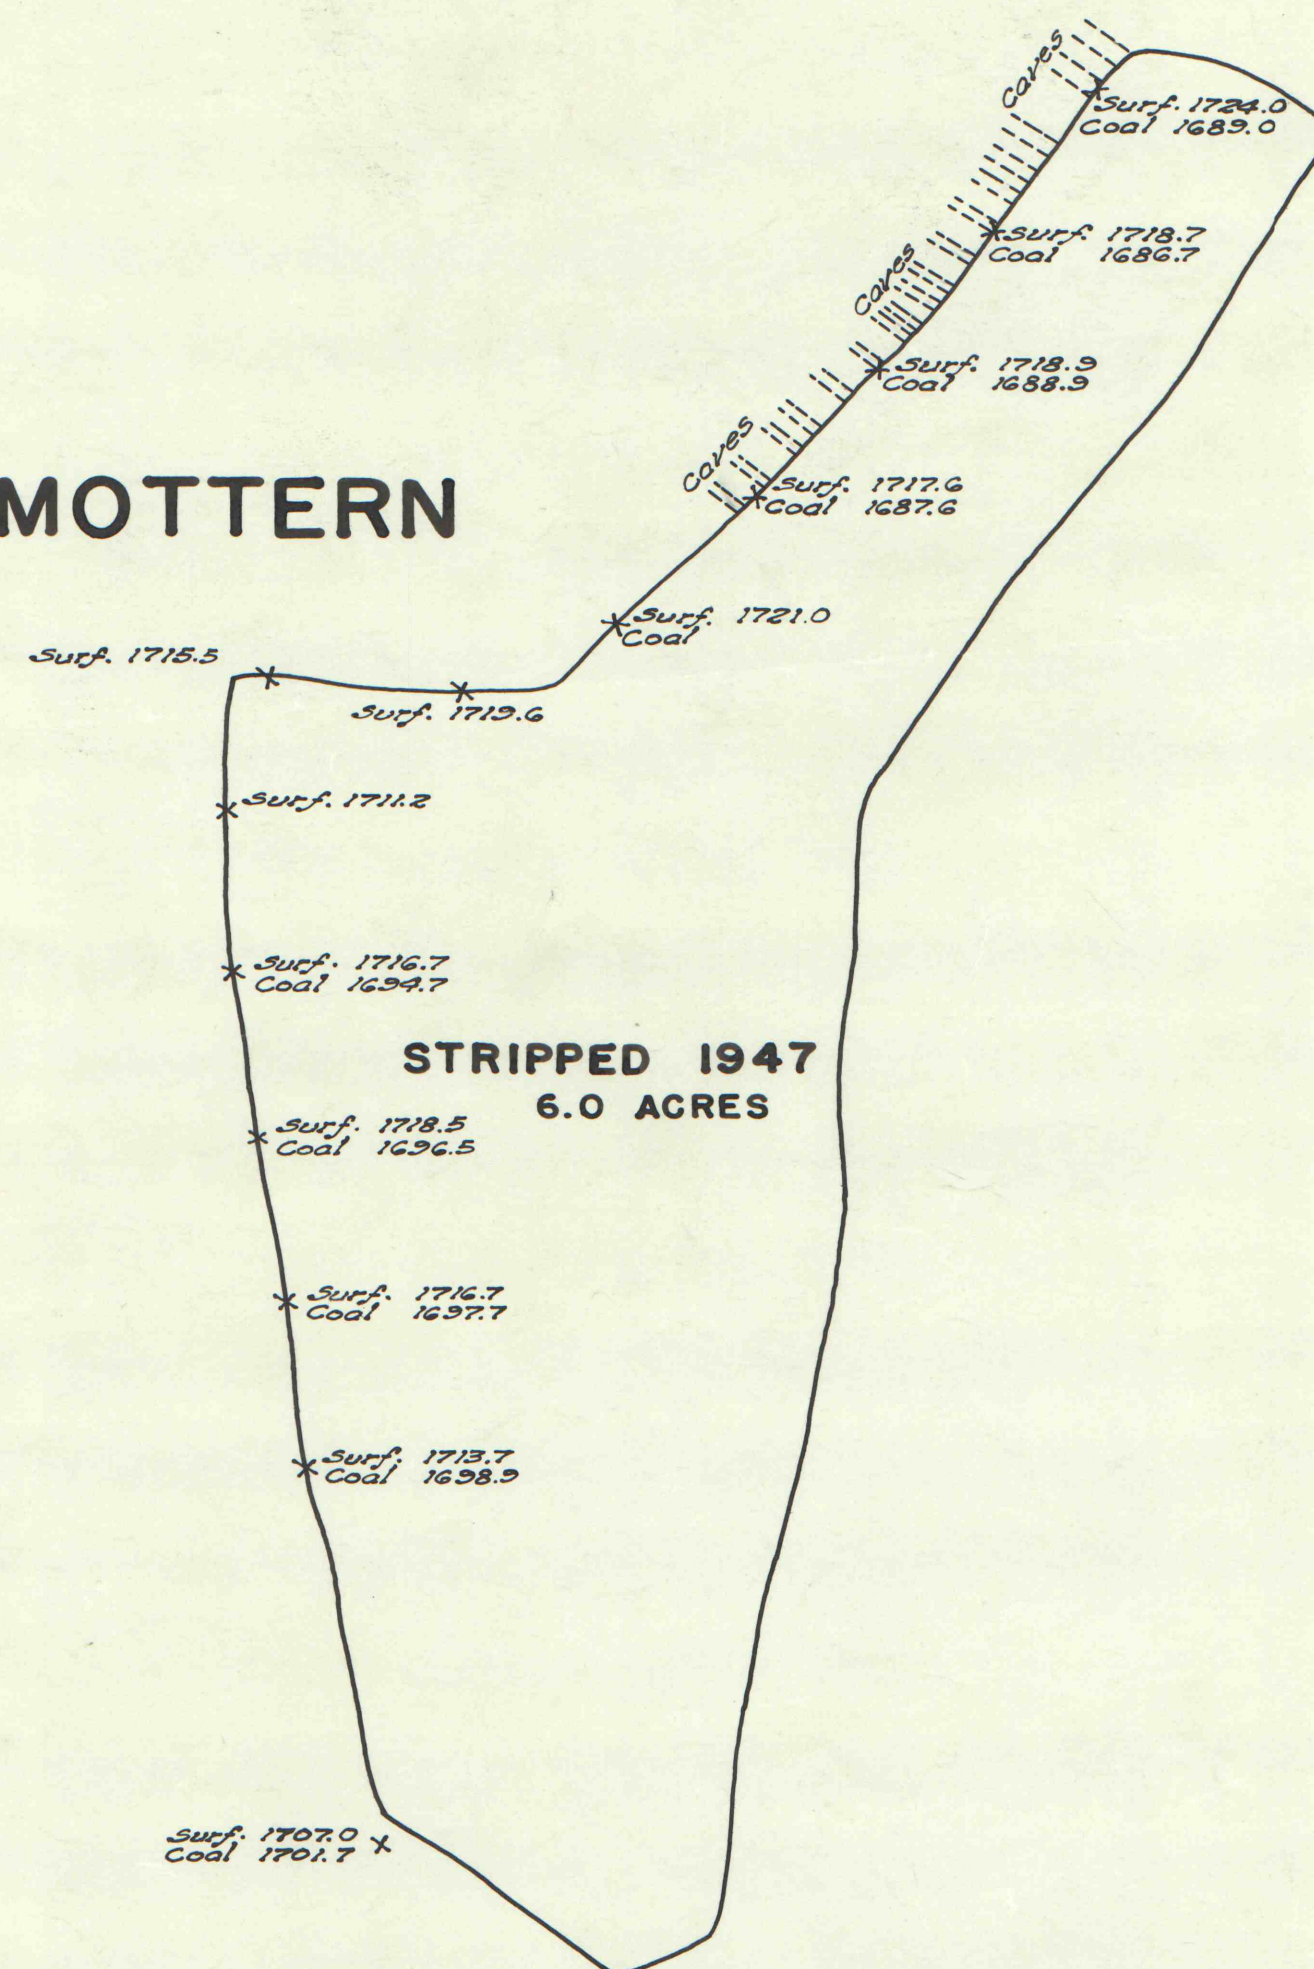

JOHN ROSS

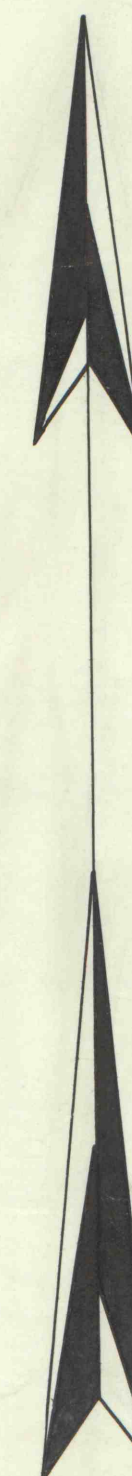

ROCHESTER AND PITTSBURGH COAL CO.
INDIANA PA.
BEECHTREE STRIP OPERATION
STRIP PIT NO. 7
F. D. MOTTERN TRACT
WASHINGTON TWP. JEFFERSON CO.
UPPER FREEPORT SEAM 34"
MARCH 1948 SCALE 1"=100'

12380-90