

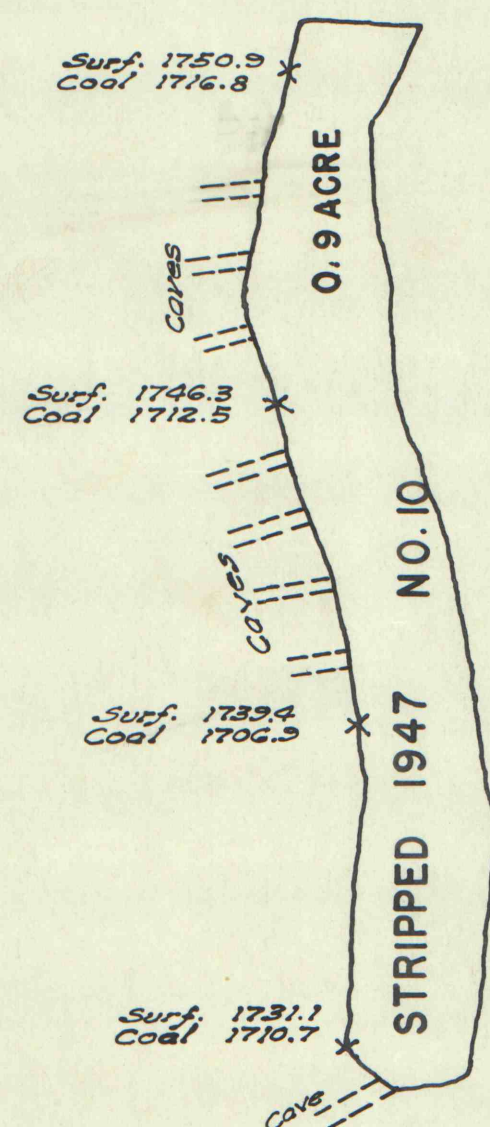


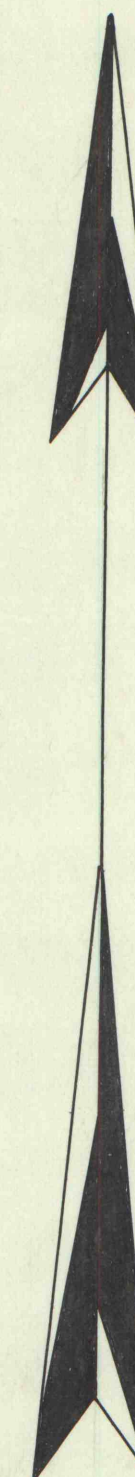

F. D. MOTTERN

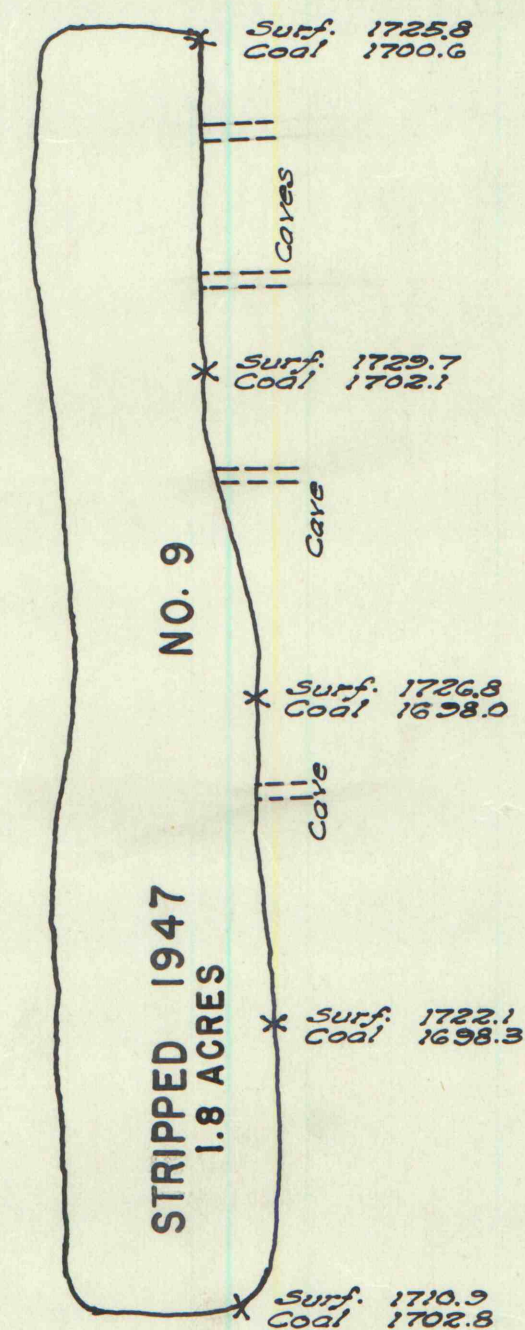

ROCHESTER AND PITTSBURGH COAL CO.
INDIANA, PA.
BEECHTREE STRIP OPERATION
STRIP PIT NO. 9 & 10
F. D. MOTTERN TRACT
WASHINGTON TWP JEFFERSON CO.
UPPER FREEPORT SEAM 34"
MAY 1948 SCALE 1"=100'