

APX-ASJ-8F-76


1960 (not planted in 1961)
 24,000
 10,000
 7,500
 5,000
 5,000
 1,000

J. H. FULTON TRACT (Tract No. 995)
 3-0 Scotch Pine (Austrian)
 3-0 " (French)
 3-0 Douglas Fir
 3-0 Colo. Spruce
 3-0 Fraser Fir

6-10"
 6-12"
 4-8"
 5 to 9"
 5 to 9"
 3 to 5"

F. & T. Nursery
 Bennett Nursery
 Burkett Nursery
 Schroth Nursery

SCALE 1" = 660'

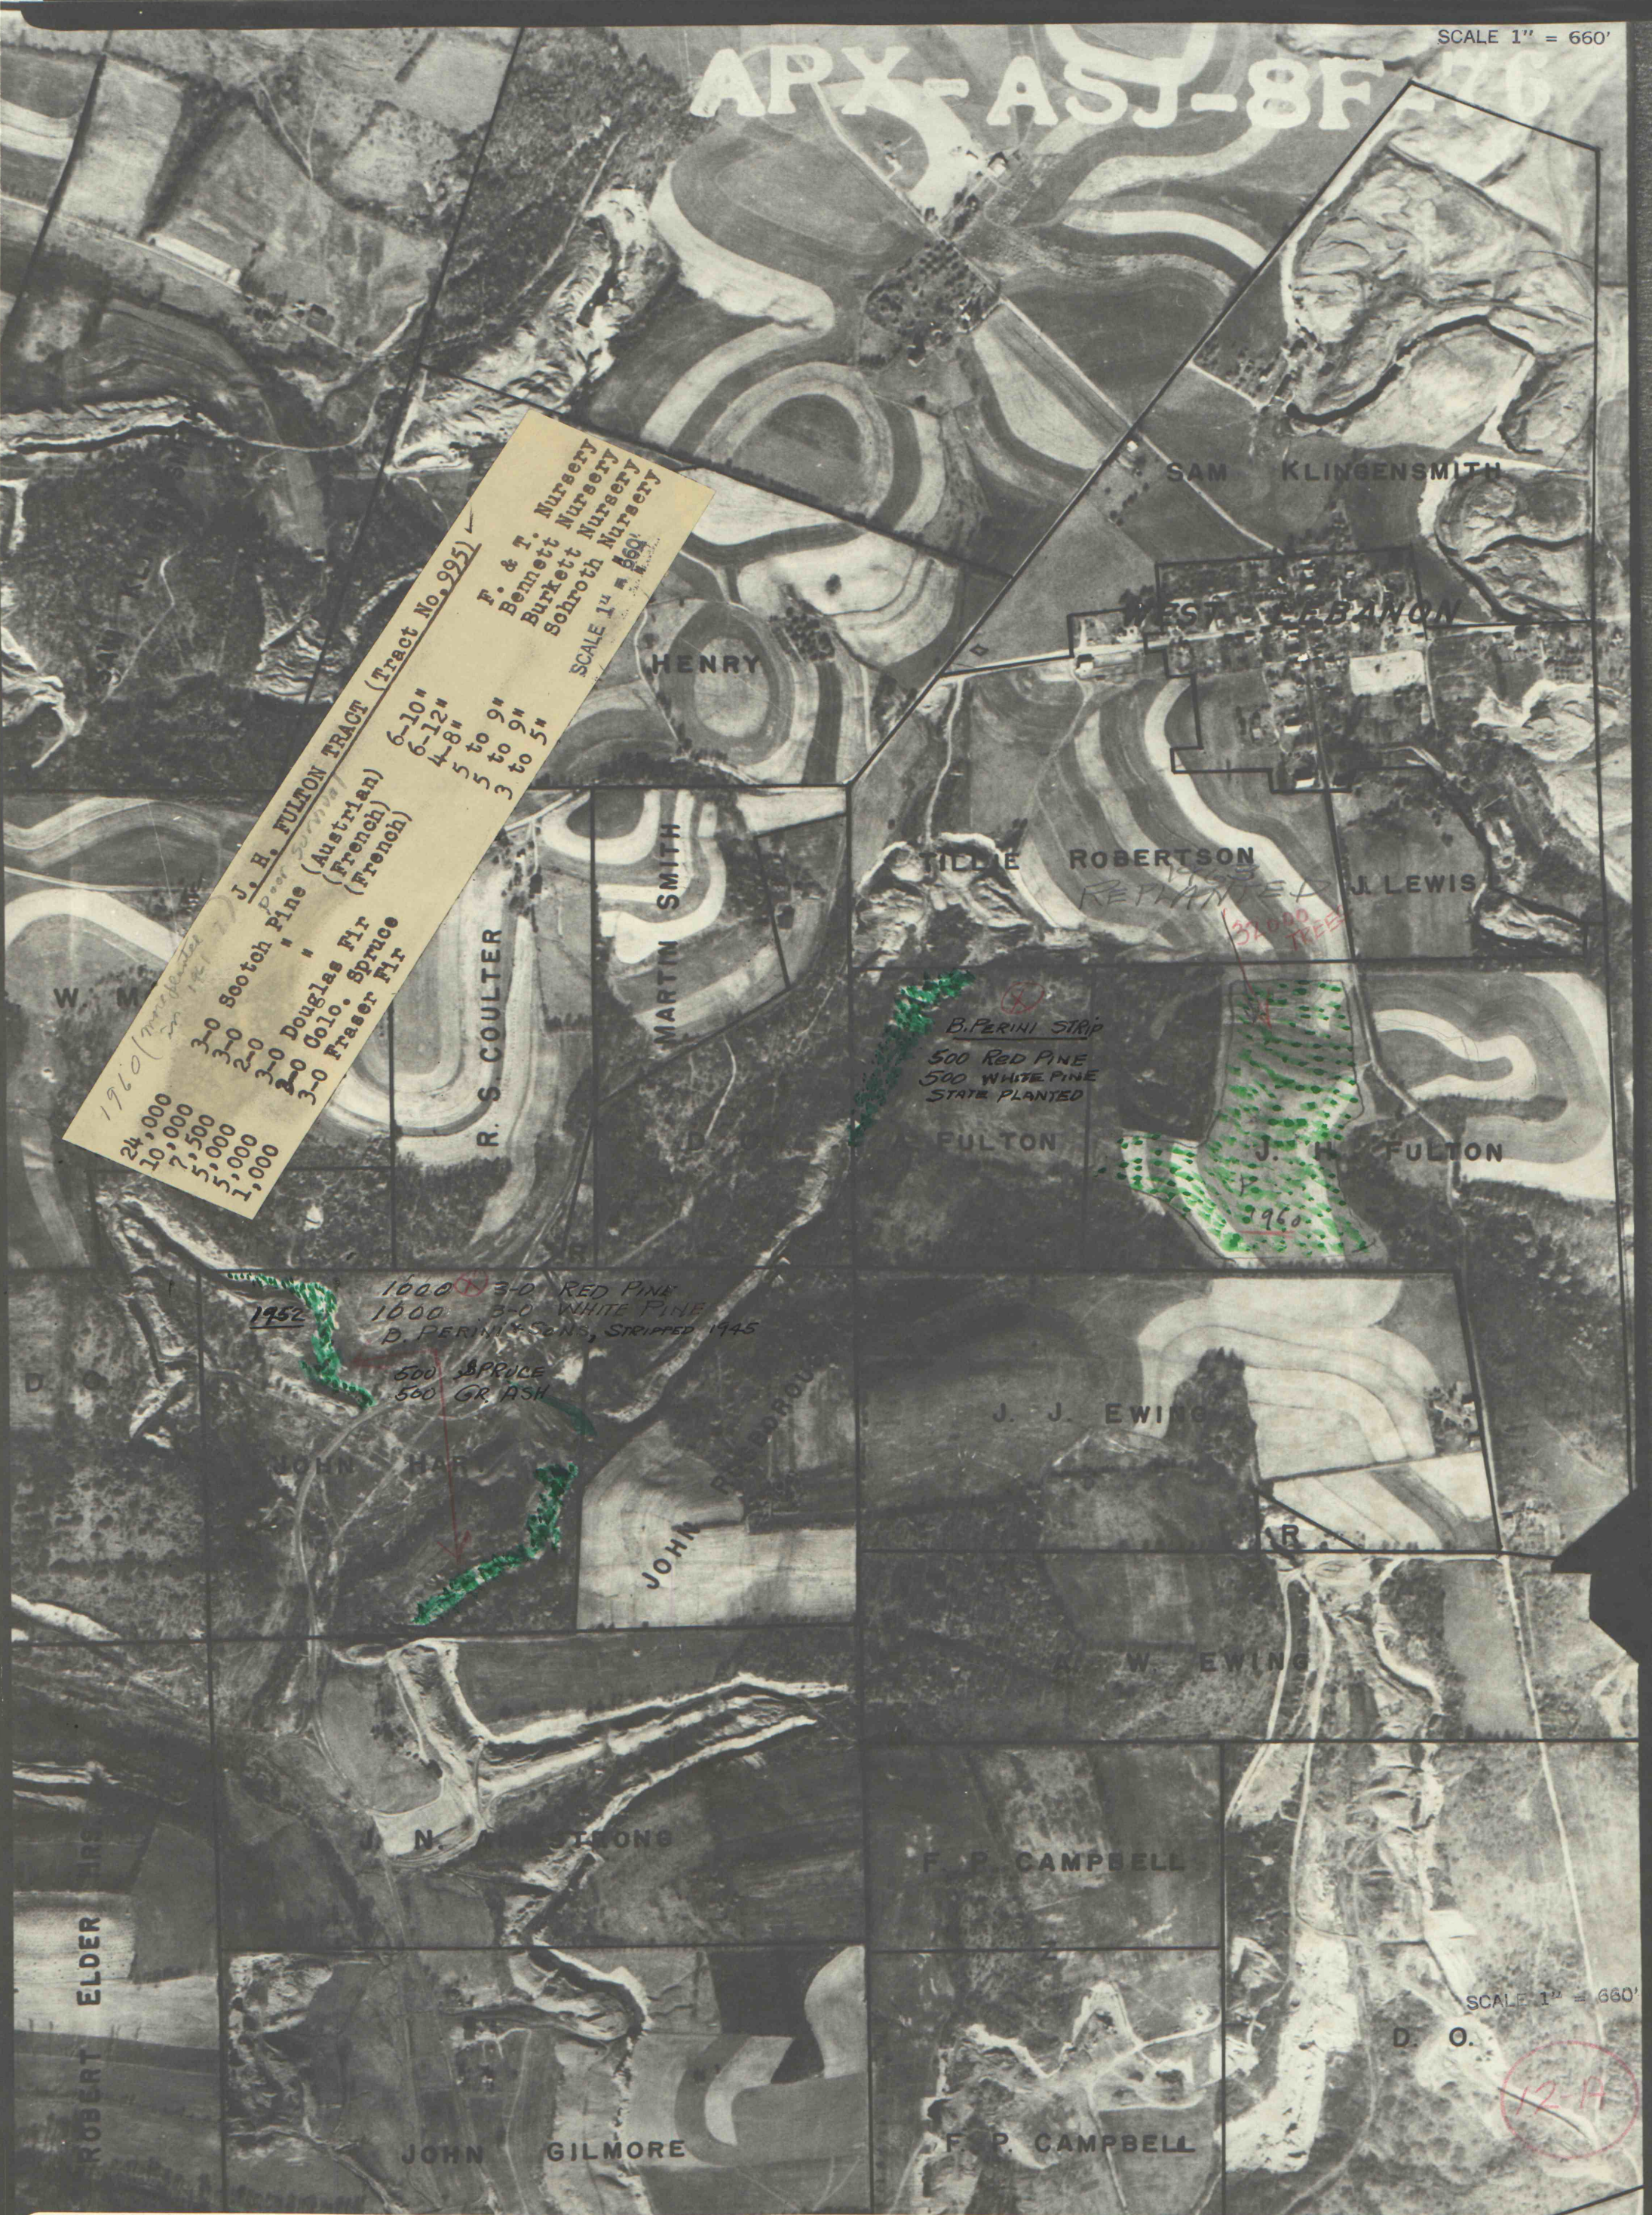

12-A