


A. H. SMITH

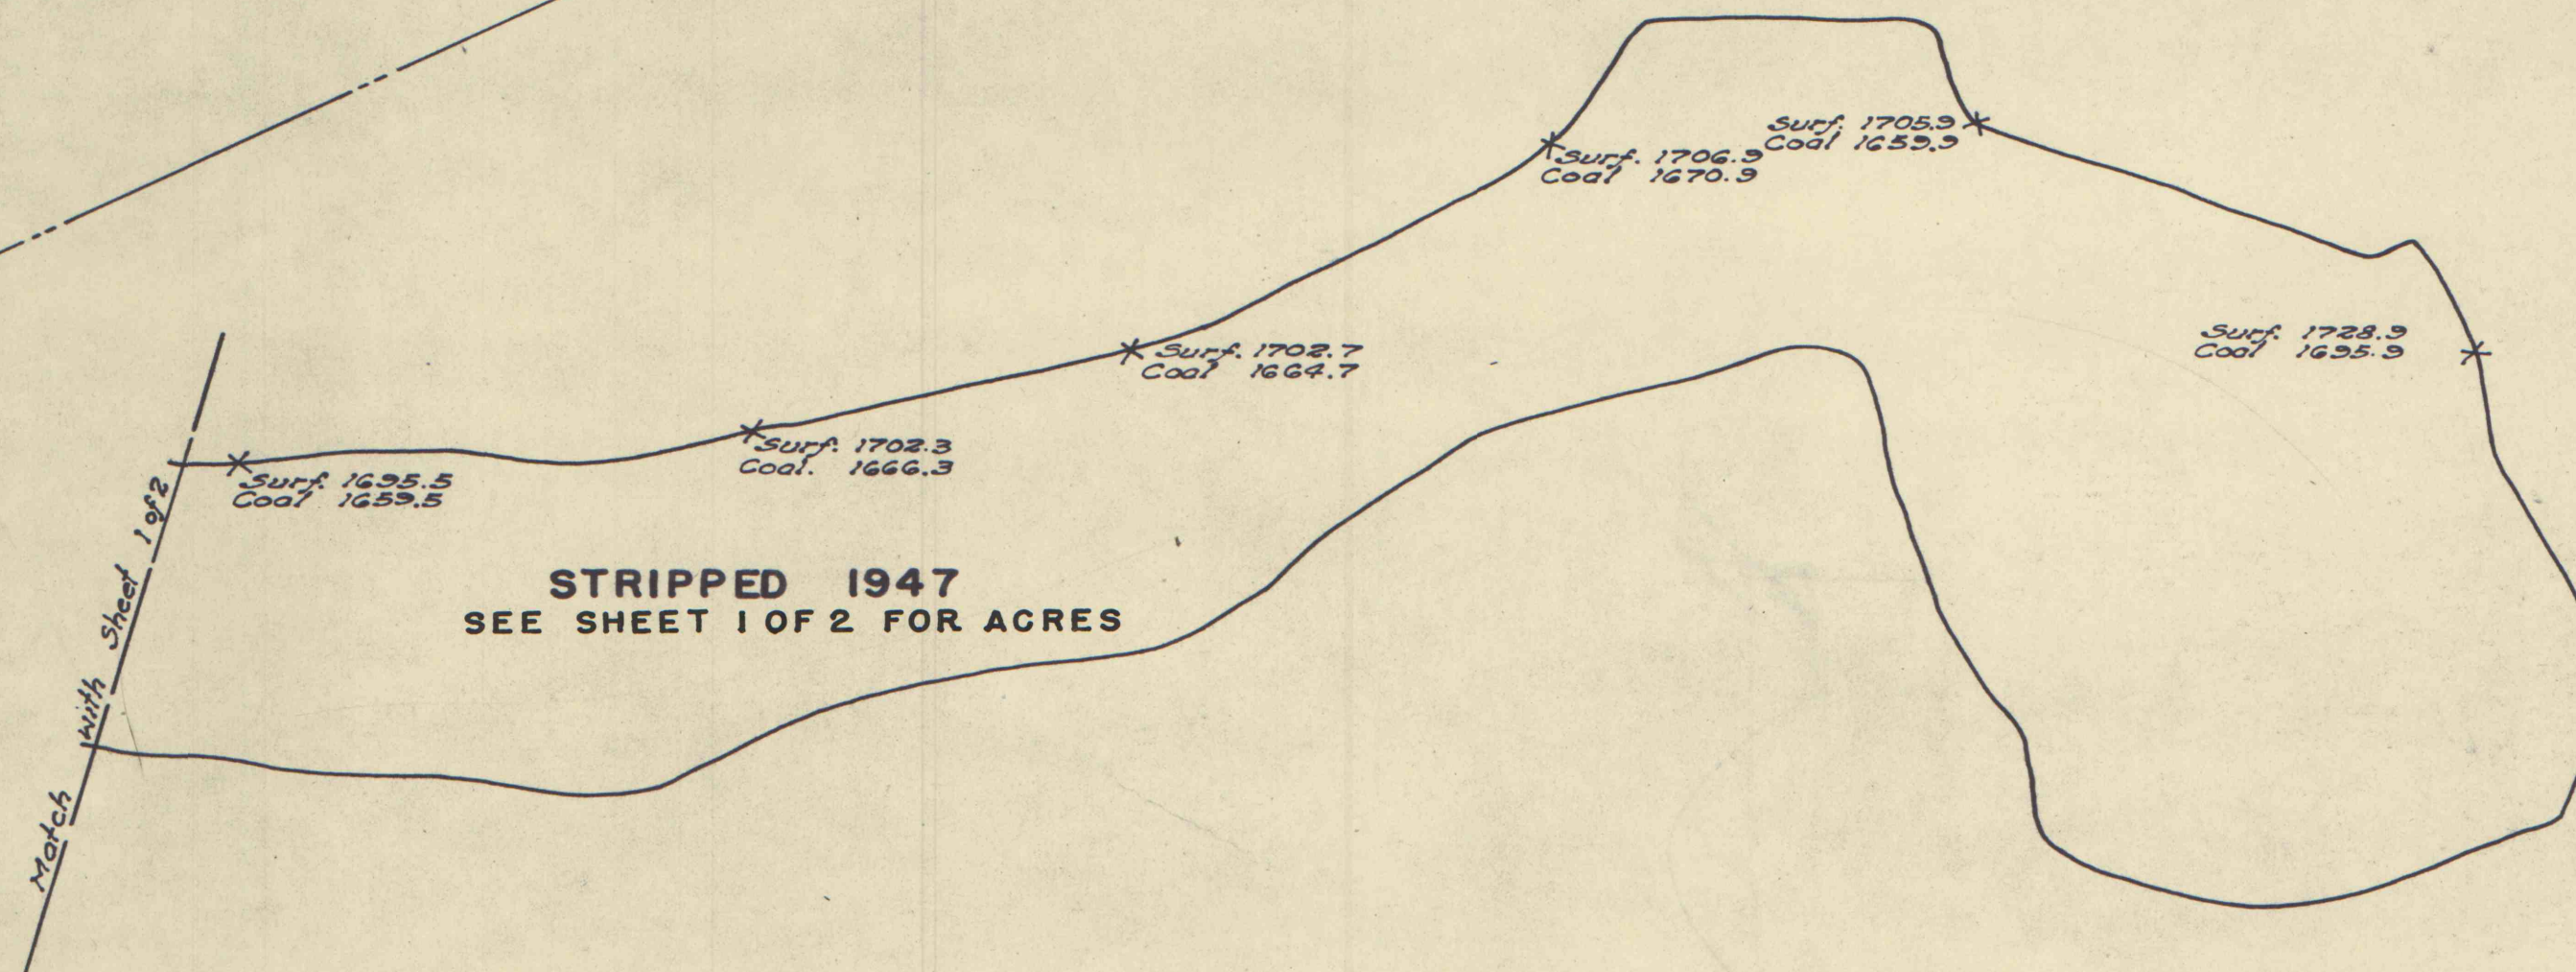

WILLIAM DAUGHERTY

ROCHESTER AND PITTSBURGH COAL CO.
INDIANA PA.
BEECHTREE STRIP OPERATION
STRIP PIT NO. 1
WILLIAM DAUGHERTY AND A. H. SMITH
WASHINGTON TWP JEFFERSON CO.
UPPER FREEPORT SEAM 34"
MARCH 1948 SCALE 1"=100'