


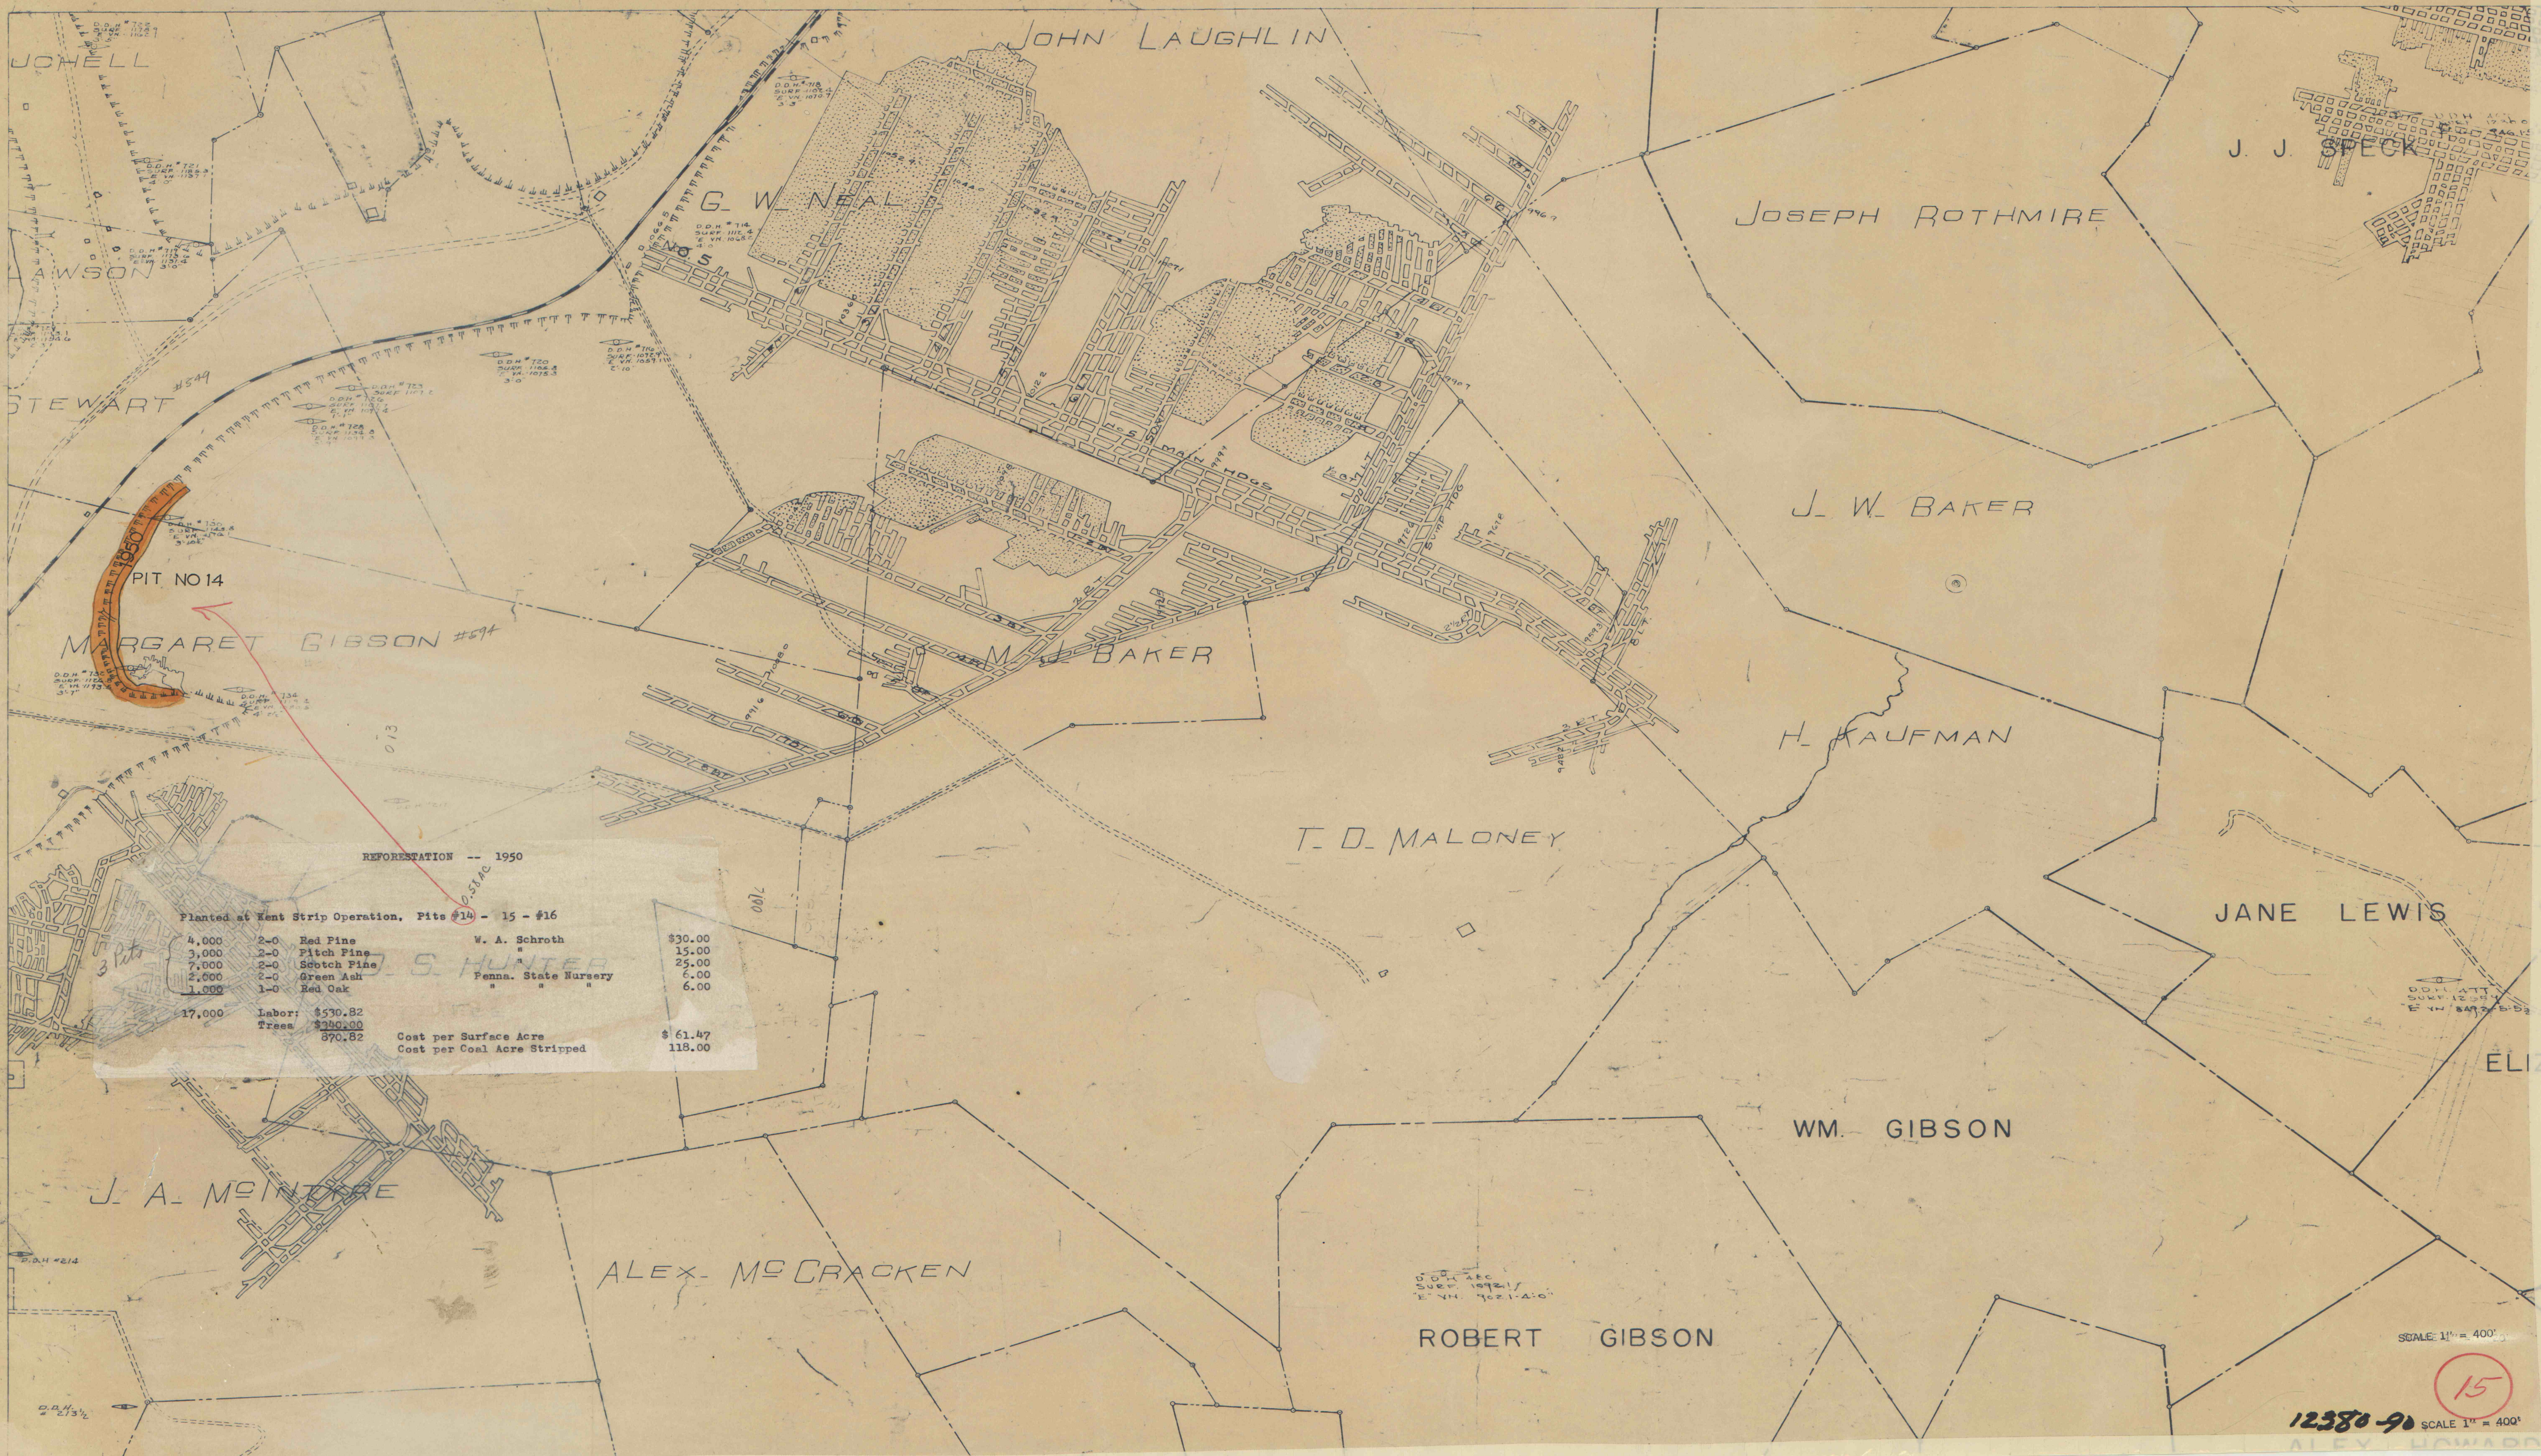

Planted at Kent Strip Operation, Pits #14 - 15 - #16

4,000	2-0	Red Pine	W. A. Schroth	\$30.00
3,000	2-0	Pitch Pine	"	15.00
7,000	2-0	Scotch Pine	"	25.00
2,000	2-0	Green Ash	Penna. State Nursery	6.00
1,000	1-0	Red Oak	"	6.00
17,000		Labor:	\$530.82	
			870.82	
		Cost per Surface Acre	\$ 61.47	
		Cost per Coal Acre Stripped	118.00	

SCALE 1" = 400'

15

12380-90 SCALE 1" = 400'