


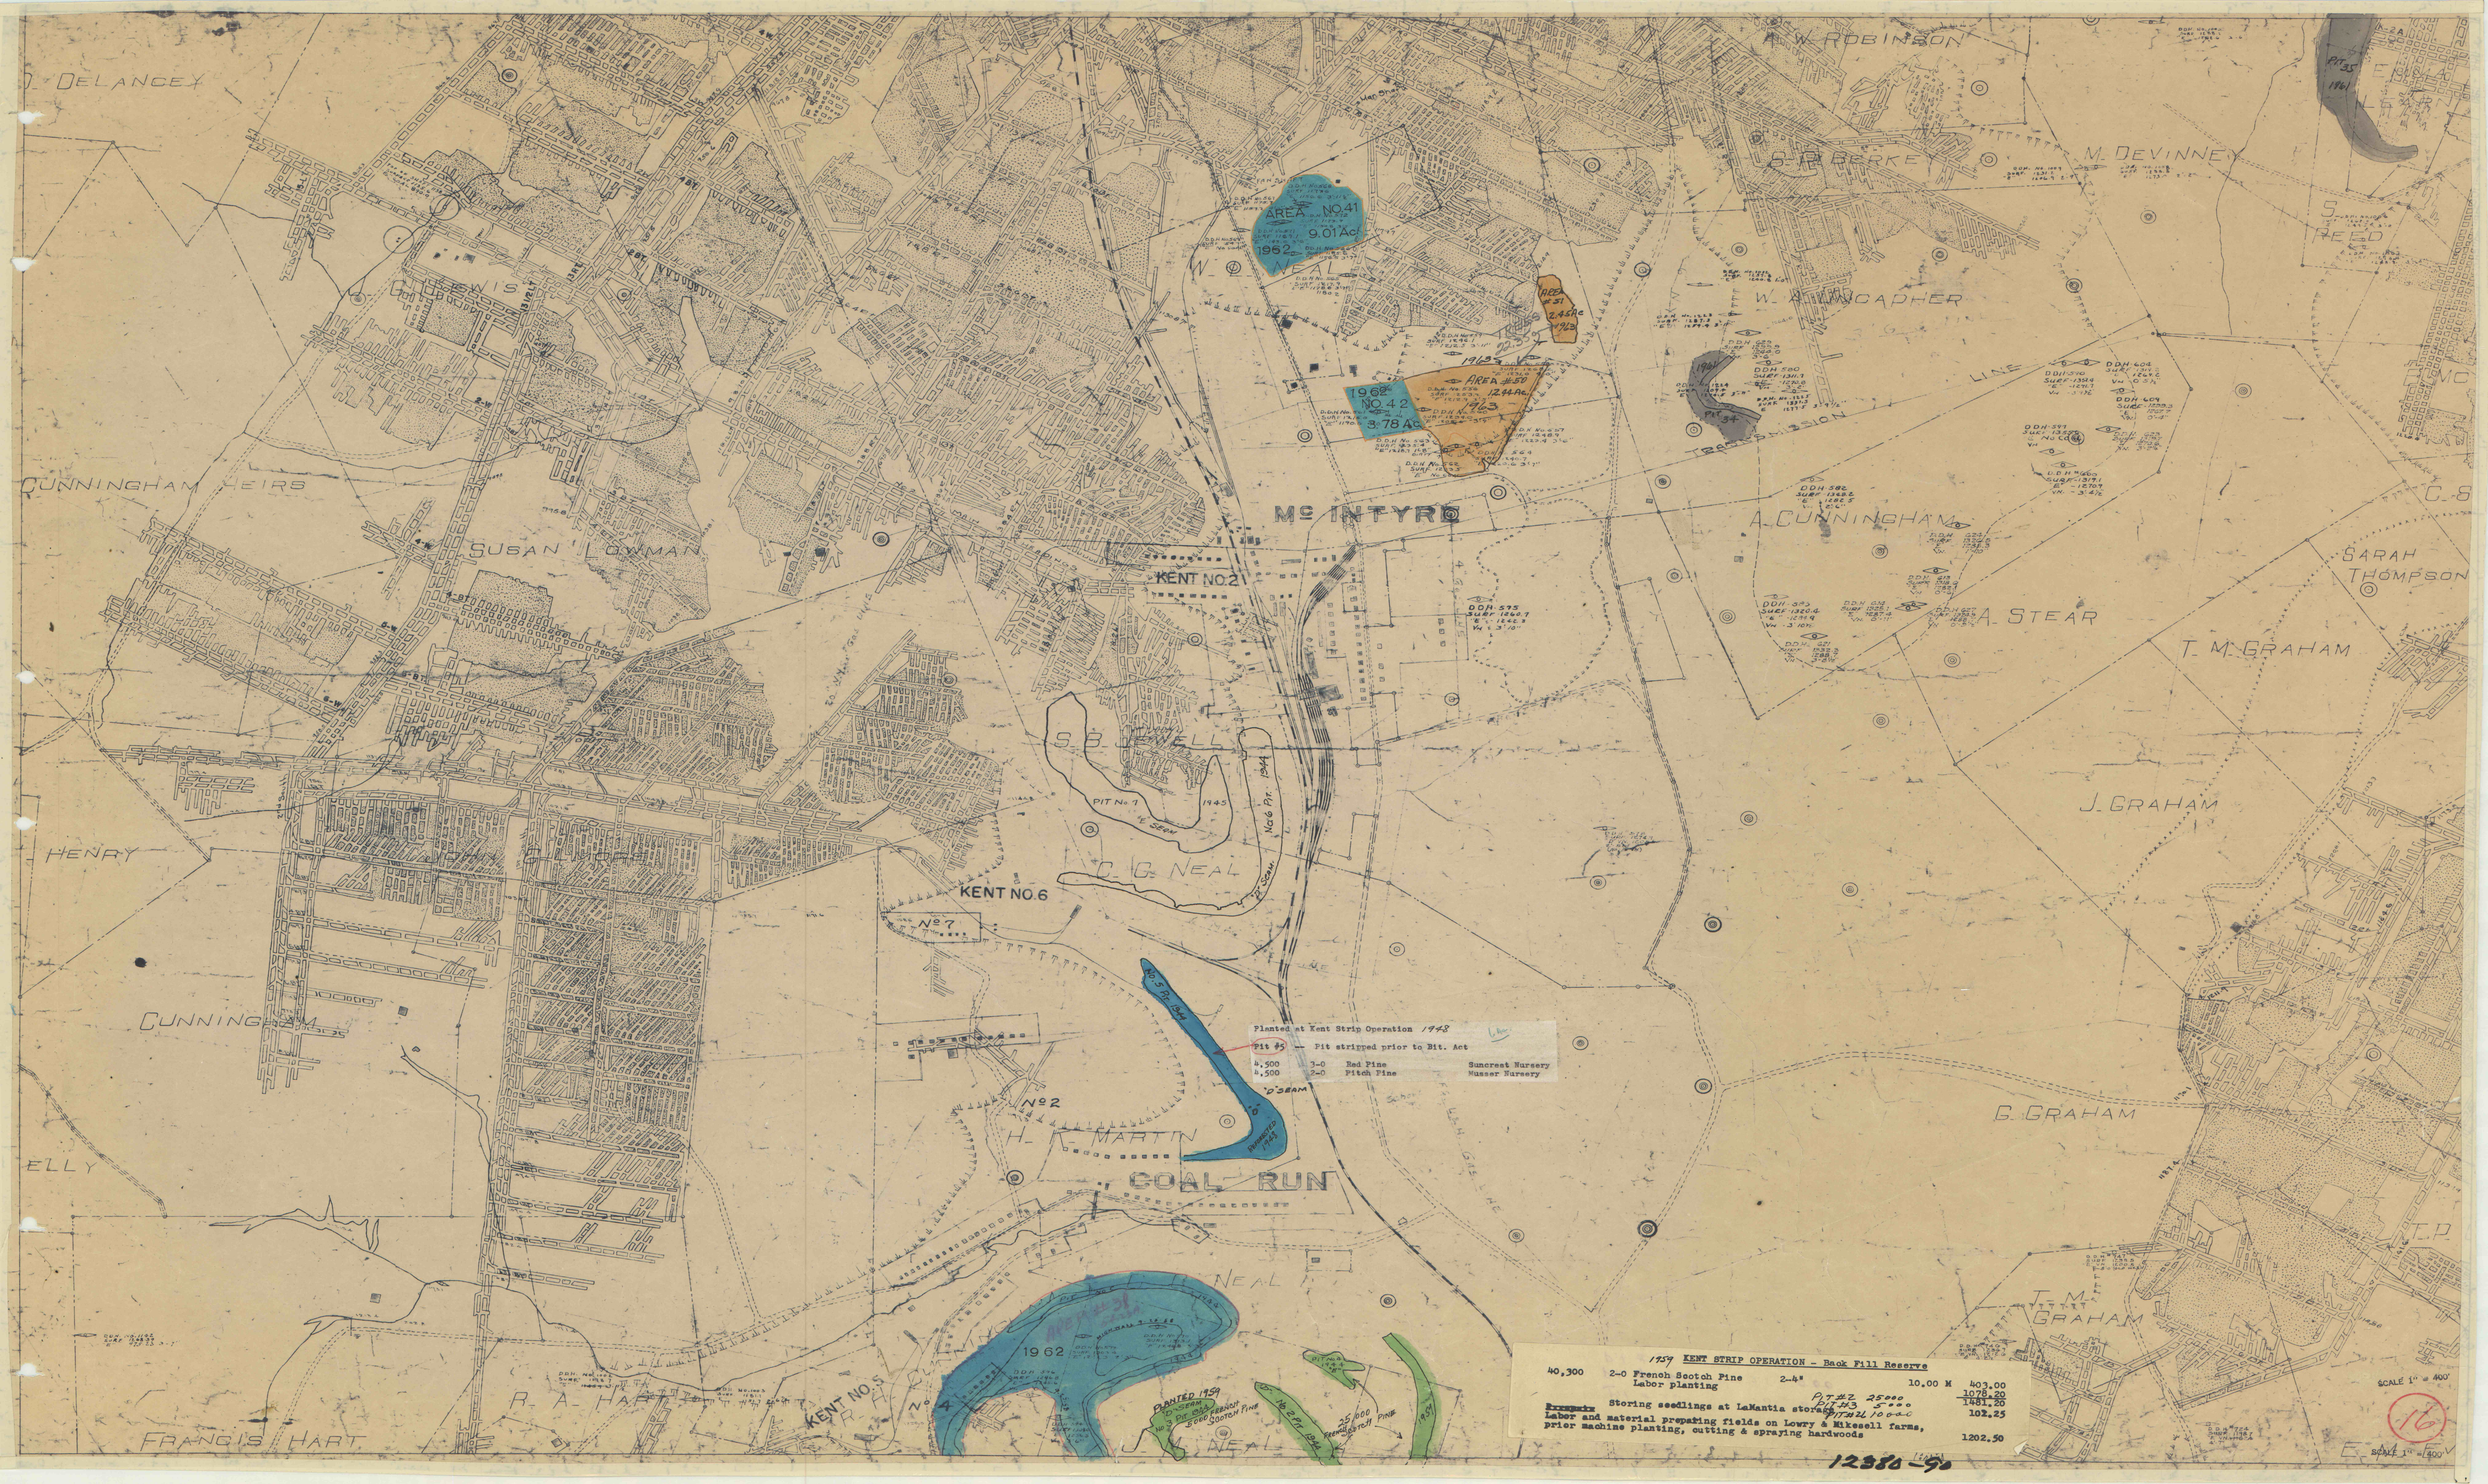

Planted at Kent Strip Operation 1948
Pit #5 - Pit stripped prior to Bit. Act
4,500 3-0 Red Pine
4,500 2-0 Pitch Pine
Suncrast Nursery
Wassner Nursery

1959 KENT STRIP OPERATION - Back Fill Reserve				
40,300	2-0 French Scotch Pine	2-4"	10.00 M	403.00
	Labor planting			1078.20
	Storing seedlings at LaMantia storage			1481.20
	Labor and material preparing fields on Lowry & Mikesell farms, prior machine planting, cutting & spraying hardwoods			1202.50

SCALE 1" = 400'
16
SCALE 1" = 400'