


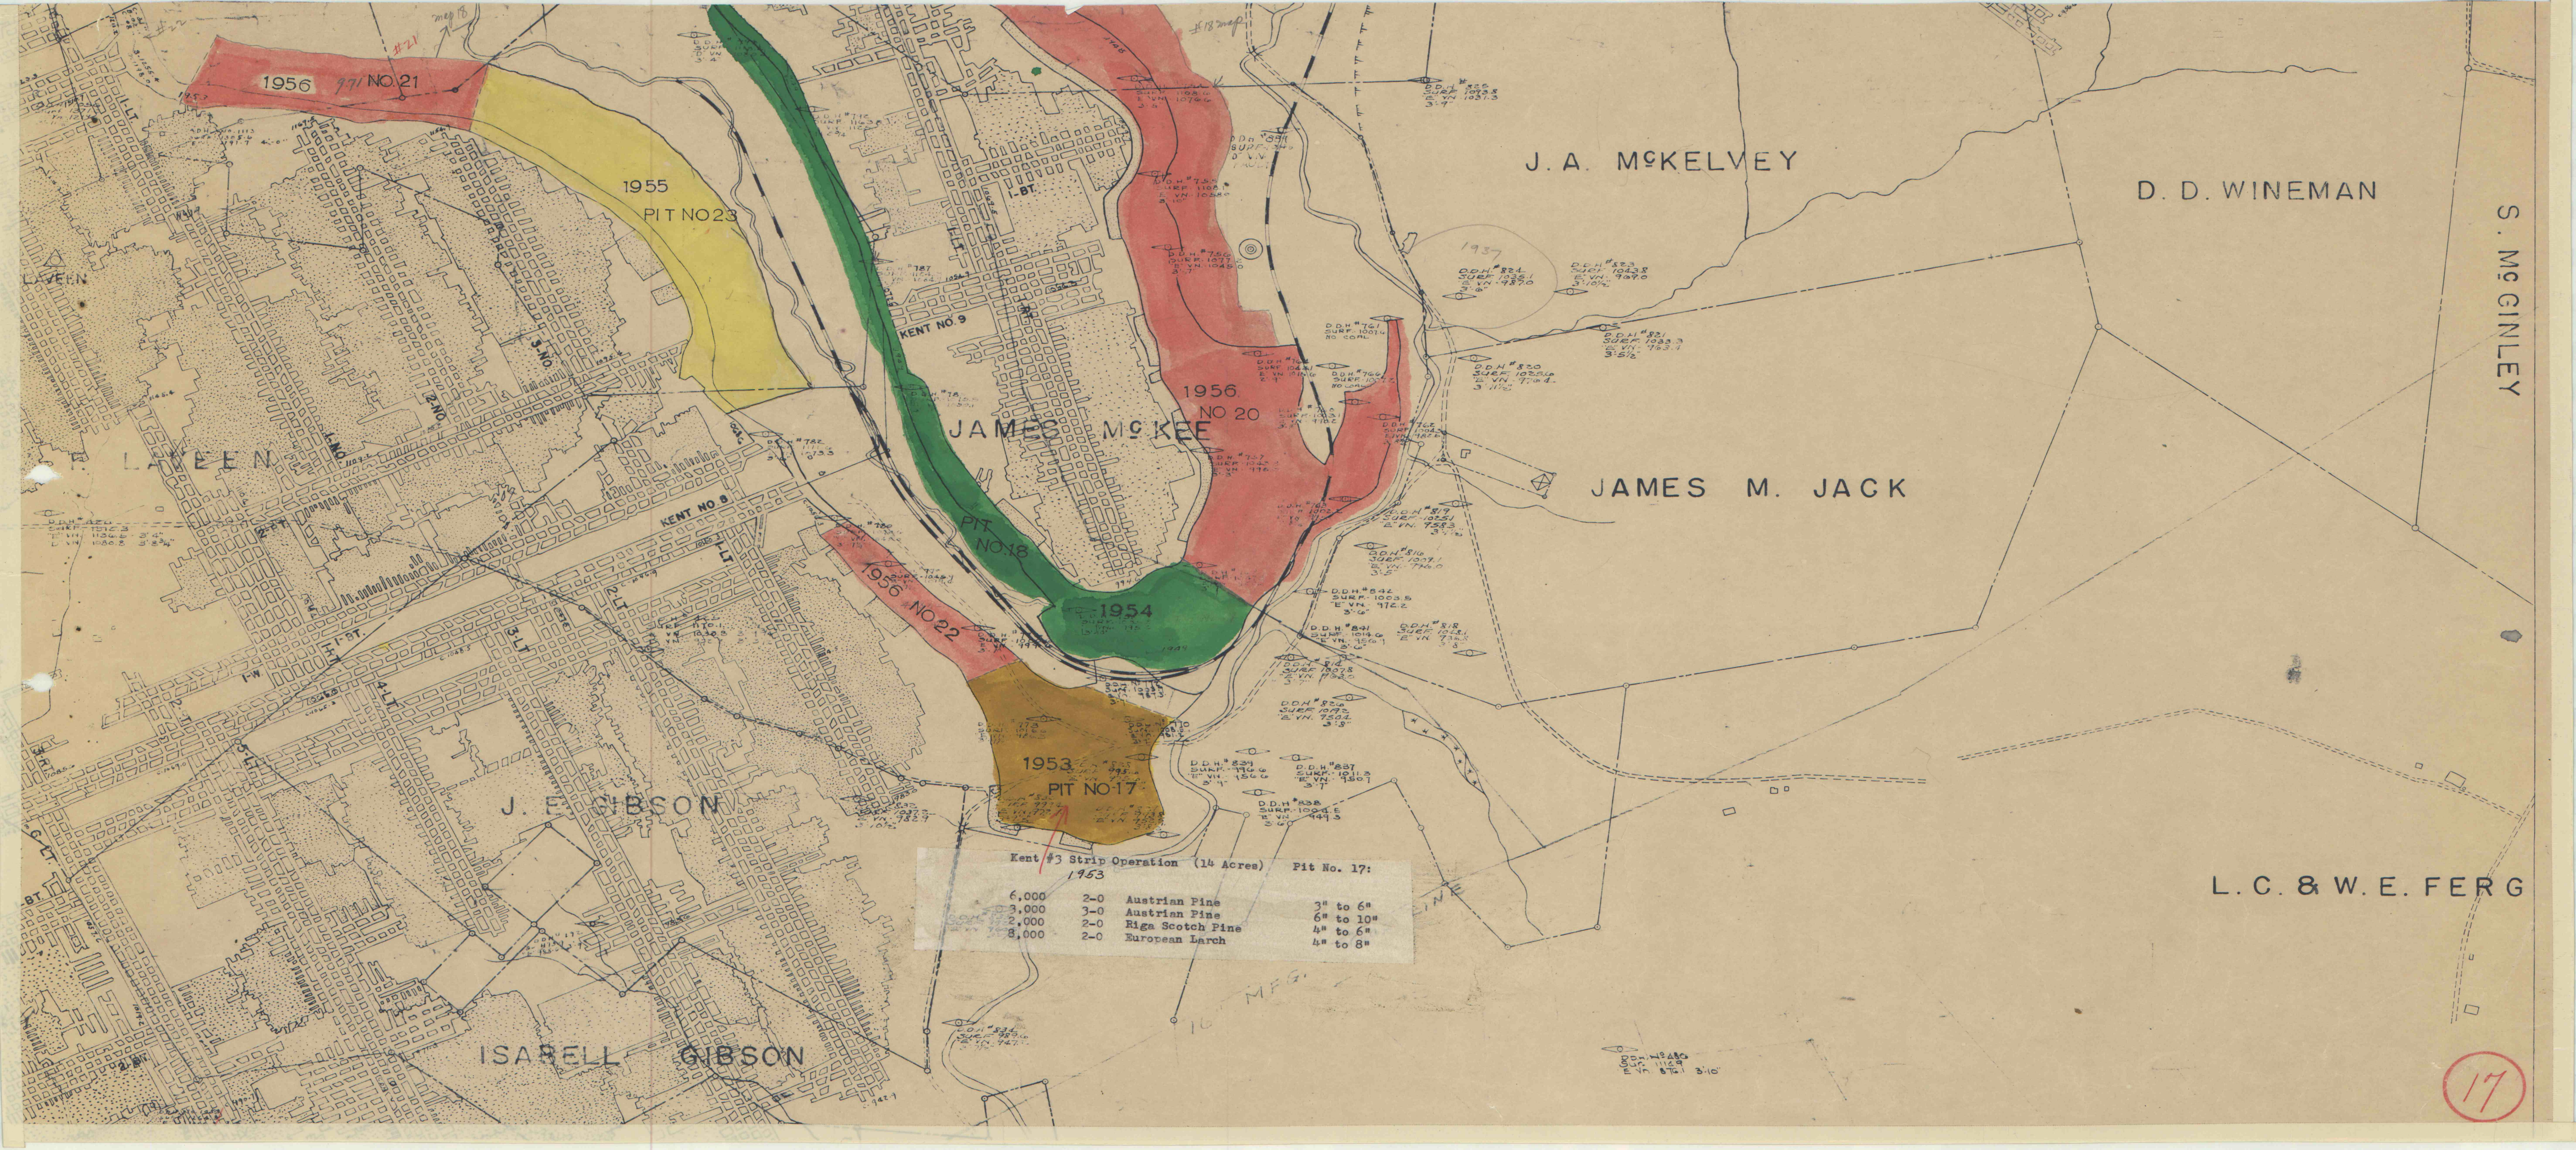

Kent #3 Strip Operation (14 Acres)				Pit No. 17:	
1953					
6,000	2-0	Austrian Pine		3"	to 6"
3,000	3-0	Austrian Pine		6"	to 10"
2,000	2-0	Riga Scotch Pine		4"	to 6"
3,000	2-0	European Larch		4"	to 8"