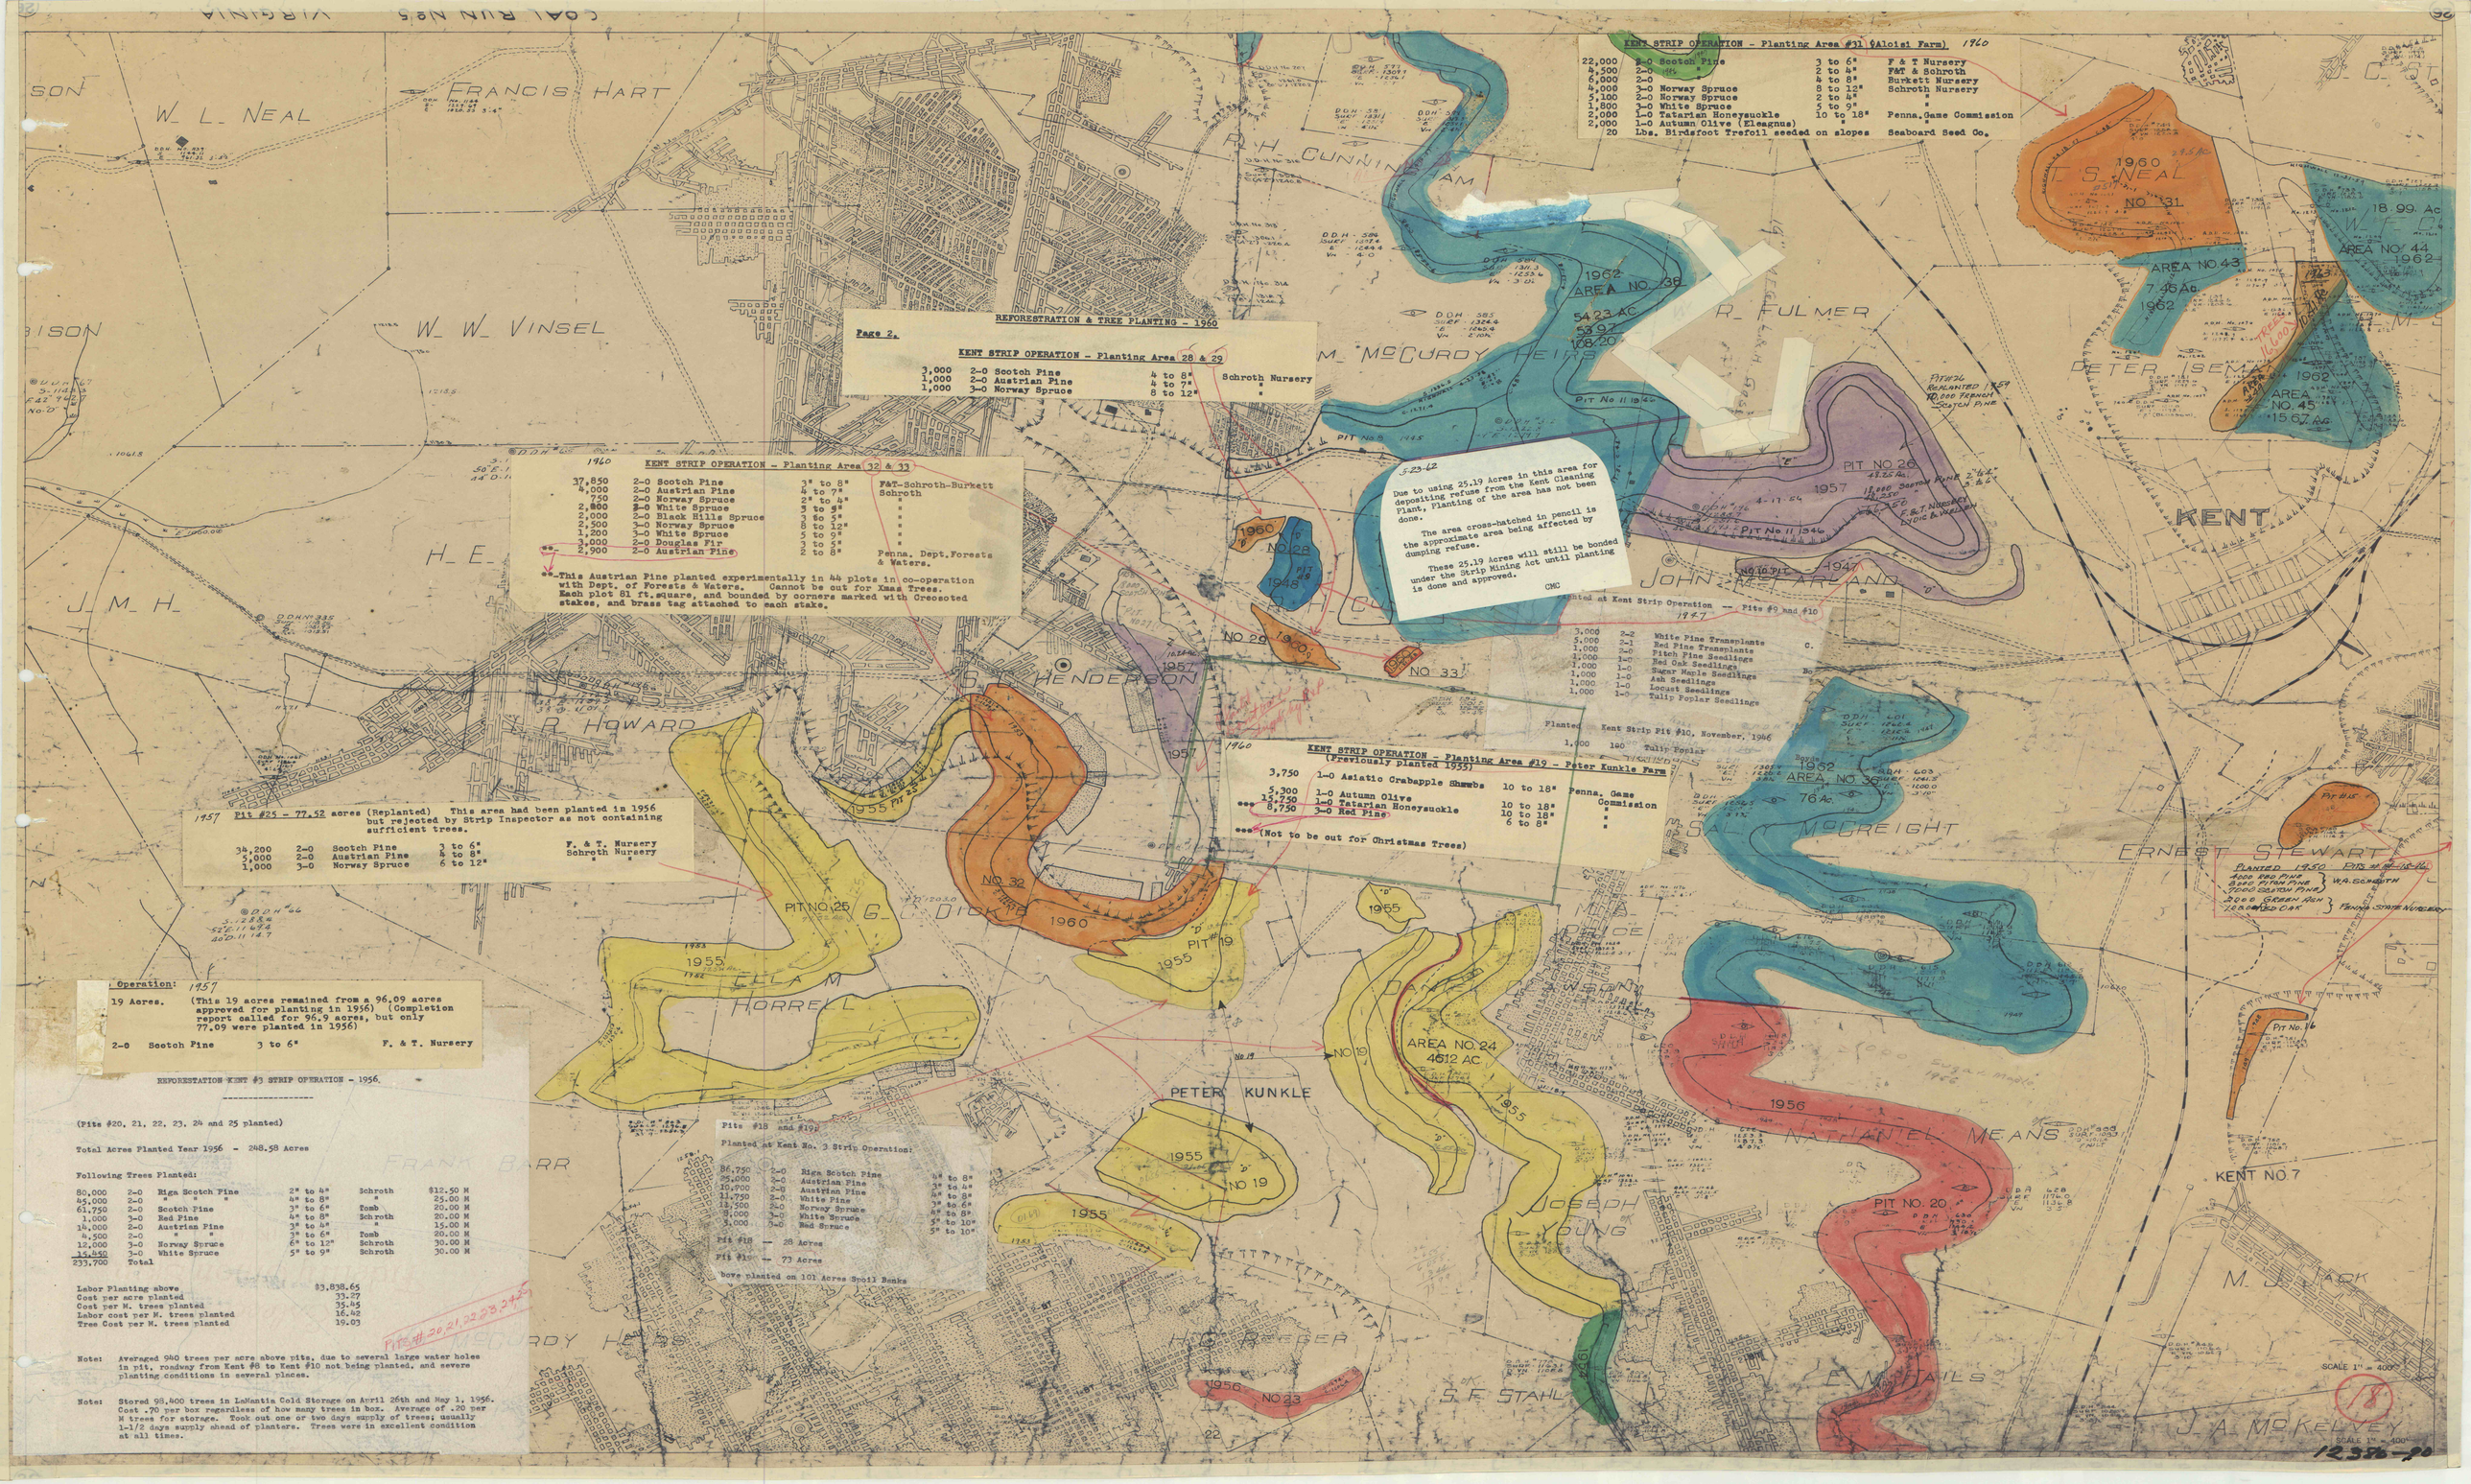

KENT STRIP OPERATION - Planting Area #31 (Aloisi Farm). 1960

22,000	2-0 Scotch Pine	3 to 6"	F & T Nursery
4,500	2-0 " "	2 to 4"	F&T & Schroth
6,000	2-0 " "	4 to 8"	Burkett Nursery
4,000	3-0 Norway Spruce	8 to 12"	Schroth Nursery
5,100	2-0 Norway Spruce	2 to 4"	"
1,800	3-0 White Spruce	5 to 9"	"
2,000	1-0 Tatarian Honeysuckle	10 to 18"	Penna. Game Commission
2,000	1-0 Autumn Olive (Eleagnus)	"	"
20	Lbs. Birdsfoot Trefoil seeded on slopes		Seaboard Seed Co.

REFORESTATION & TREE PLANTING - 1960

Page 2.

KENT STRIP OPERATION - Planting Area 28 & 29

3,000	2-0 Scotch Pine	4 to 8"	Schroth Nursery
1,000	2-0 Austrian Pine	4 to 7"	"
1,000	3-0 Norway Spruce	8 to 12"	"

KENT STRIP OPERATION - Planting Areas 32 & 33

37,850	2-0 Scotch Pine	3" to 8"	F&T-Schroth-Burkett
4,000	2-0 Austrian Pine	4 to 7"	Schroth
750	2-0 Norway Spruce	2" to 4"	"
2,800	2-0 White Spruce	3 to 9"	"
2,000	2-0 Black Hills Spruce	3 to 5"	"
2,500	3-0 Norway Spruce	8 to 12"	"
1,200	3-0 White Spruce	5 to 9"	"
3,000	2-0 Douglas Fir	3 to 5"	"
2,900	2-0 Austrian Pine	2 to 8"	Penna. Dept. Forests & Waters.

**-This Austrian Pine planted experimentally in 44 plots in co-operation with Dept. of Forests & Waters. Cannot be cut for Xmas Trees. Each plot 81 ft. square, and bounded by corners marked with Creosoted stakes, and brass tag attached to each stake.

5-23-62

Due to using 25.19 Acres in this area for depositing refuse from the Kent Cleaning Plant, Planting of the area has not been done.

The area cross-hatched in pencil is the approximate area being affected by dumping refuse.

These 25.19 Acres will still be bonded under the Strip Mining Act until planting is done and approved.

CMC

Planted at Kent Strip Operation -- Pits #9 and #10

3,000	2-2	White Pine Transplants	
5,000	2-1	Red Pine Transplants	C.
1,000	2-0	Pitch Pine Seedlings	
1,000	1-0	Red Oak Seedlings	
1,000	1-0	Sugar Maple Seedlings	Bo
1,000	1-0	Ash Seedlings	
1,000	1-0	Locust Seedlings	
1,000	1-0	Tulip Poplar Seedlings	

Planted Kent Strip Pit #10, November, 1946

1,000	1-0	Tulip Poplar

KENT STRIP OPERATION - Planting Area #19 - Peter Kunkle Farm (Previously planted 1955)

3,750	1-0 Asiatic Crabapple Shrubs	10 to 18"	Penna. Game Commission
5,300	1-0 Autumn Olive	"	"
15,750	1-0 Tatarian Honeysuckle	10 to 18"	"
8,750	3-0 Red Pine	10 to 18"	"
		6 to 8"	"

***(Not to be cut for Christmas Trees)

1957 Pit #25 - 77.52 acres (Replanted) This area had been planted in 1956 but rejected by Strip Inspector as not containing sufficient trees.

34,200	2-0	Scotch Pine	3 to 6"	F. & T. Nursery
5,000	2-0	Austrian Pine	4 to 8"	Schroth Nursery
1,000	3-0	Norway Spruce	6 to 12"	"

Operation: 1957

19 Acres. (This 19 acres remained from a 96.09 acres approved for planting in 1956) (Completion report called for 96.9 acres, but only 77.09 were planted in 1956)

2-0	Scotch Pine	3 to 6"	F. & T. Nursery

REFORESTATION KENT #3 STRIP OPERATION - 1956.

(Pits #20, 21, 22, 23, 24 and 25 planted)

Total Acres Planted Year 1956 - 248.58 Acres

Following Trees Planted:

80,000	2-0	Riga Scotch Pine	2" to 4"	Schroth	$12.50 M
45,000	2-0	" " "	4" to 8"	"	25.00 M
61,750	2-0	Scotch Pine	3" to 6"	Tomb	20.00 M
1,000	3-0	Red Pine	4" to 8"	Schroth	20.00 M
14,000	2-0	Austrian Pine	3" to 6"	"	15.00 M
4,500	2-0	" "	3" to 6"	Tomb	20.00 M
12,000	3-0	Norway Spruce	6" to 12"	Schroth	30.00 M
15,450	3-0	White Spruce	5" to 9"	Schroth	30.00 M
233,700	Total				

Labor Planting above	$3,838.65
Cost per acre planted	33.27
Cost per M. trees planted	35.45
Labor cost per M. trees planted	16.42
Tree Cost per M. trees planted	19.03

Pits #20, 21, 22, 23, 24, 25

Note: Averaged 980 trees per acre above pits, due to several large water holes in pit, roadway from Kent #8 to Kent #10 not being planted, and severe planting conditions in several places.

Note: Stored 98,400 trees in LaMantia Cold Storage on April 26th and May 1, 1956. Cost .70 per box regardless of how many trees in box. Average of .20 per M trees for storage. Took out one or two days supply of trees; usually 1-1/2 days supply ahead of planters. Trees were in excellent condition at all times.

Pits #18 and #19:

Planted at Kent No. 3 Strip Operation:

86,750	2-0	Riga Scotch Pine	4" to 8"
35,000	2-0	Austrian Pine	3" to 4"
10,900	2-0	Austrian Pine	4" to 8"
11,750	2-0	White Pine	3" to 6"
13,500	2-0	Norway Spruce	3" to 6"
3,000	3-0	White Spruce	8" to 8"
3,000	3-0	Red Spruce	5" to 10"
			5" to 10"

Pit #18 -- 28 Acres

Pit #19 -- 73 Acres

Above planted on 101 Acres Spoil Banks

18

12,356.00