


06-8609

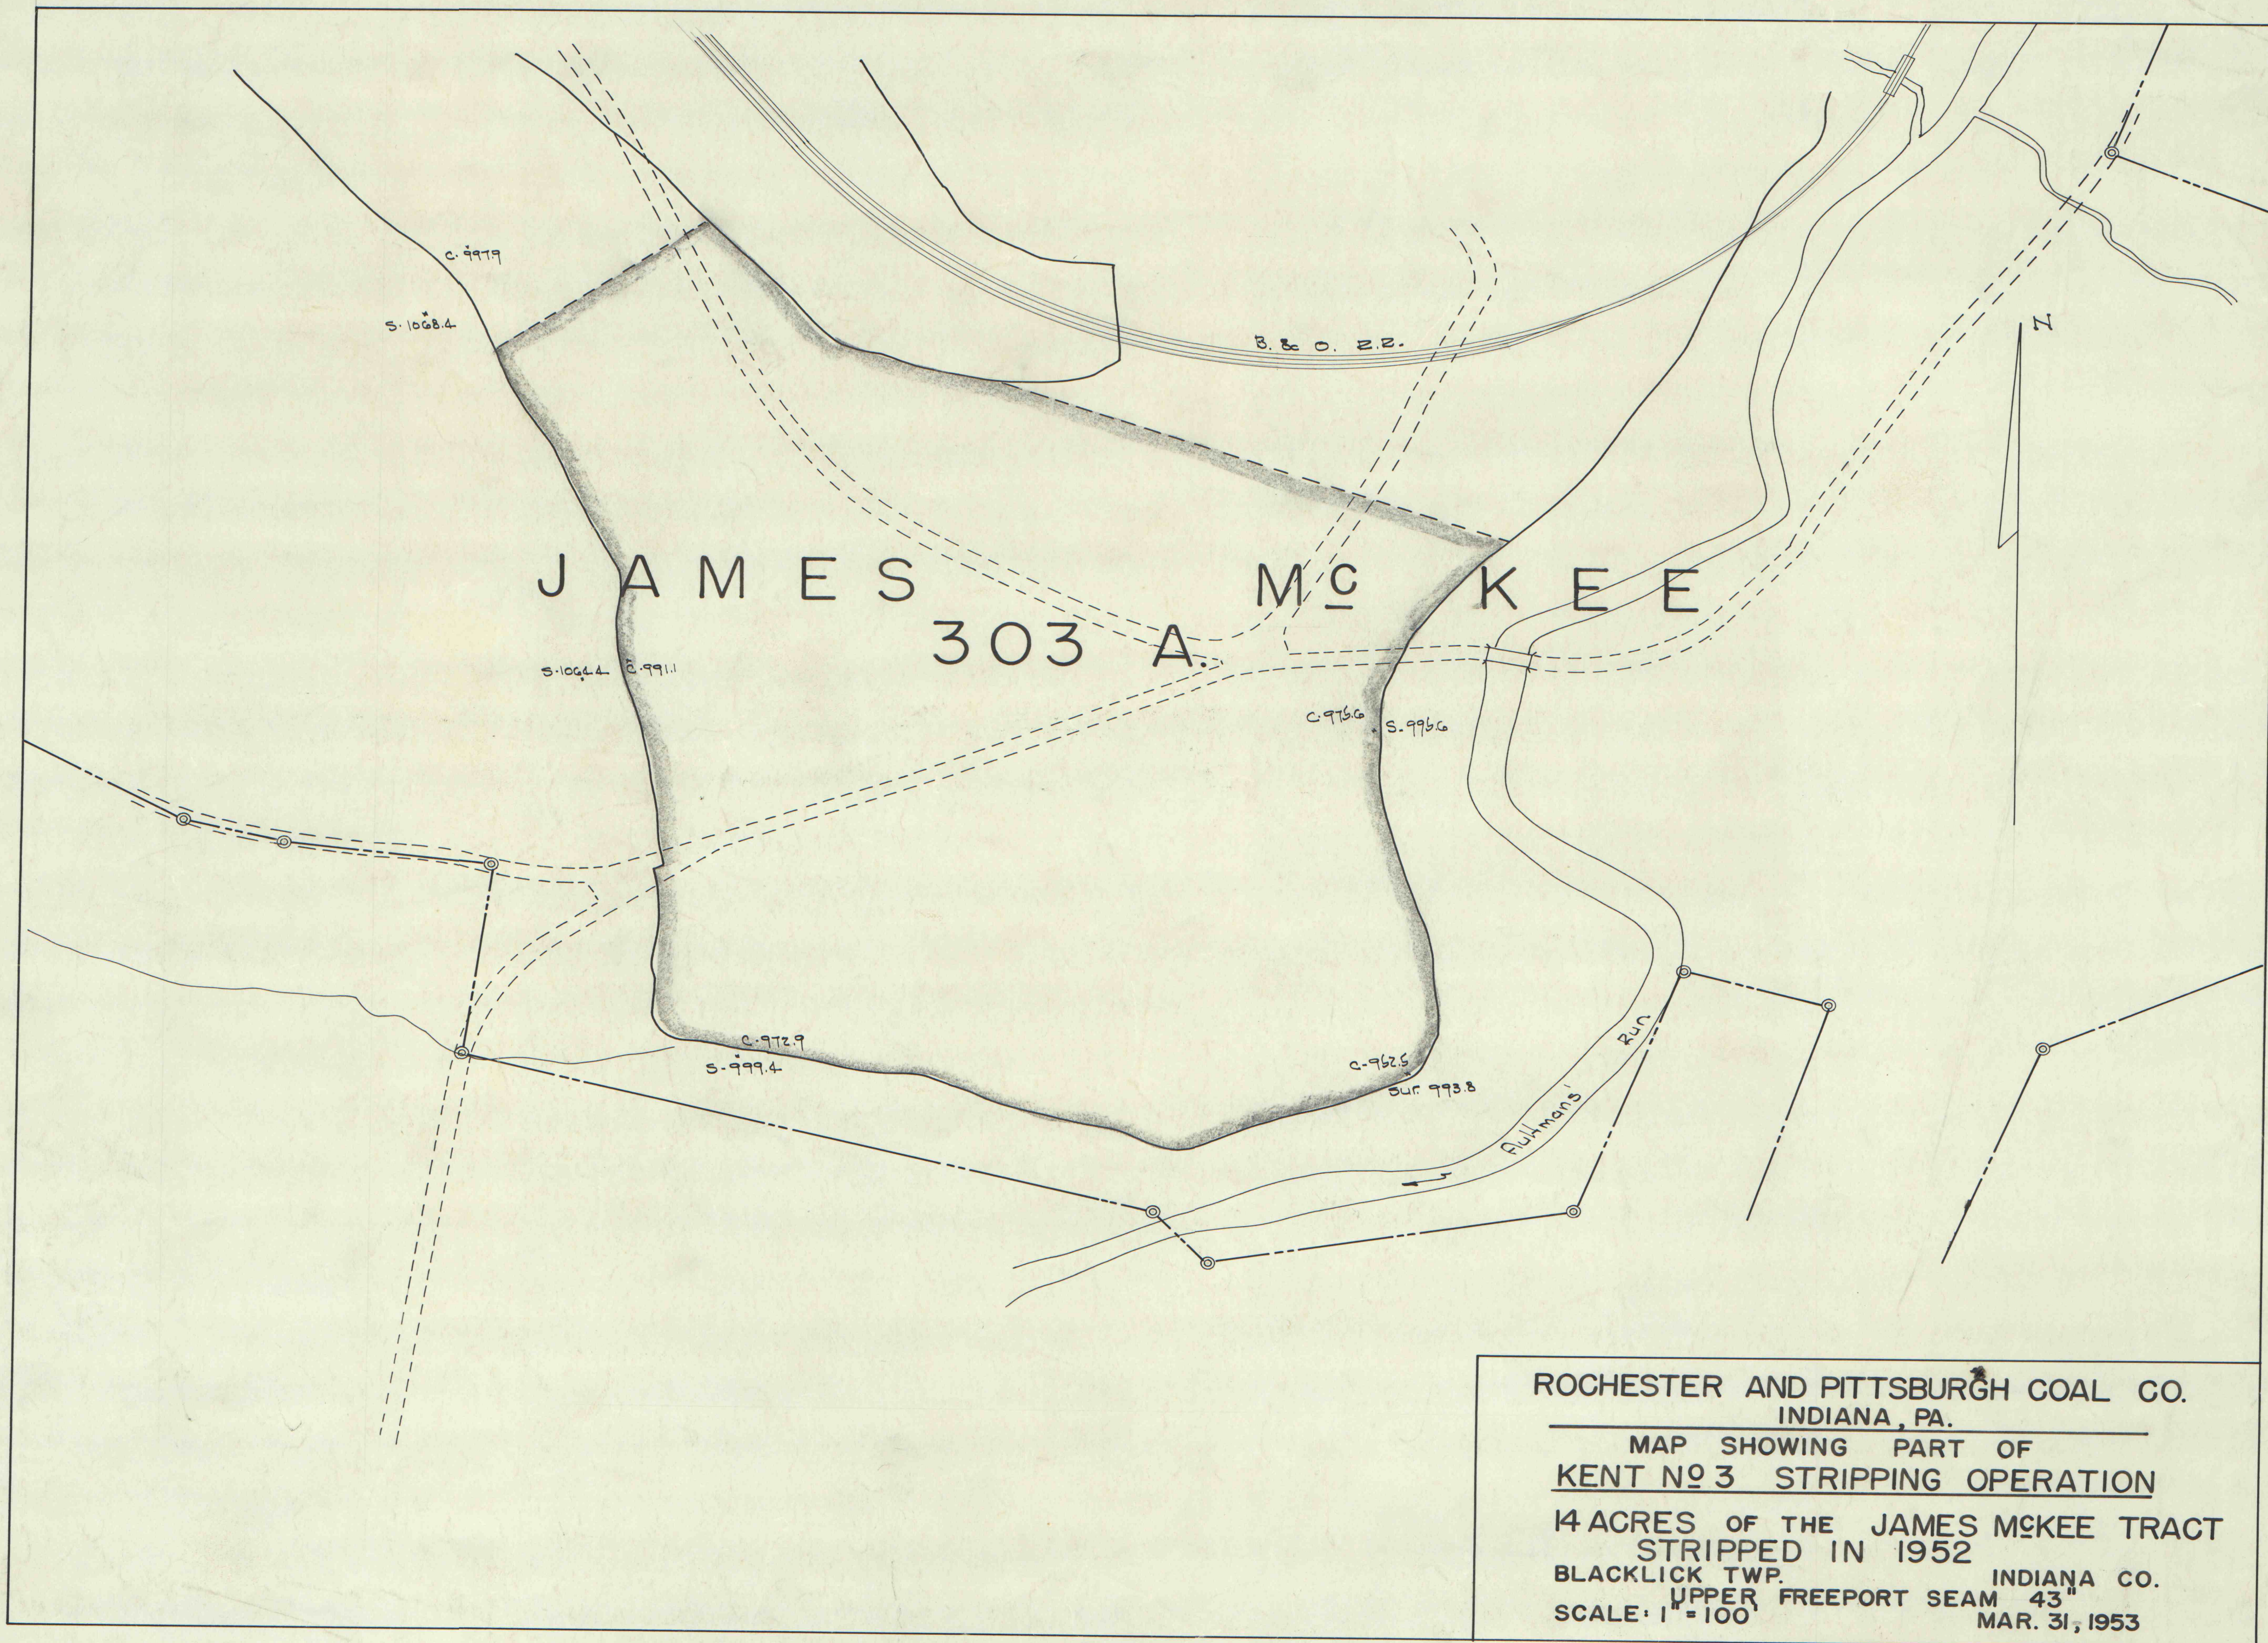

6098-90